


BARTHURER
DITCH.

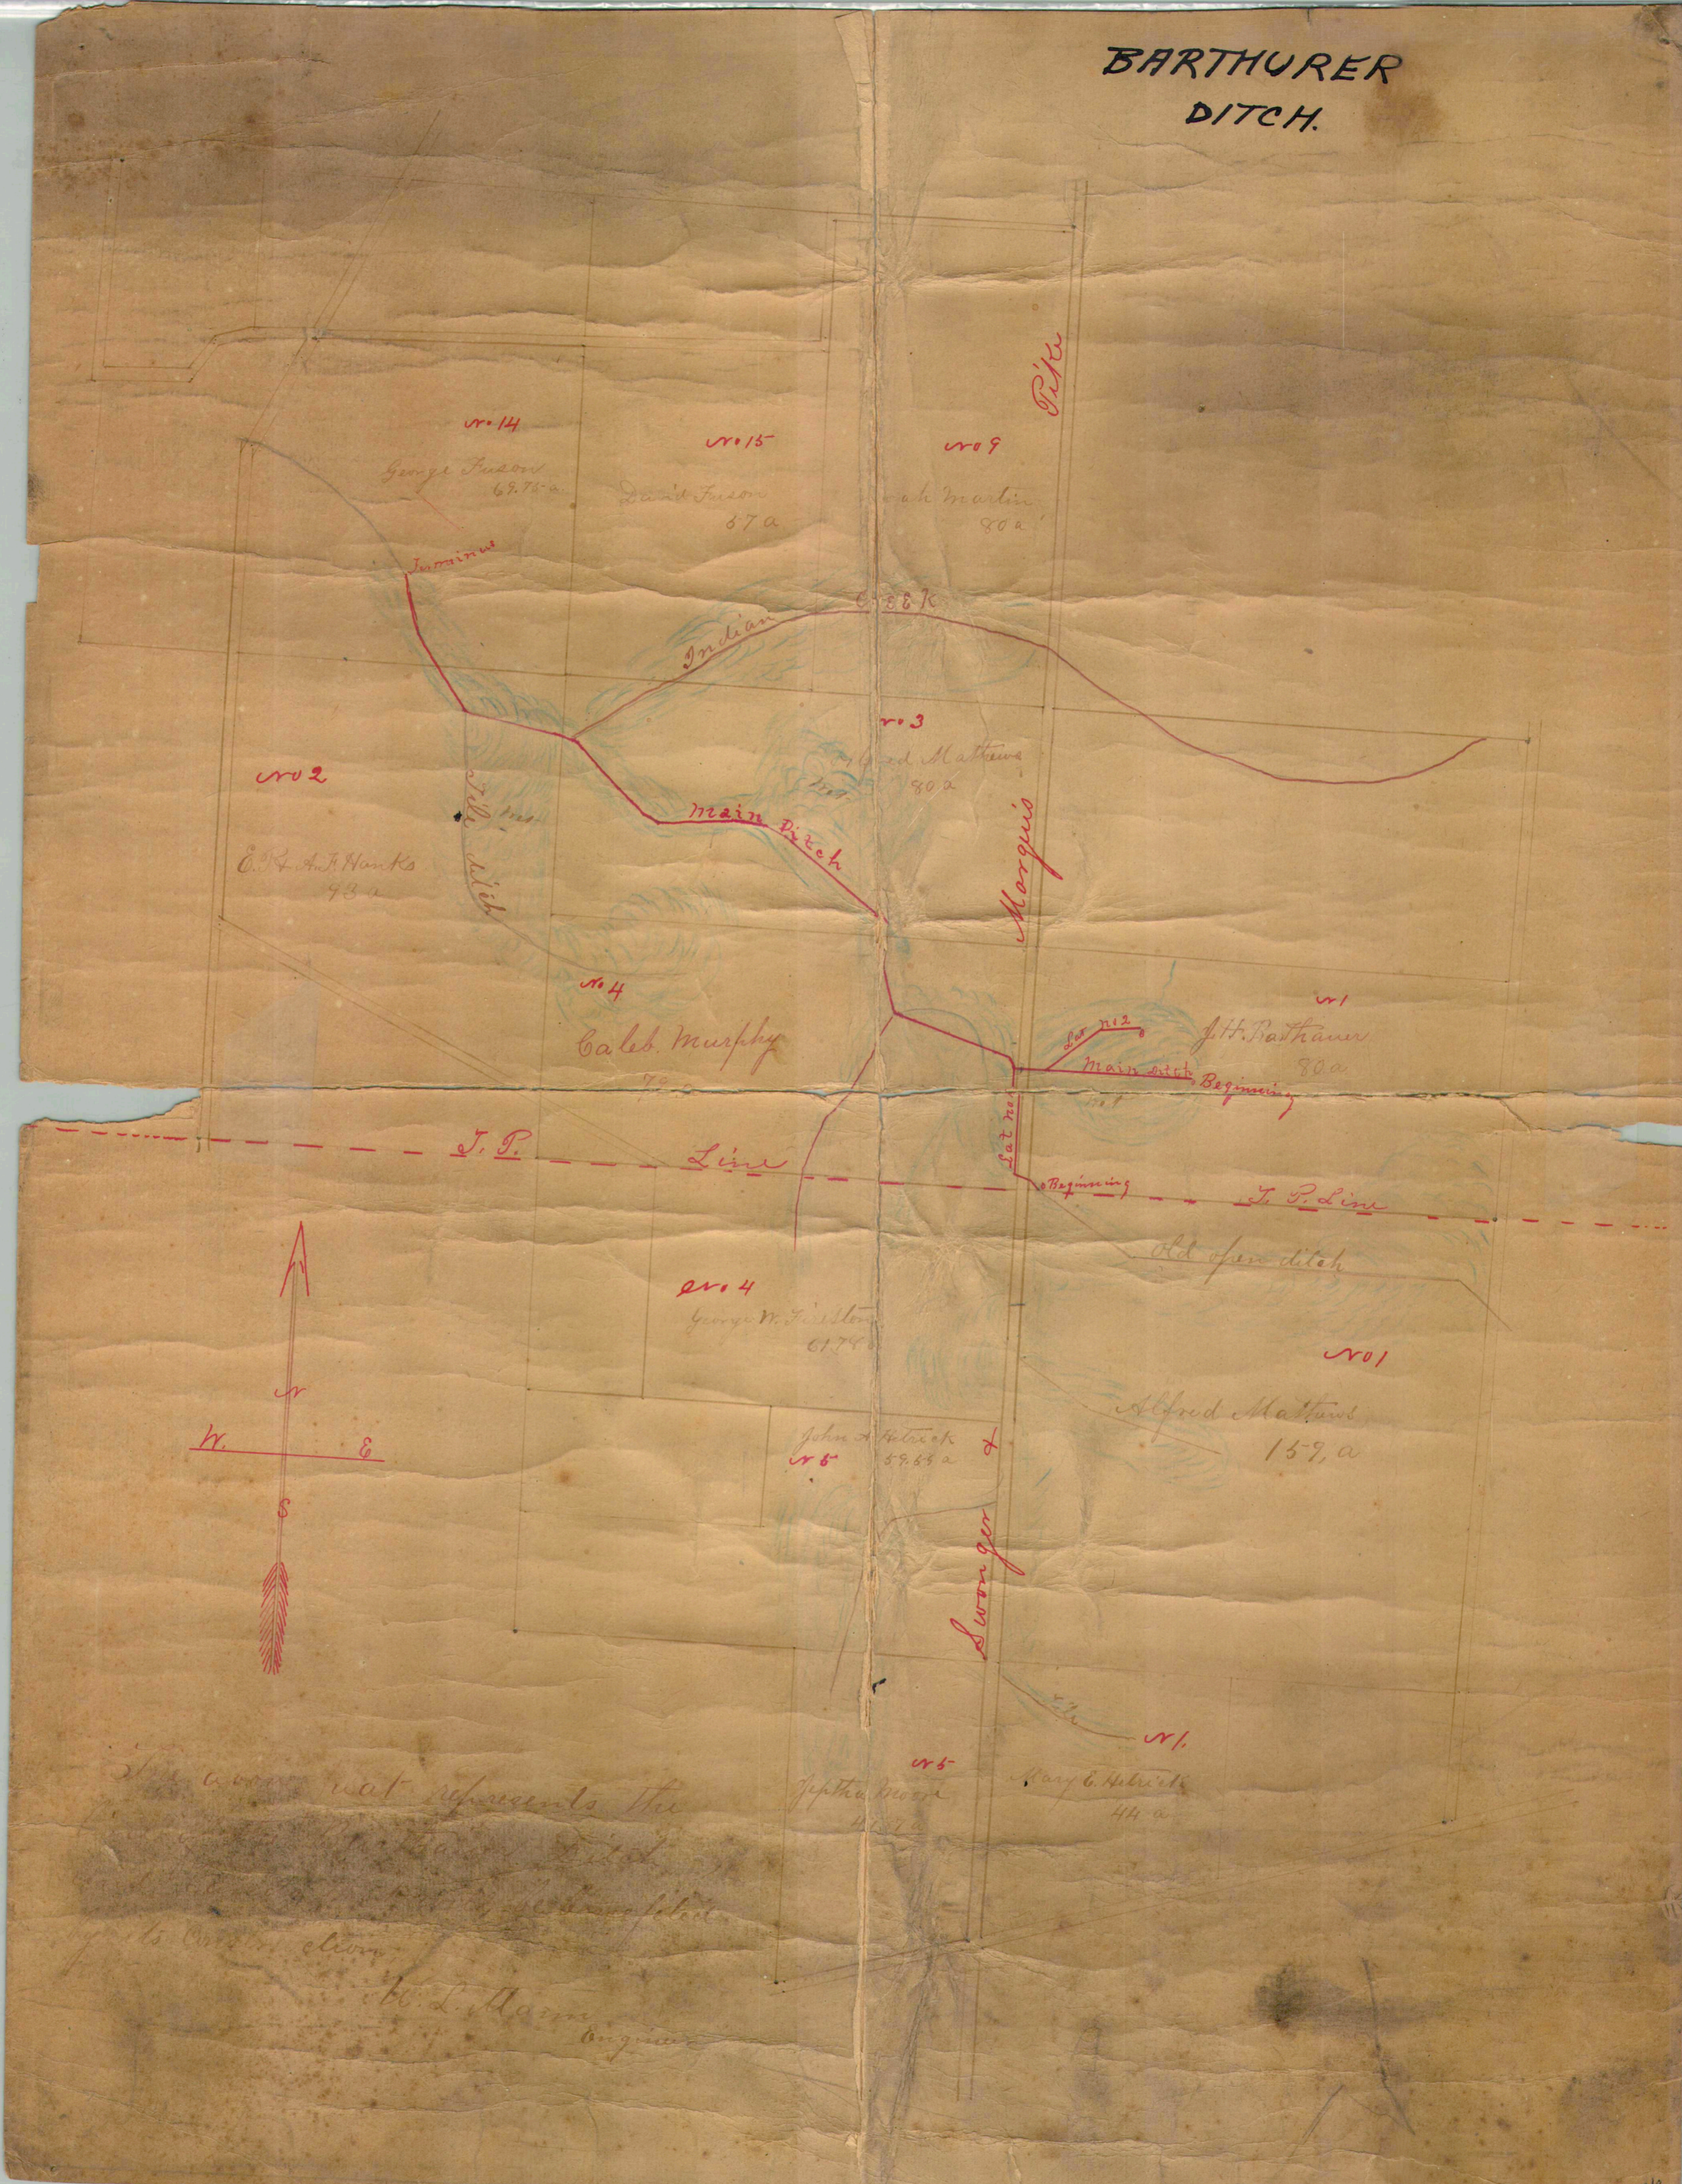

The above map represents the
Barthurer Ditch
as constructed
W. L. Mann
August