
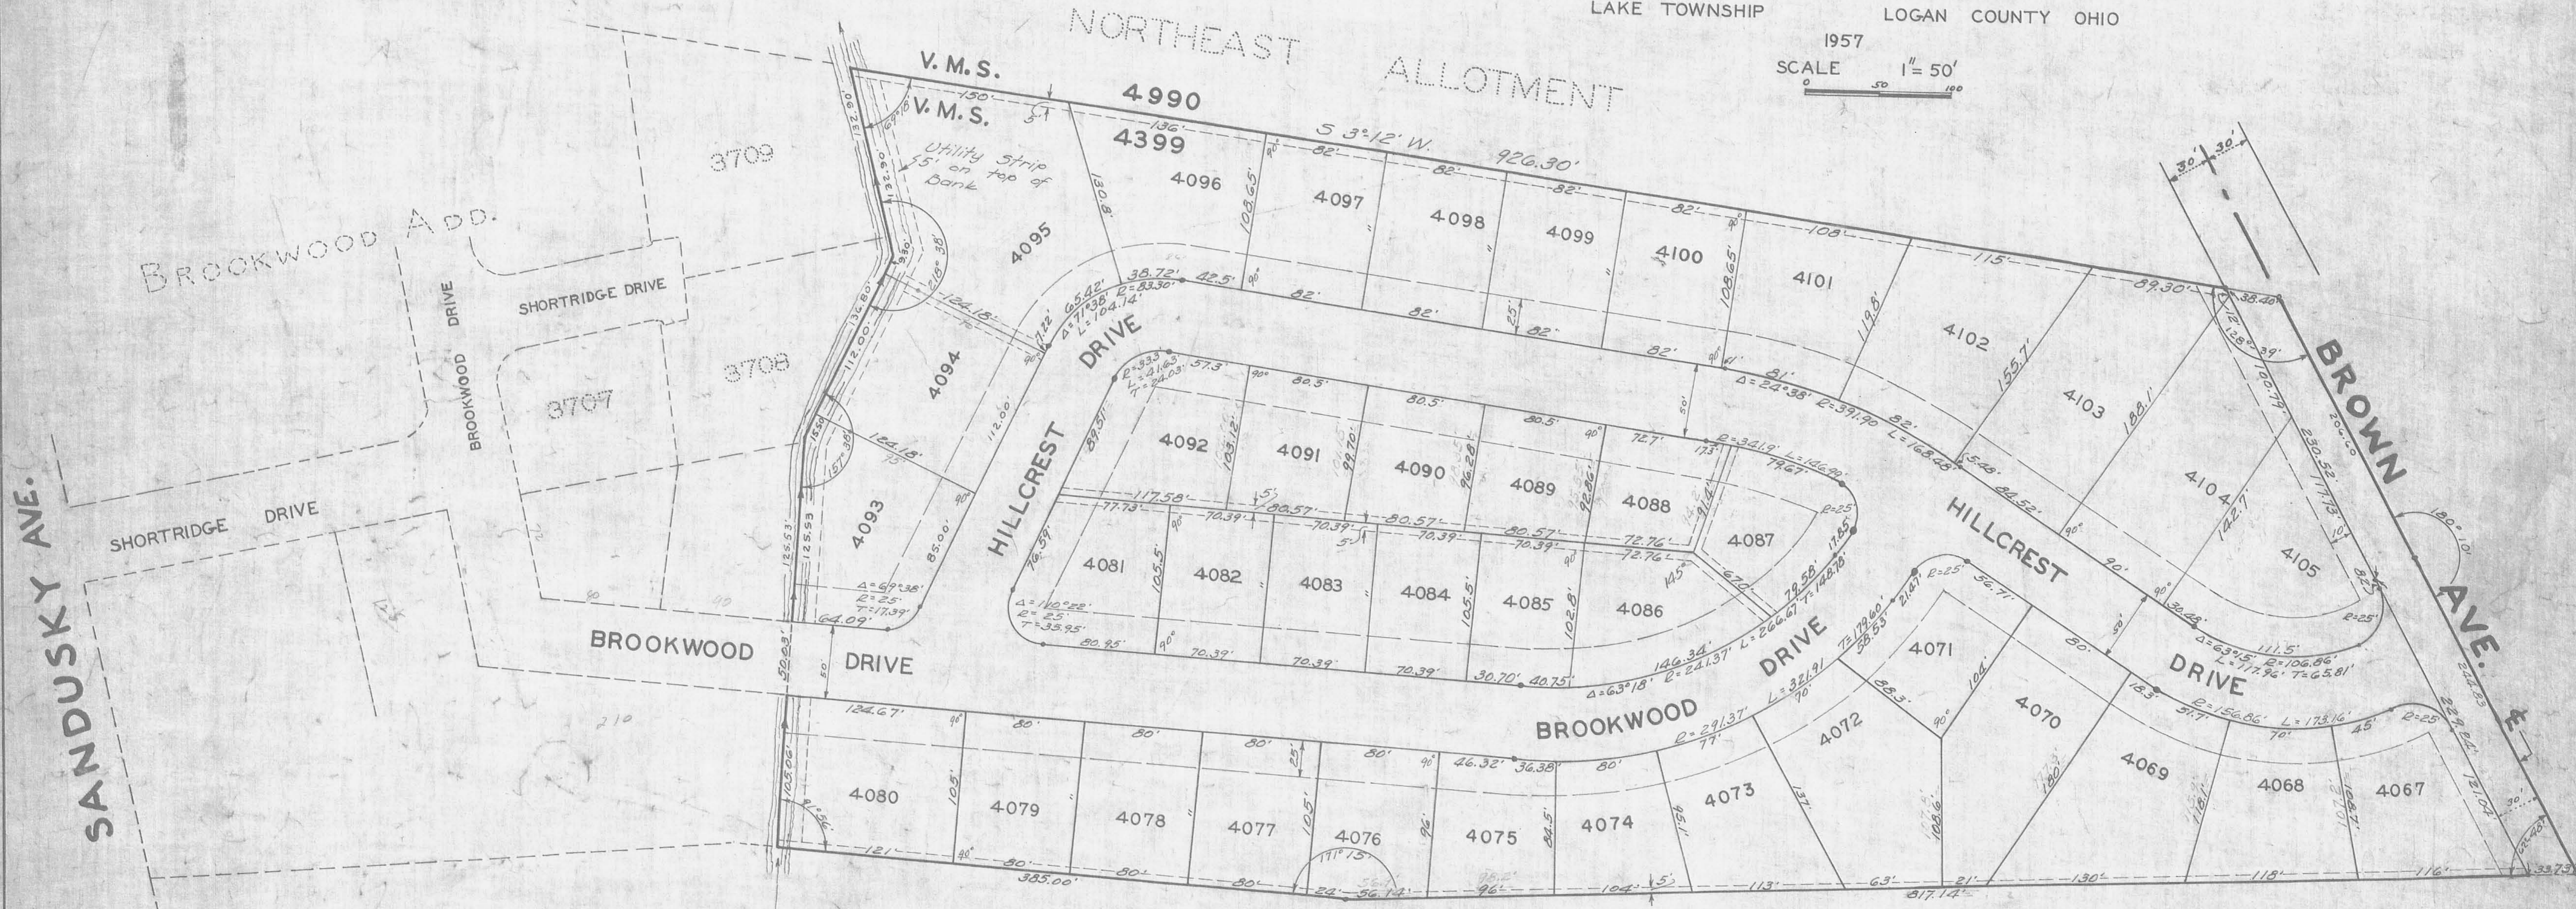


BROOKWOOD ADDITION NO. 2
TO
BELLEFONTAINE OHIO

V.M.S. 4399
LAKE TOWNSHIP LOGAN COUNTY OHIO

1957
SCALE 1" = 50'

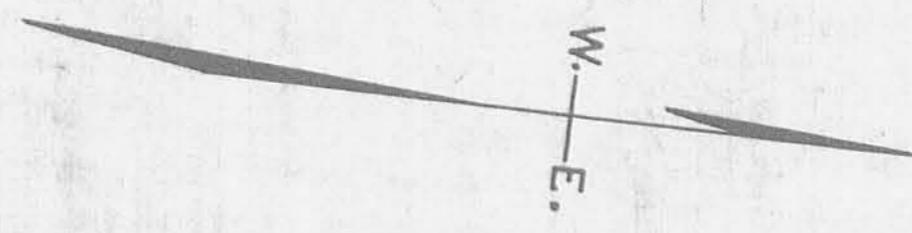

LEGEND:

- Lot Lines
- Building Set-back
- Utility Easement
- Iron Pin

SURVEYOR'S CERTIFICATE

The accompanying Plat represents a Subdivision of land in V.M.S. 4399, City of Bellefontaine, Logan County, Ohio
I hereby certify that the accompanying plat is a correct representation of BROOKWOOD ADD. NO. 2
Total acres in Allotment with streets 11.69 Acres

James E. Lee
Civil Engineer
Reg. Surveyor No. 1302

Lot shapes & dimensions revised on March 31, 1957.
Paul E. Mangum
Registered Surveyor #3151

**STATE OF OHIO
COUNTY OF LOGAN**

BE IT REMEMBERED THAT, on the 23rd day of ~~December~~ in the year of 1957, appeared before me, A NOTARY PUBLIC, in and for said County, J.W. Brubaker & John A. Patterson, granters in this dedication, who acknowledged the signing thereof to be their free and voluntary and deed of their partnership.

Janna S. Wesh
NOTARY PUBLIC
Logan County, Ohio
My Commission Expires January 27, 1960

DEDICATION

KNOW ALL MEN BY THESE PRESENTS, that John A. Patterson & J.W. Brubaker, Proprietors of this platted land, have authorized the laying out of same as indicated and do hereby dedicate the drives to the use of the public.

John A. Patterson
J.W. Brubaker
Mayor
Witness

Norma M. Walford
12.50 acres.

ACCEPTANCE BY CITY:

The above and foregoing Plat of approved, Brookwood Addition No. 2 is hereby accepted and approved, subject to the installation of utilities & pavement in accordance with existing ordinances. This action taken by motion at the regular meeting of Council on April 13, 1959.

J.C. Bruchman, Mayor.
Robert L. Stabler, Pres. of Council.
Paul E. Watkins, Clerk of Council.

Final acceptance & approval by Ordinance No. 2662 dated September 28, 1959.

Paul E. Watkins, Clerk of Council.
Robert L. Stabler, Pres. of Council.

Transferred this 23rd day of November, 1959.
Chas. H. Chamberlain, Jr.
Auditor of Logan County.

Received for record at 2:00 o'clock P.M. on the 23rd day of November, 1959, and recorded in Plat Book 4 Volume D, Page 65.
Norma L. Shaffer
Recorder of Logan County

NOTE: The figures in feet are the changes made in stating out the lots to fit actual dimensions.

This plat is to be filed with Bellefontaine City Eng.