


AUTUMN WOODS CONDOMINIUMS

EXHIBIT "C"


PHASE IV
ADDITIONAL PROPERTIES NO. 6, NO. 10, & NO. 12

SECTION 27 AND 33, TOWN 4, RANGE 14
PART OF LOT 4701 JADO VILLE SUBDIVISION AND
PART OF LOT 4887 JADO VILLE SUBDIVISION II
CITY OF BELLEFONTAINE
LAKE TOWNSHIP, LOGAN COUNTY, OHIO

ASSISTED LIVING CONCEPTS, INC.
PT. LOT 4701 AND PT. LOT 4887
ORIG. 2.458 ACRES
O.R. 289, PG. 979
TRACT I

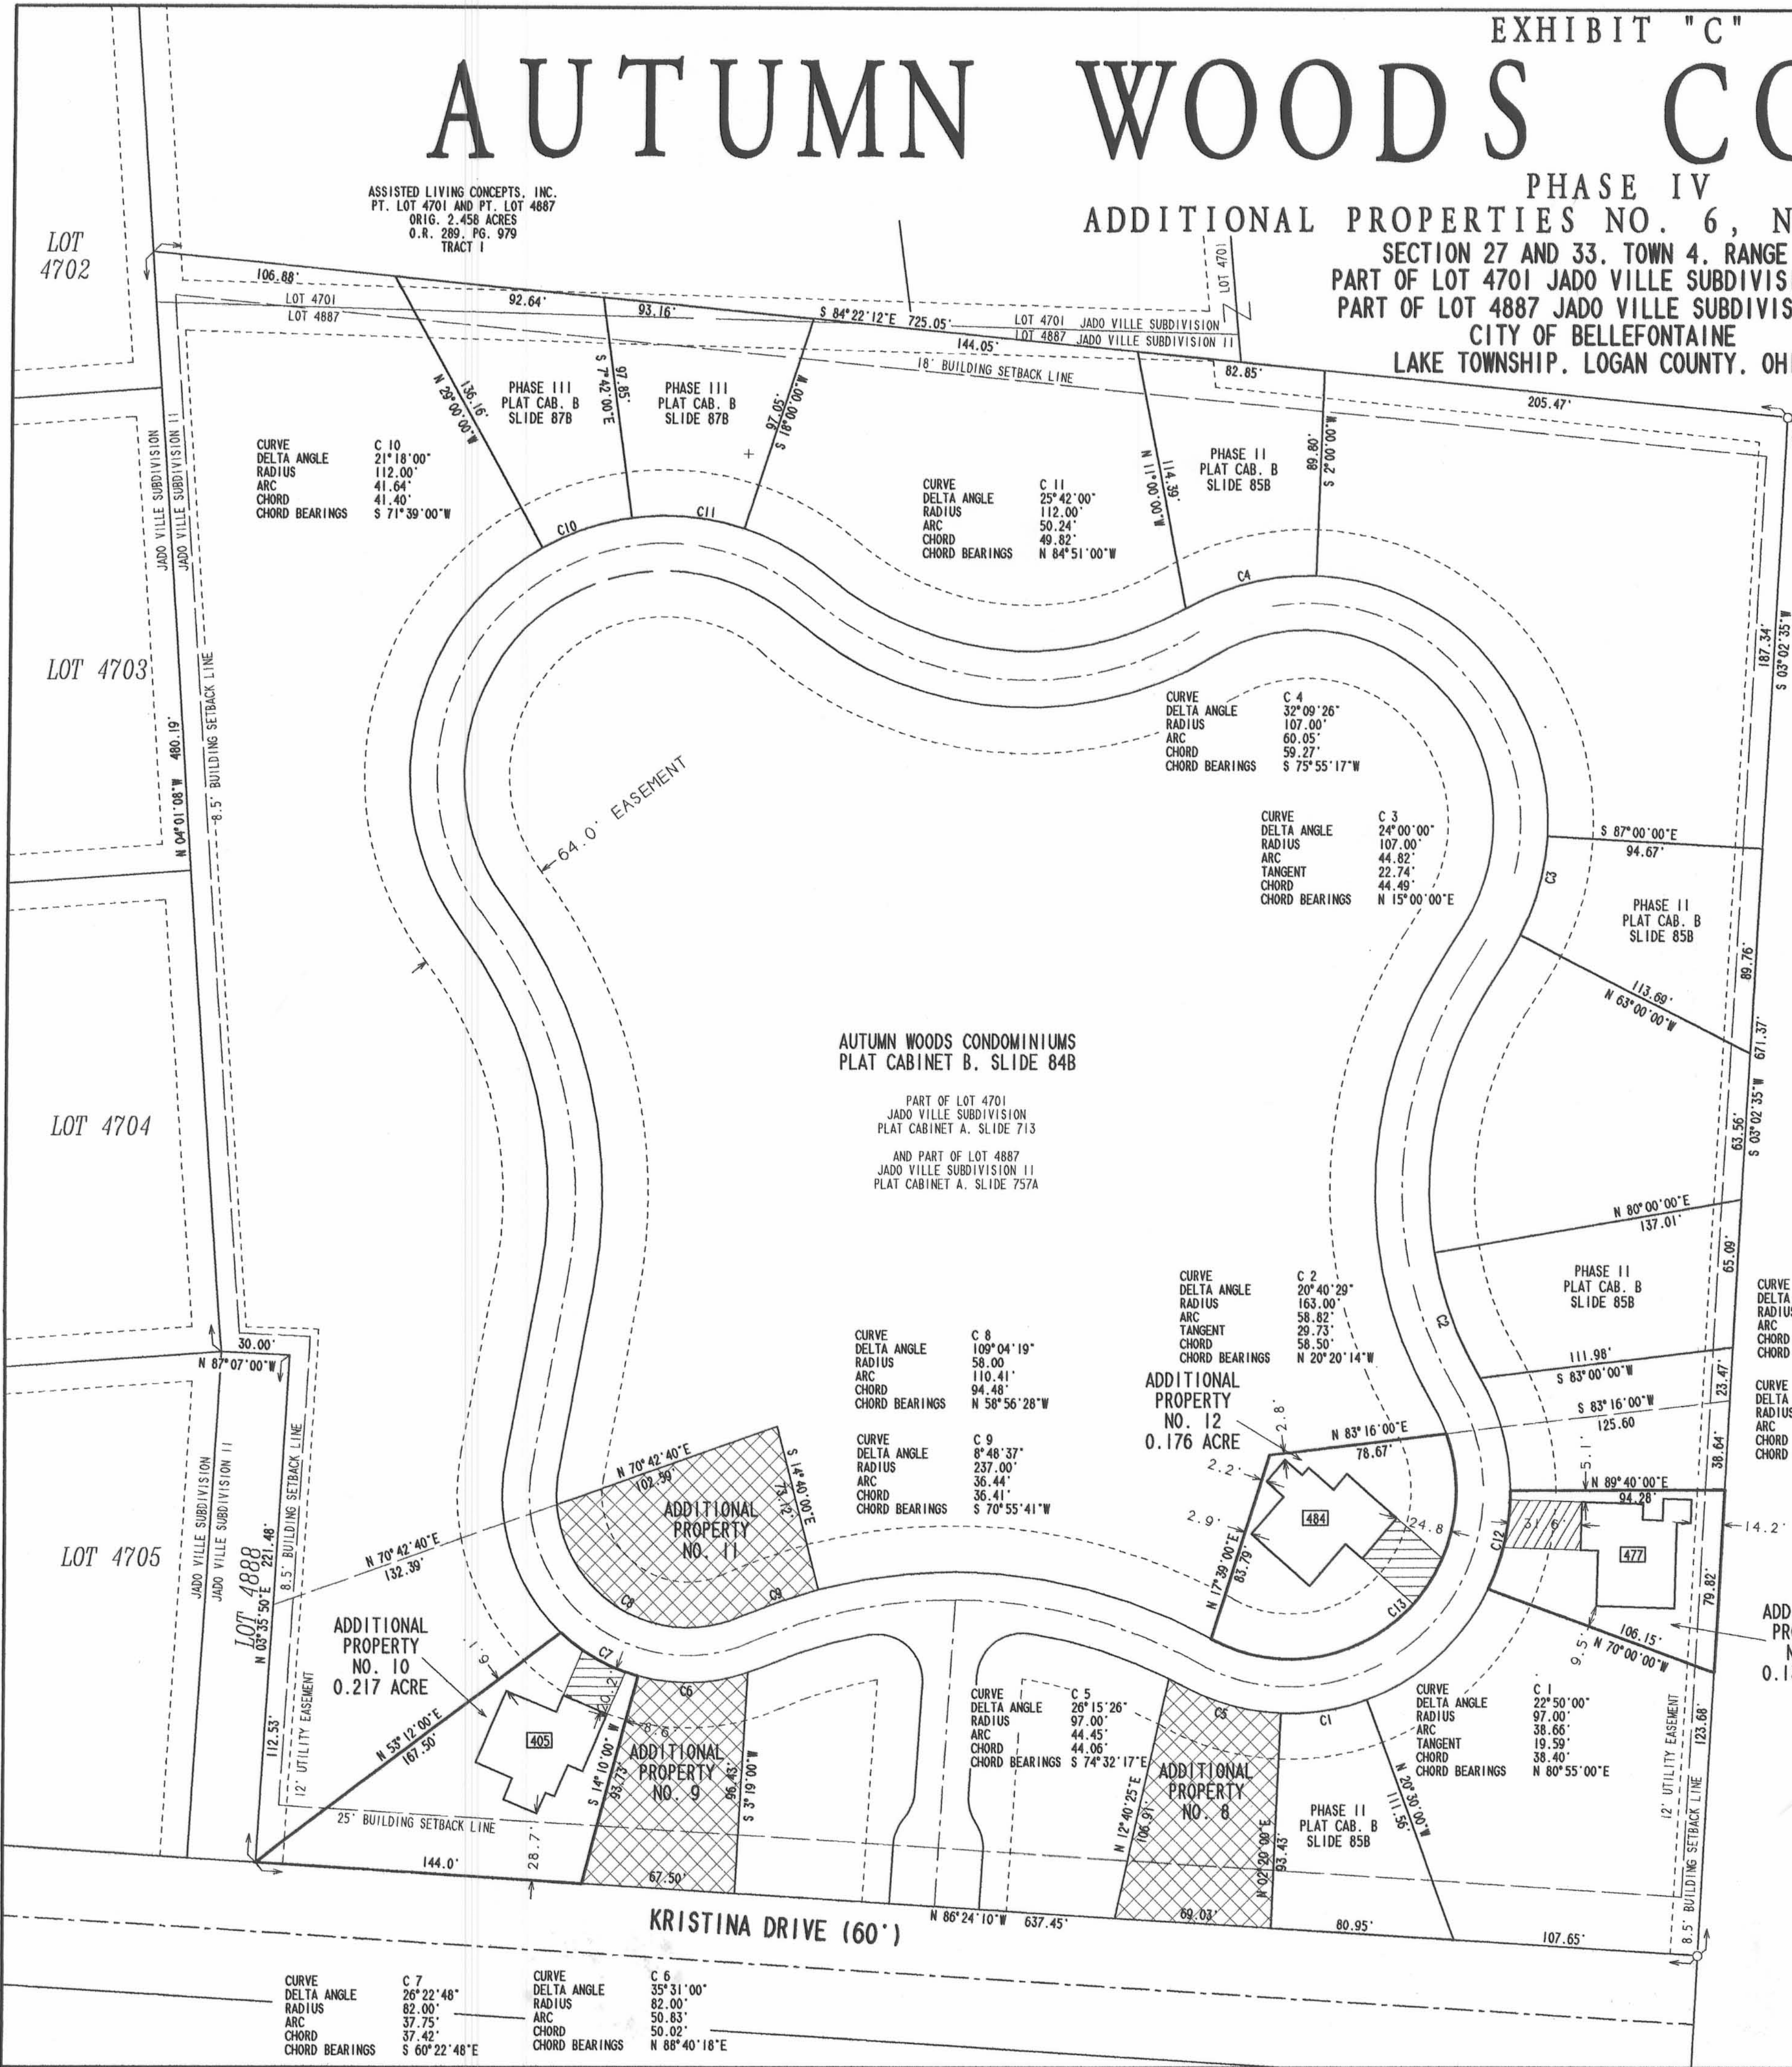

JOHN J. ZIESSLER
AND DORIS A. ZIESSLER
ORIG. 103.13 ACRES
VOL. 386, PG. 705

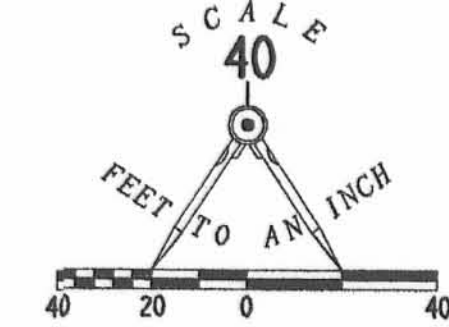

LEGEND

- 5/8 INCH IRON ROD FOUND
- ▭ UNIT NUMBERS
- ▨ LIMITED COMMON AREA
- ▩ REMAINING ADDITIONAL AREA

NOTES:

1. EASEMENTS SHOWN ARE AS PROVIDED BY DEVELOPER. THE SURVEYOR DID NOT SEARCH FOR ADDITIONAL EASEMENTS.
2. THE WORD "CERTIFY" IS INTENDED TO BE AS DEFINED IN OHIO ADMINISTRATIVE CODE 4733-35-04(C).
3. BUILDING HEIGHTS FROM GROUND TO PEAK OF ROOF ARE AS FOLLOWS:
UNIT 405 - 19.6'
UNIT 477 - 19.9'
UNIT 484 - 24.5'

AUTUMN WOODS CONDOMINIUMS
PLAT CABINET B, SLIDE 84B

PART OF LOT 4701
JADO VILLE SUBDIVISION
PLAT CABINET A, SLIDE 713
AND PART OF LOT 4887
JADO VILLE SUBDIVISION II
PLAT CABINET A, SLIDE 757A

ADDITIONAL
PROPERTY
NO. 12
0.176 ACRE

ADDITIONAL
PROPERTY
NO. 6
0.138 ACRE

ADDITIONAL
PROPERTY
NO. 10
0.217 ACRE

ADDITIONAL
PROPERTY
NO. 9

ADDITIONAL
PROPERTY
NO. 8

ENGINEER'S CERTIFICATION:

I DO HEREBY CERTIFY THAT THIS DRAWING ACCURATELY REFLECTS THE BUILDINGS "AS-BUILT OR CONSTRUCTED".

Michael W. Bow
MICHAEL W. BOW
PROFESSIONAL ENGINEER 38860
AUGUST 16, 2004

THE M & K ENGINEERING CO.
322 EAST MAIN STREET
RUSSELLS POINT, OH 43348
(937) 842-2698

SURVEYOR'S CERTIFICATION:

I DO HEREBY CERTIFY THAT THIS SURVEY OF AUTUMN WOODS CONDOMINIUMS PHASE IV ACCURATELY REFLECTS THE LOCATION OF IMPROVEMENTS AND RECORDED EASEMENTS.

Jeffrey I. Lee
JEFFREY I. LEE
PROFESSIONAL SURVEYOR 6359
AUGUST 16, 2004

LEE SURVEYING AND MAPPING CO., INC.
117 NORTH MADRIVER STREET
BELLEFONTAINE, OHIO 43311
(937) 593-7335



APPROVED BY THE BELLEFONTAINE PLANNING COMMISSION
THIS 27th DAY OF August, 2004.

Holly L. Dine
CLERK, PLANNING COMMISSION

PLAT CHECKED *Jon C. Ho* 8-27-04
DESCRIPTION CHECKED *PLAT PRE-APPROVAL Jon C. Ho* 8/27/04

TRANSFERRED THIS 30th DAY OF August, 2004.

Michael E. Godwin
AUDITOR, LOGAN COUNTY, OHIO

RECORDED IN PLAT CABINET B, SLIDE 90 B
RECEIVED FOR RECORD AT 10:50 O'CLOCK A.M.

THIS 30th DAY OF August, 2004.

Amila Hanson
RECORDER, LOGAN COUNTY, OHIO

COPYRIGHT 2004 BY:
LEE SURVEYING & MAPPING CO., INC.
117 North Madriver Street
Bellefontaine, Ohio 43311
(937) 593-7335
KSR D413 AWC-4 L-3639-1

2004008503