

**THE DRAWINGS OF
HUNTERS RIDGE CONDOMINIUM
FIFTH AMENDMENT
STATE OF OHIO, COUNTY OF LOGAN,
CITY OF BELLEFONTAINE, TOWNSHIP OF JEFFERSON
VIRGINIA MILITARY SURVEY NO. 4399
PLOT PLAN PROPERTY ADDED**



**ADDITIONAL
PROPERTY
1.759 Ac.**

Property Group
One, Inc.
O.R. 90, Pg. 887

WHISPERING PINES NO. 1
LOT 4641
Plat Cabinet "A",
Slides 681, 682 & 683

Approved by the Bellefontaine Planning Commission
this 24th day of December, 1998

F. L. N...
Clerk, Planning Commission

Pre-Approval Jon L. Hines 12-24-98

Plat Check Jon L. Hines 12-24-98

Transferred this 24th day of Dec, 1998.

Michael E. Lyden
Auditor, Logan County, Ohio

Recorded in Plat Cabinet B, Slide 36B & 37A


Received for record at 10:45:00 o'clock A.m.
this 24th day of December, 1998.

Carolyn Collins
Recorder, Logan County, Ohio

EVANS, MECHWART, HAMBLETON & TILTON, INC.
CERTIFICATION

I hereby certify that the attached drawings accurately represent buildings as located at HUNTERS RIDGE CONDOMINIUM FIFTH AMENDMENT and that there are no encroachments on any abutting premises and said drawings accurately show the buildings as constructed.

By Thomas D. Sibbalds
Registered Surveyor No. 5908
Thomas D. Sibbalds

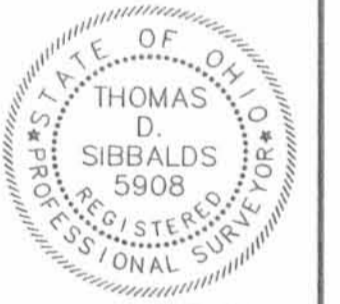

By Michael J. Fitzpatrick
Registered Architect Ohio No. 4586
Michael J. Fitzpatrick



NOTE:
BASIS OF BEARINGS : The Basis of Bearings is the bearing between Lots No. 4640 & 4641 at S 17°23' E, as shown on the recorded plat of Whispering Pines No. 1, Plat Cabinet "A", Slides 681, 682 & 683, Logan County, Ohio.

SURVEYED & PREPARED
BY
EMT
CONSULTING ENGINEERS & SURVEYORS
170 MILL STREET
GAHANNA, OHIO 43230
(614) 471-5150




GRAPHIC SCALE 1" = 20' DECEMBER 10, 1998

- = 3/4" (I.D.) IRON PIPE FOUND
- = 3/4" (I.D.) IRON PIPE SET
- ◇ = CONCRETE MONUMENT FOUND

LEGEND
Areas not designated as units or limited common areas are common areas.
000 = Unit Number
00 = Building Number
[Hatched Box] = Limited Common Area

FIFTH AMENDMENT TO THE DRAWINGS FOR:
HUNTER'S RIDGE CONDOMINIUM

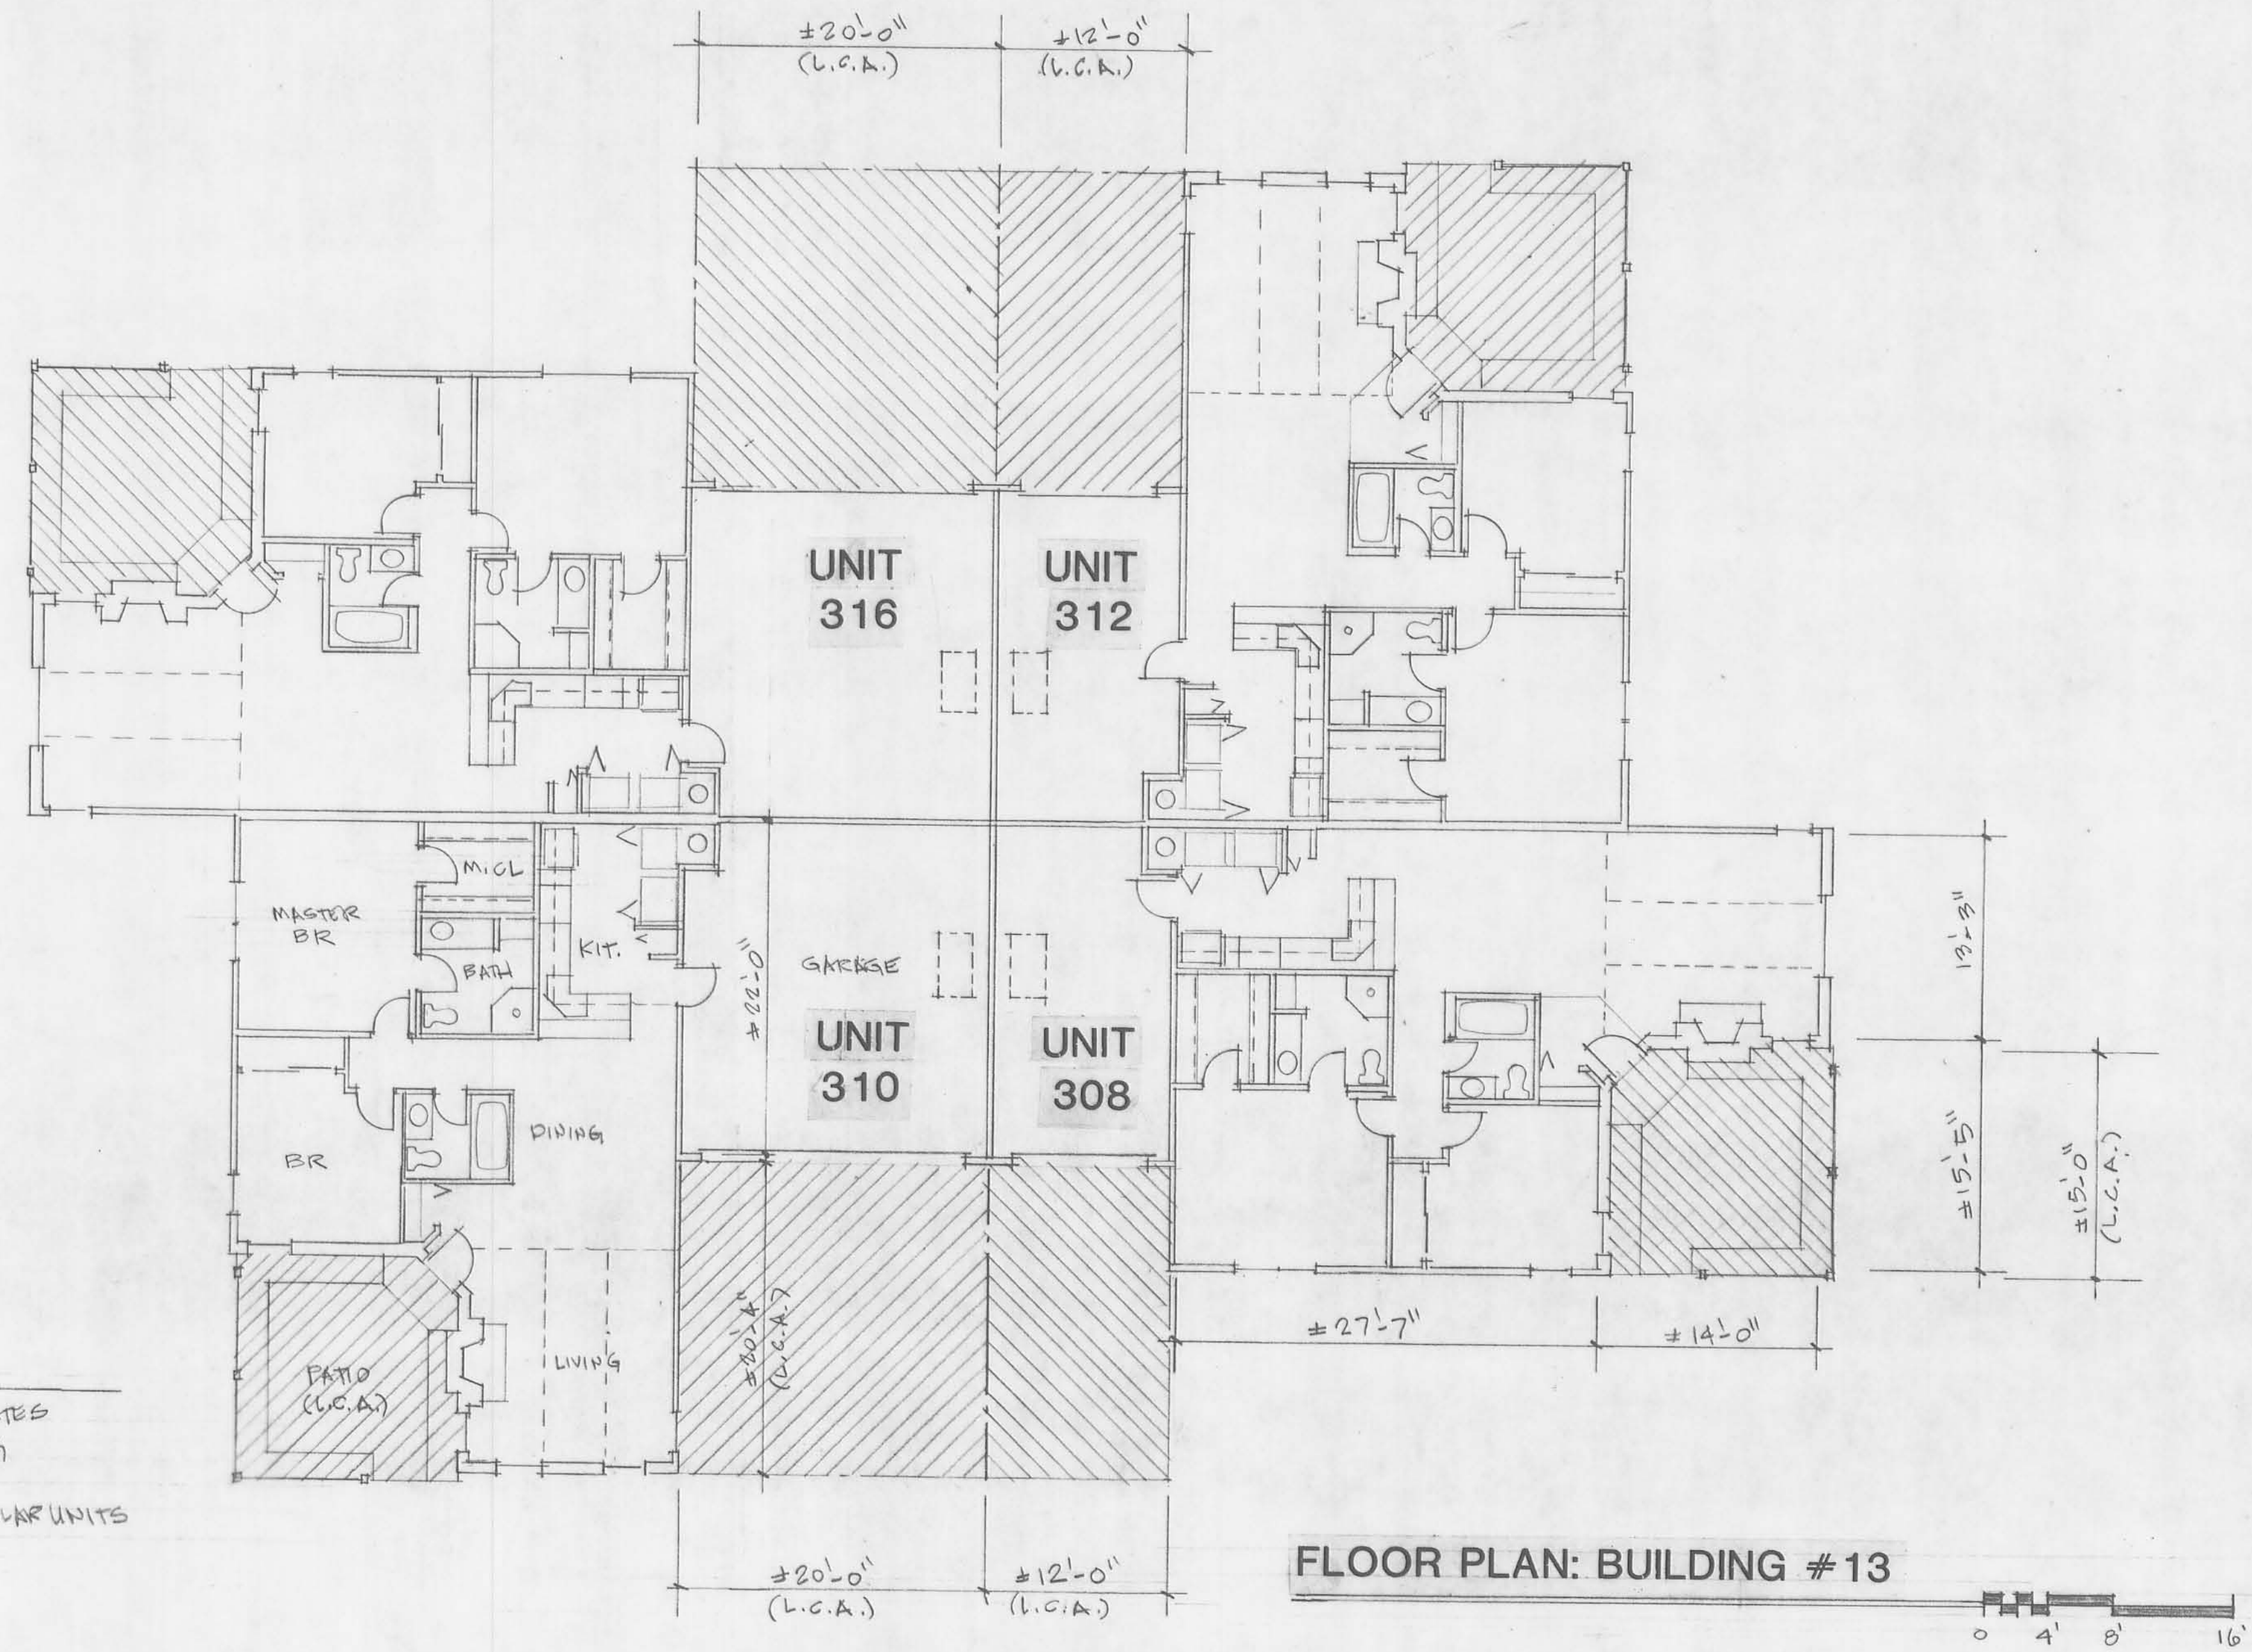


NOTE:
 AREAS DESIGNATED THIS Hatched INDICATES LIMITED COMMON AREA PERTAINING TO ADJACENT UNIT.
 DIMENSIONS SHOWN ARE TYPICAL OF ALL SIMILAR UNITS
 (L.C.A.) = LIMITED COMMON AREA


FLOOR PLAN: BUILDING #13

Drawing	Date
<input type="checkbox"/> Preliminary	
<input type="checkbox"/> Bid	
<input type="checkbox"/> Permit	
<input type="checkbox"/> Construction	
<input checked="" type="checkbox"/> Condominium	
Revisions	
△	△
△	△
△	△
△	△

Seal

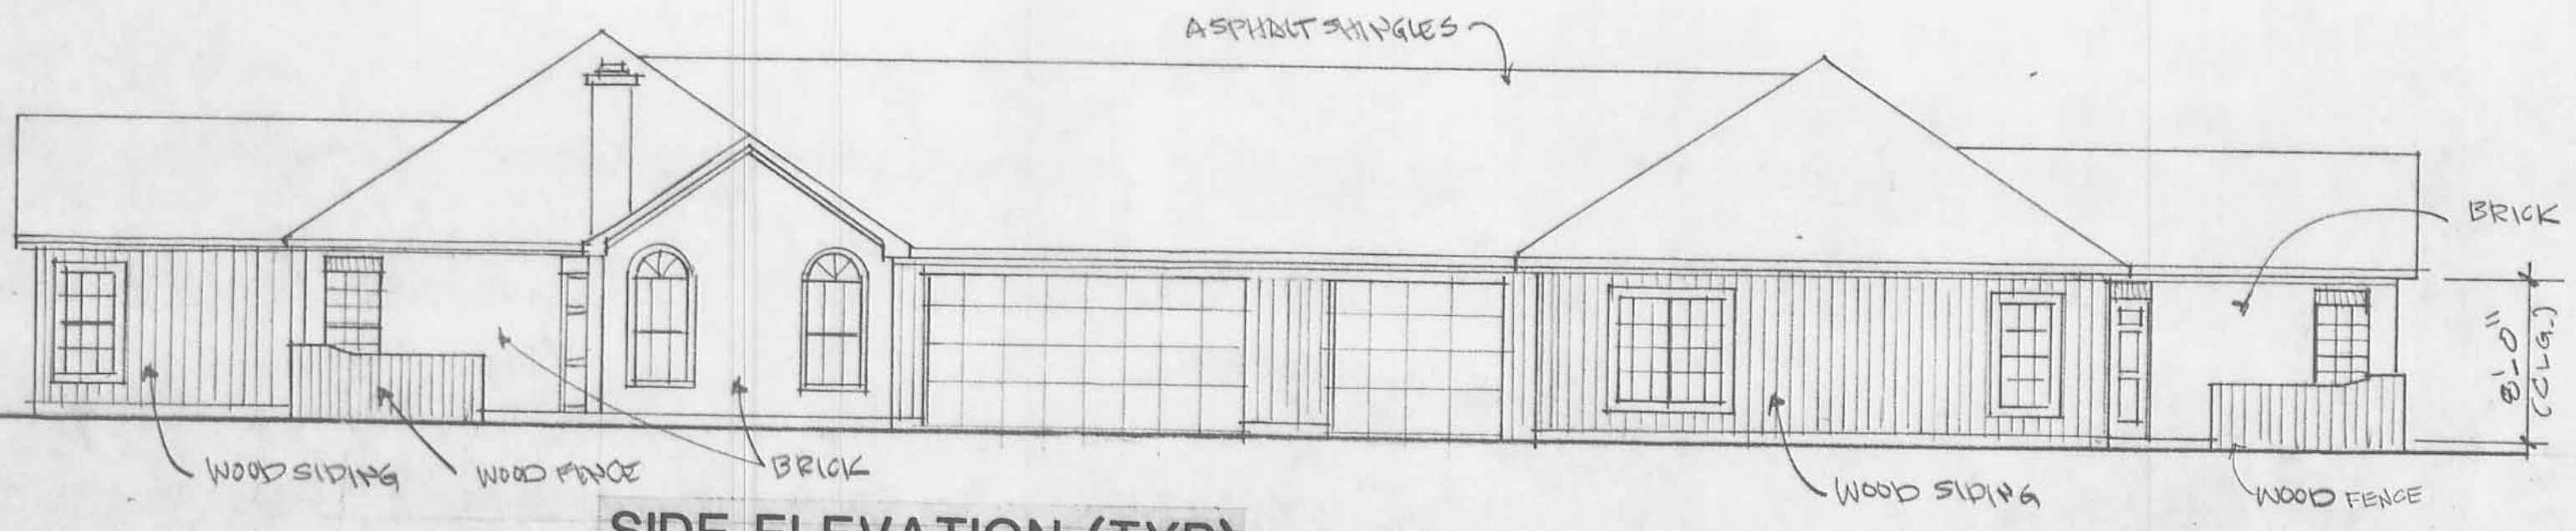

SIDE ELEVATION (TYP)
 Units 316 and 312 (Reverse Elevation)

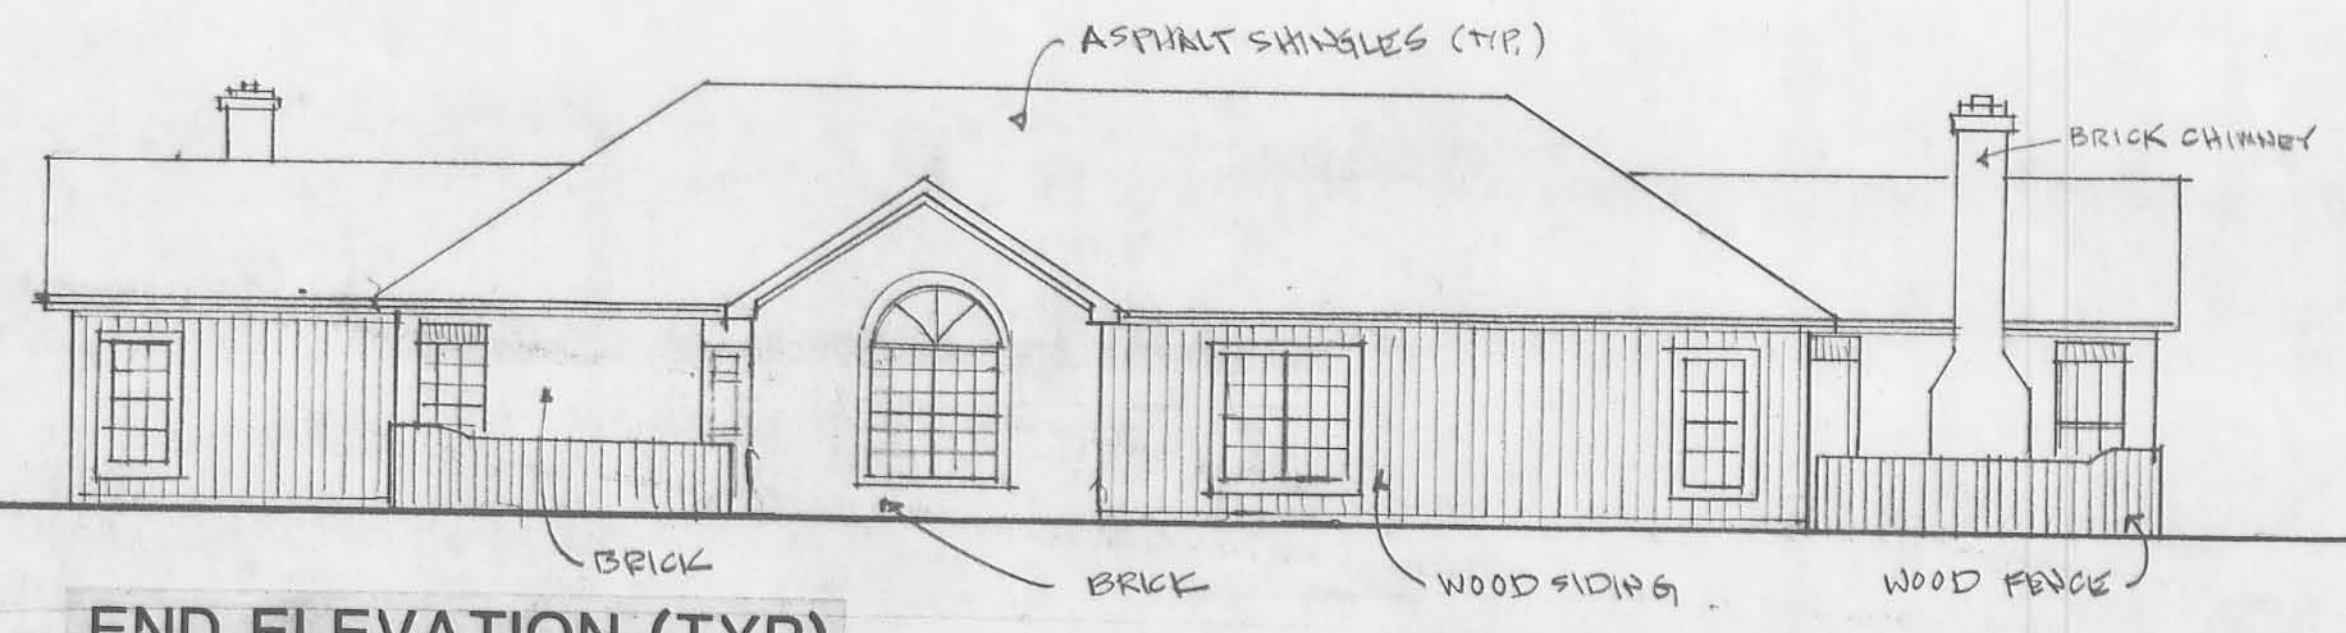

END ELEVATION (TYP)

ARCHITECTURAL ALLIANCE
 165 North Fifth Street • Columbus, Ohio 43215 • (614) 469-7500 • fax: 469-0500

Project Number	92107
Sheet Title	BUILDING # 13
Sheet Number	2 of 2