


**THE DRAWINGS OF
HUNTERS RIDGE CONDOMINIUM
FIFTH AMENDMENT
STATE OF OHIO, COUNTY OF LOGAN,
CITY OF BELLEFONTAINE, TOWNSHIP OF JEFFERSON
VIRGINIA MILITARY SURVEY NO. 4399
PLOT PLAN PROPERTY ADDED**

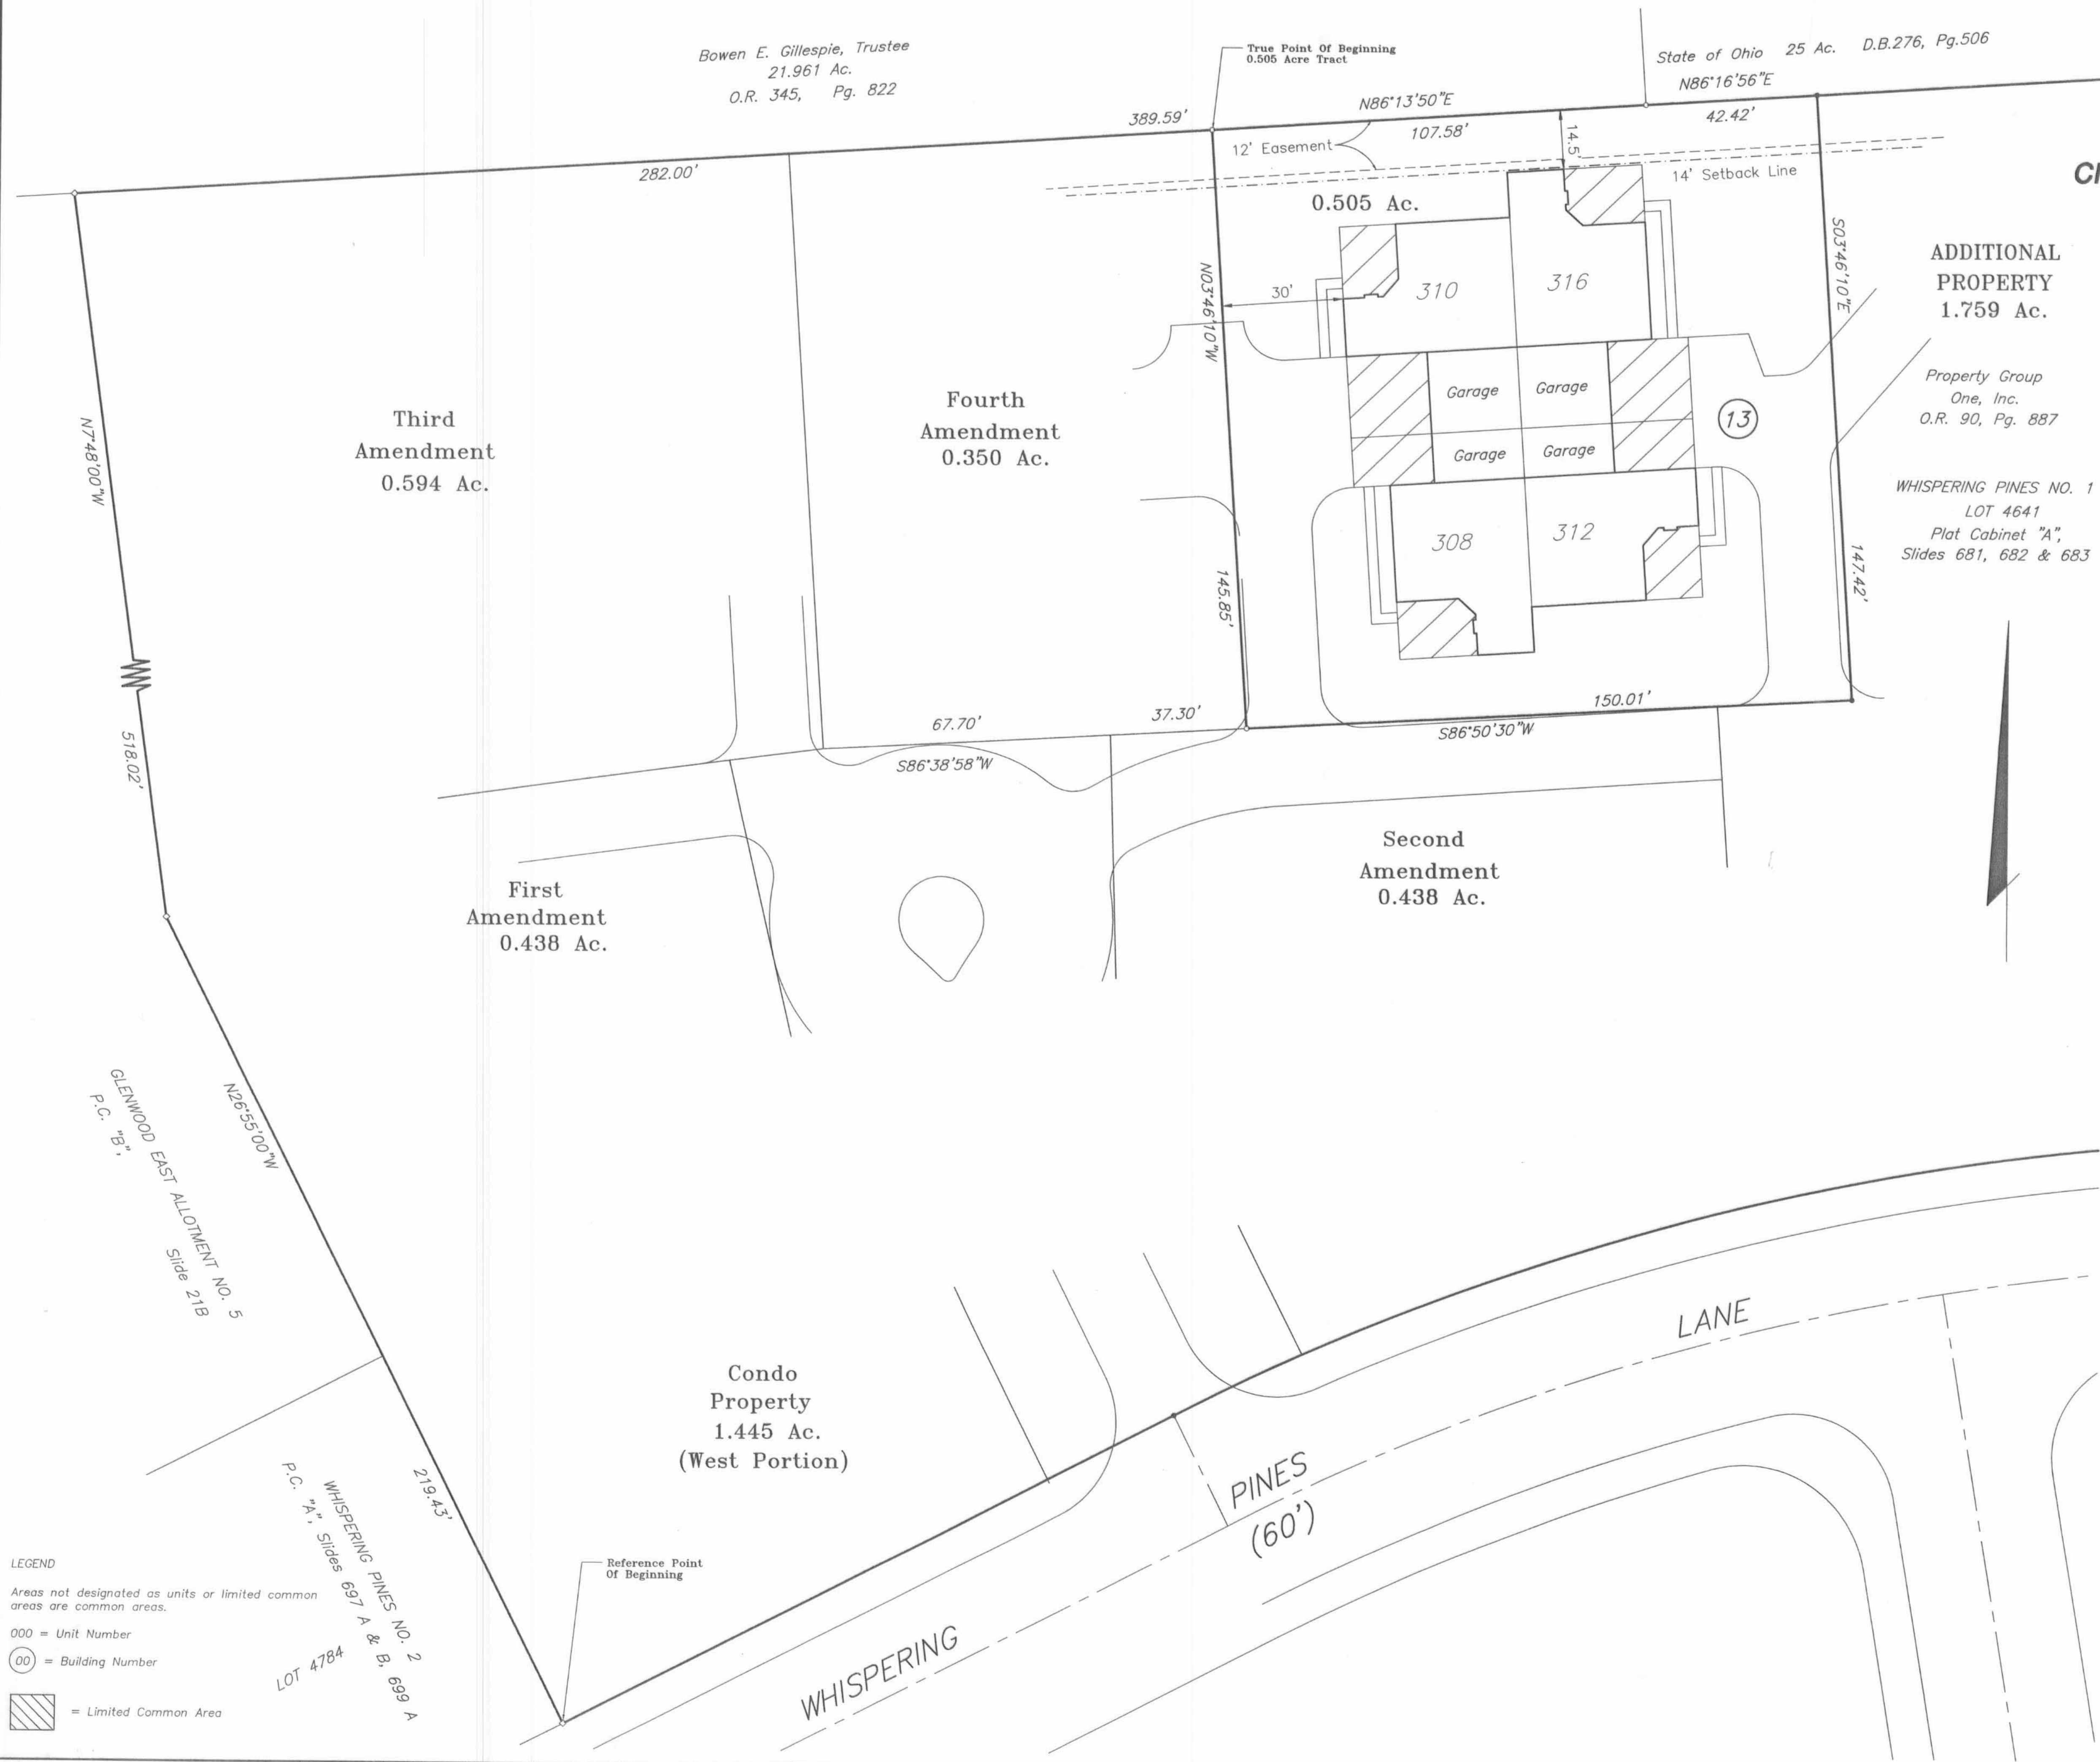

**ADDITIONAL
PROPERTY
1.759 Ac.**

Property Group
One, Inc.
O.R. 90, Pg. 887

WHISPERING PINES NO. 1
LOT 4641
Plat Cabinet "A",
Slides 681, 682 & 683

Approved by the Bellefontaine Planning Commission
this 8th day of February, 1999

[Signature]
Clerk, Planning Commission

Pre-Approval Jan C. Hines 2-3-99

Plat Check Jan C. Hines 2-8-99

Transferred this 8th day of FEBRUARY, 1999.

Recorded in Plat Cabinet B, Slide 40A
Received for record at 10:54:00 o'clock a.m.
this 8th day of February, 1999.

[Signature]
Recorder, Logan County

EVANS, MECHWART, HAMBLETON & TILTON, INC.
CERTIFICATION


I hereby certify that the attached drawings accurately represent buildings as located at HUNTERS RIDGE CONDOMINIUM FIFTH AMENDMENT and that there are no encroachments on any abutting premises and said drawings accurately show the buildings as constructed.

By Thomas D. Sibbalds
Registered Surveyor No. 5908
Thomas D. Sibbalds

By David A. Hussey
Registered Engineer No. 33179
David A. Hussey

NOTE:
BASIS OF BEARINGS : The Basis of Bearings is the bearing between Lots No. 4640 & 4641 at S 17°23' E, as shown on the recorded plat of Whispering Pines No. 1, Plat Cabinet "A", Slides 681, 682 & 683, Logan County, Ohio.

SURVEYED & PREPARED BY
EMT & INC.
CONSULTING ENGINEERS & SURVEYORS
170 MILL STREET
GAHANNA, OHIO 43230
(614) 471-5150

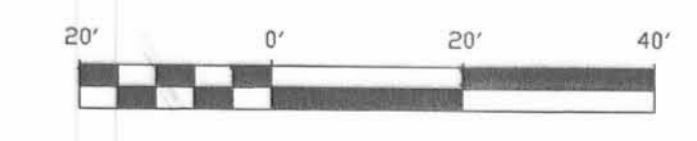

DECEMBER 10, 1998
REVISED JANUARY 6, 1999

- = 3/4" (I.D.) IRON PIPE FOUND
- = 3/4" (I.D.) IRON PIPE SET
- ◊ = CONCRETE MONUMENT FOUND

LEGEND

Areas not designated as units or limited common areas are common areas.

000 = Unit Number

○ = Building Number

▨ = Limited Common Area