

Surveyed for Widow of

William Morgan }
Austin Artin } ch or -
Oscar Morgan } wh.

Line "A"

Set narrow tooth in center of fence
in line of fence for distance
line of land
with fike 543 ft 15.5 ft set stake

Line B. with fike -

373 1/2 ft 1.50 to stone corner to
fence.

29
James H. Morgan April 19. 1899.

Line "C"

with west line fence

set east 6'

55 1/2 ft 16.60 to stone

corner out 5' east.

Line D.

519 1/2 ft 25 lbs

set stake in center of dirt road.

Line E.

with dirt road south side of

fence N 72 E 21.25 1/2 ft

set iron bar

1st Sugar 18" (gods post) N 4 1/2 E 48 lbs

" Sugar 18" N 4 E 79 lbs

Line 7

116³/₄ 114

2298

to iron gear in pits beginning

Tom Hallings Survey


Measured east with north side
 of Brown St. from sidewalk line
 on east side mark 177+1 - 178'
 for Ludlow line set pole 2'
 east -
 set east 2' from iron bar
 in Sandusky & Ludlow -
 set pin in line -

Measured east on inside line of
 sidewalk 218' for Hallings SNE
 and 268' for Hallings SW

Measured 218' on alley line
 for Hallings NE
 and 268' for his SW this
 corner runs east of west line
 of barn -

Part of Truman Brown Prop-
 E. Sandusky Av. April 29 - 1894

Iron pin Ludlow & Sandusky -
 Bottom east end bottom step, corner
 William 37'
 West end Wood corner lower step 31.6'
 Hyd north 20.8'

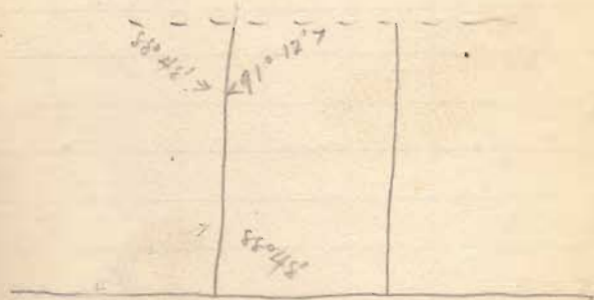

Sandusky Av

Levels Tom Hillings house -

Sidewalk	1.65	20.00	1st block from line	
Ins		21.65		
No stake	7.53	14.12	22.00	7.88
W "	8.27	13.38	22.00	8.62

set level peg by stake