


MOREAN SURVEY
 STOKES TOWNSHIP
 LOGAN COUNTY OHIO
 SHAWNEE ISLAND ALLOTMENT

MARCH 1957
 1" = 15'

NORTH LINE OF LOTS AS SHOWN FOLLOWS
 PRESENT STONE & CONCRETE WALL

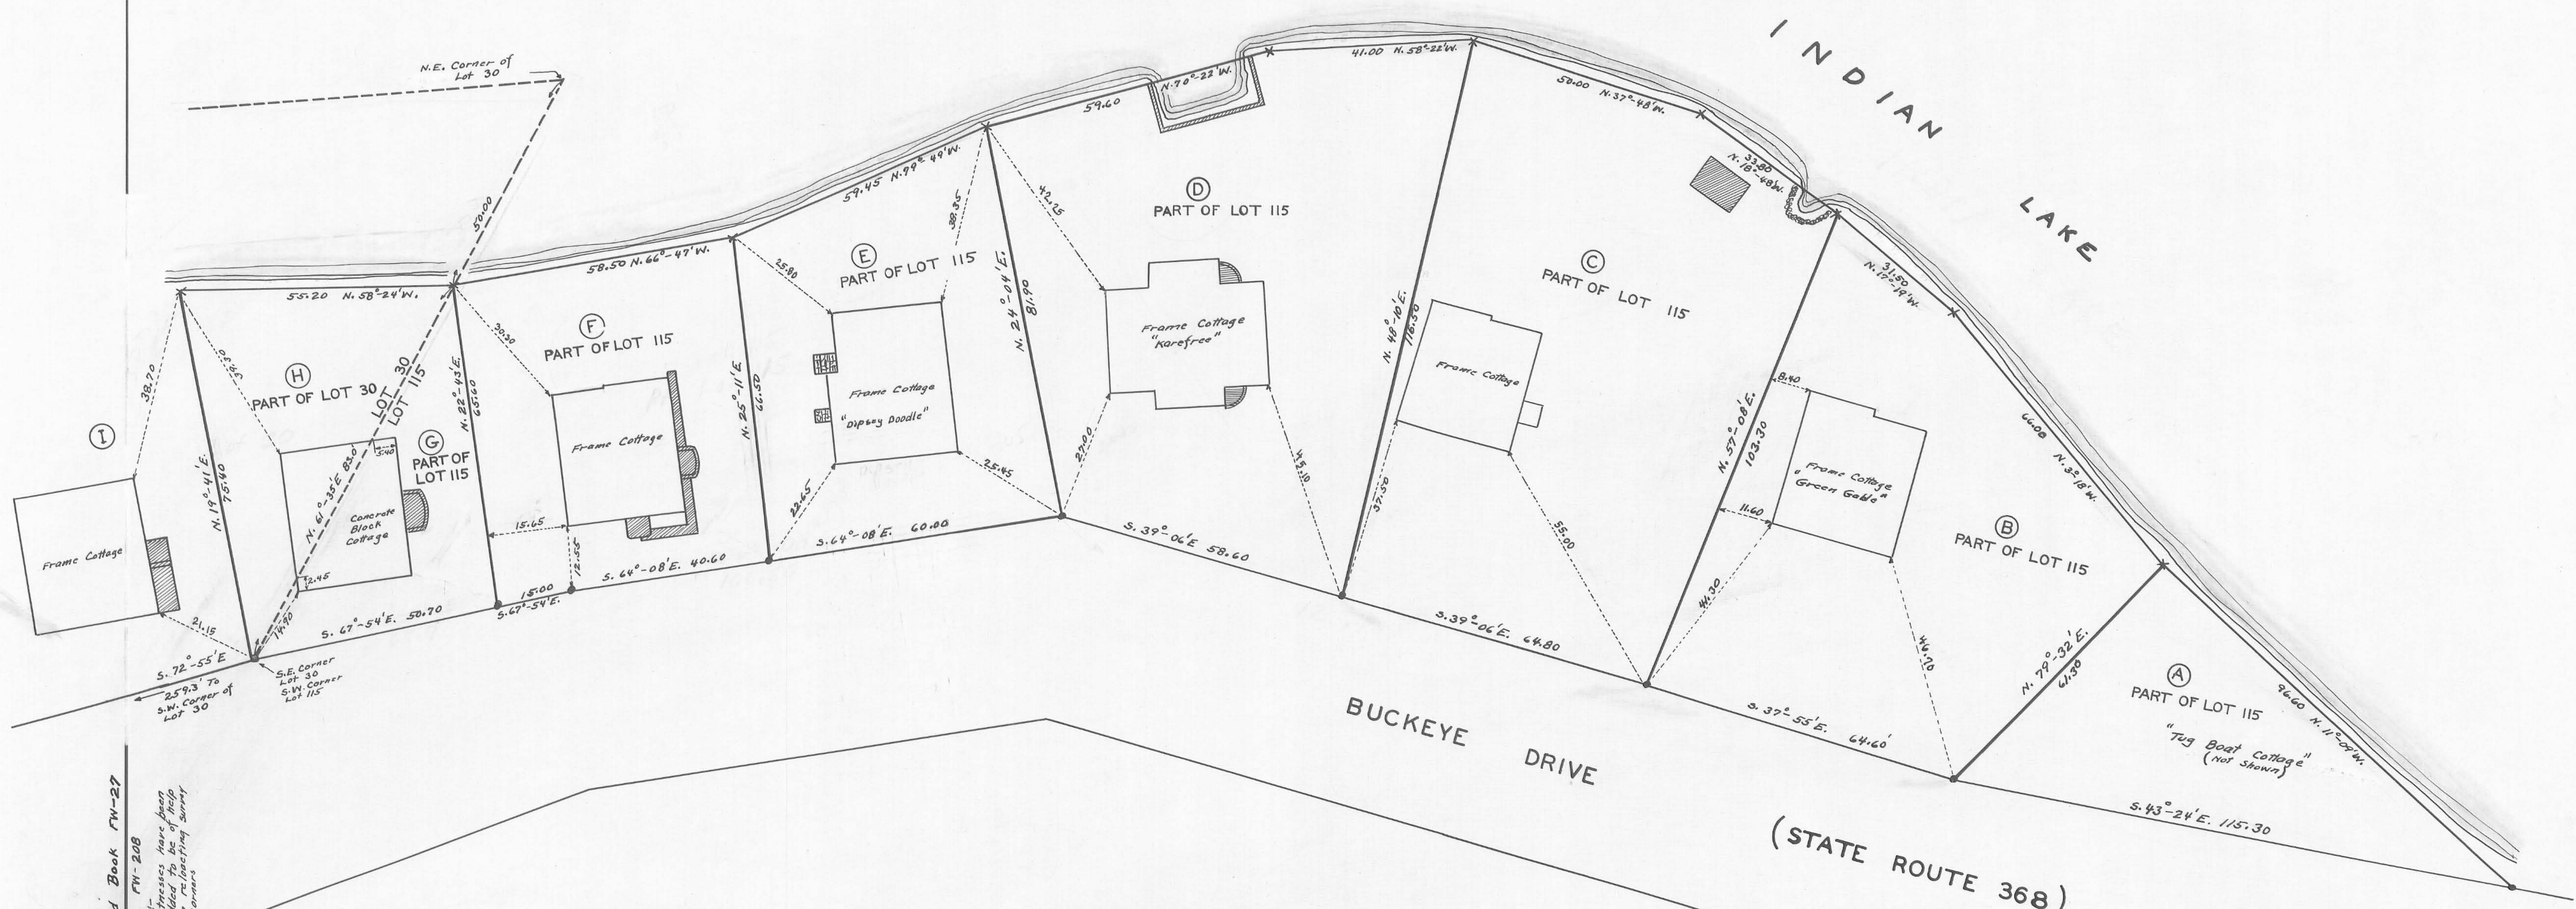

● INDICATES IRONS
 × INDICATES CHISEL CROSS ON WALL

Field Book MW-27
 File MW-208
 Notes: -
 Addresses have been
 added to loc of trip
 in re-locating Survey
 Corners

