
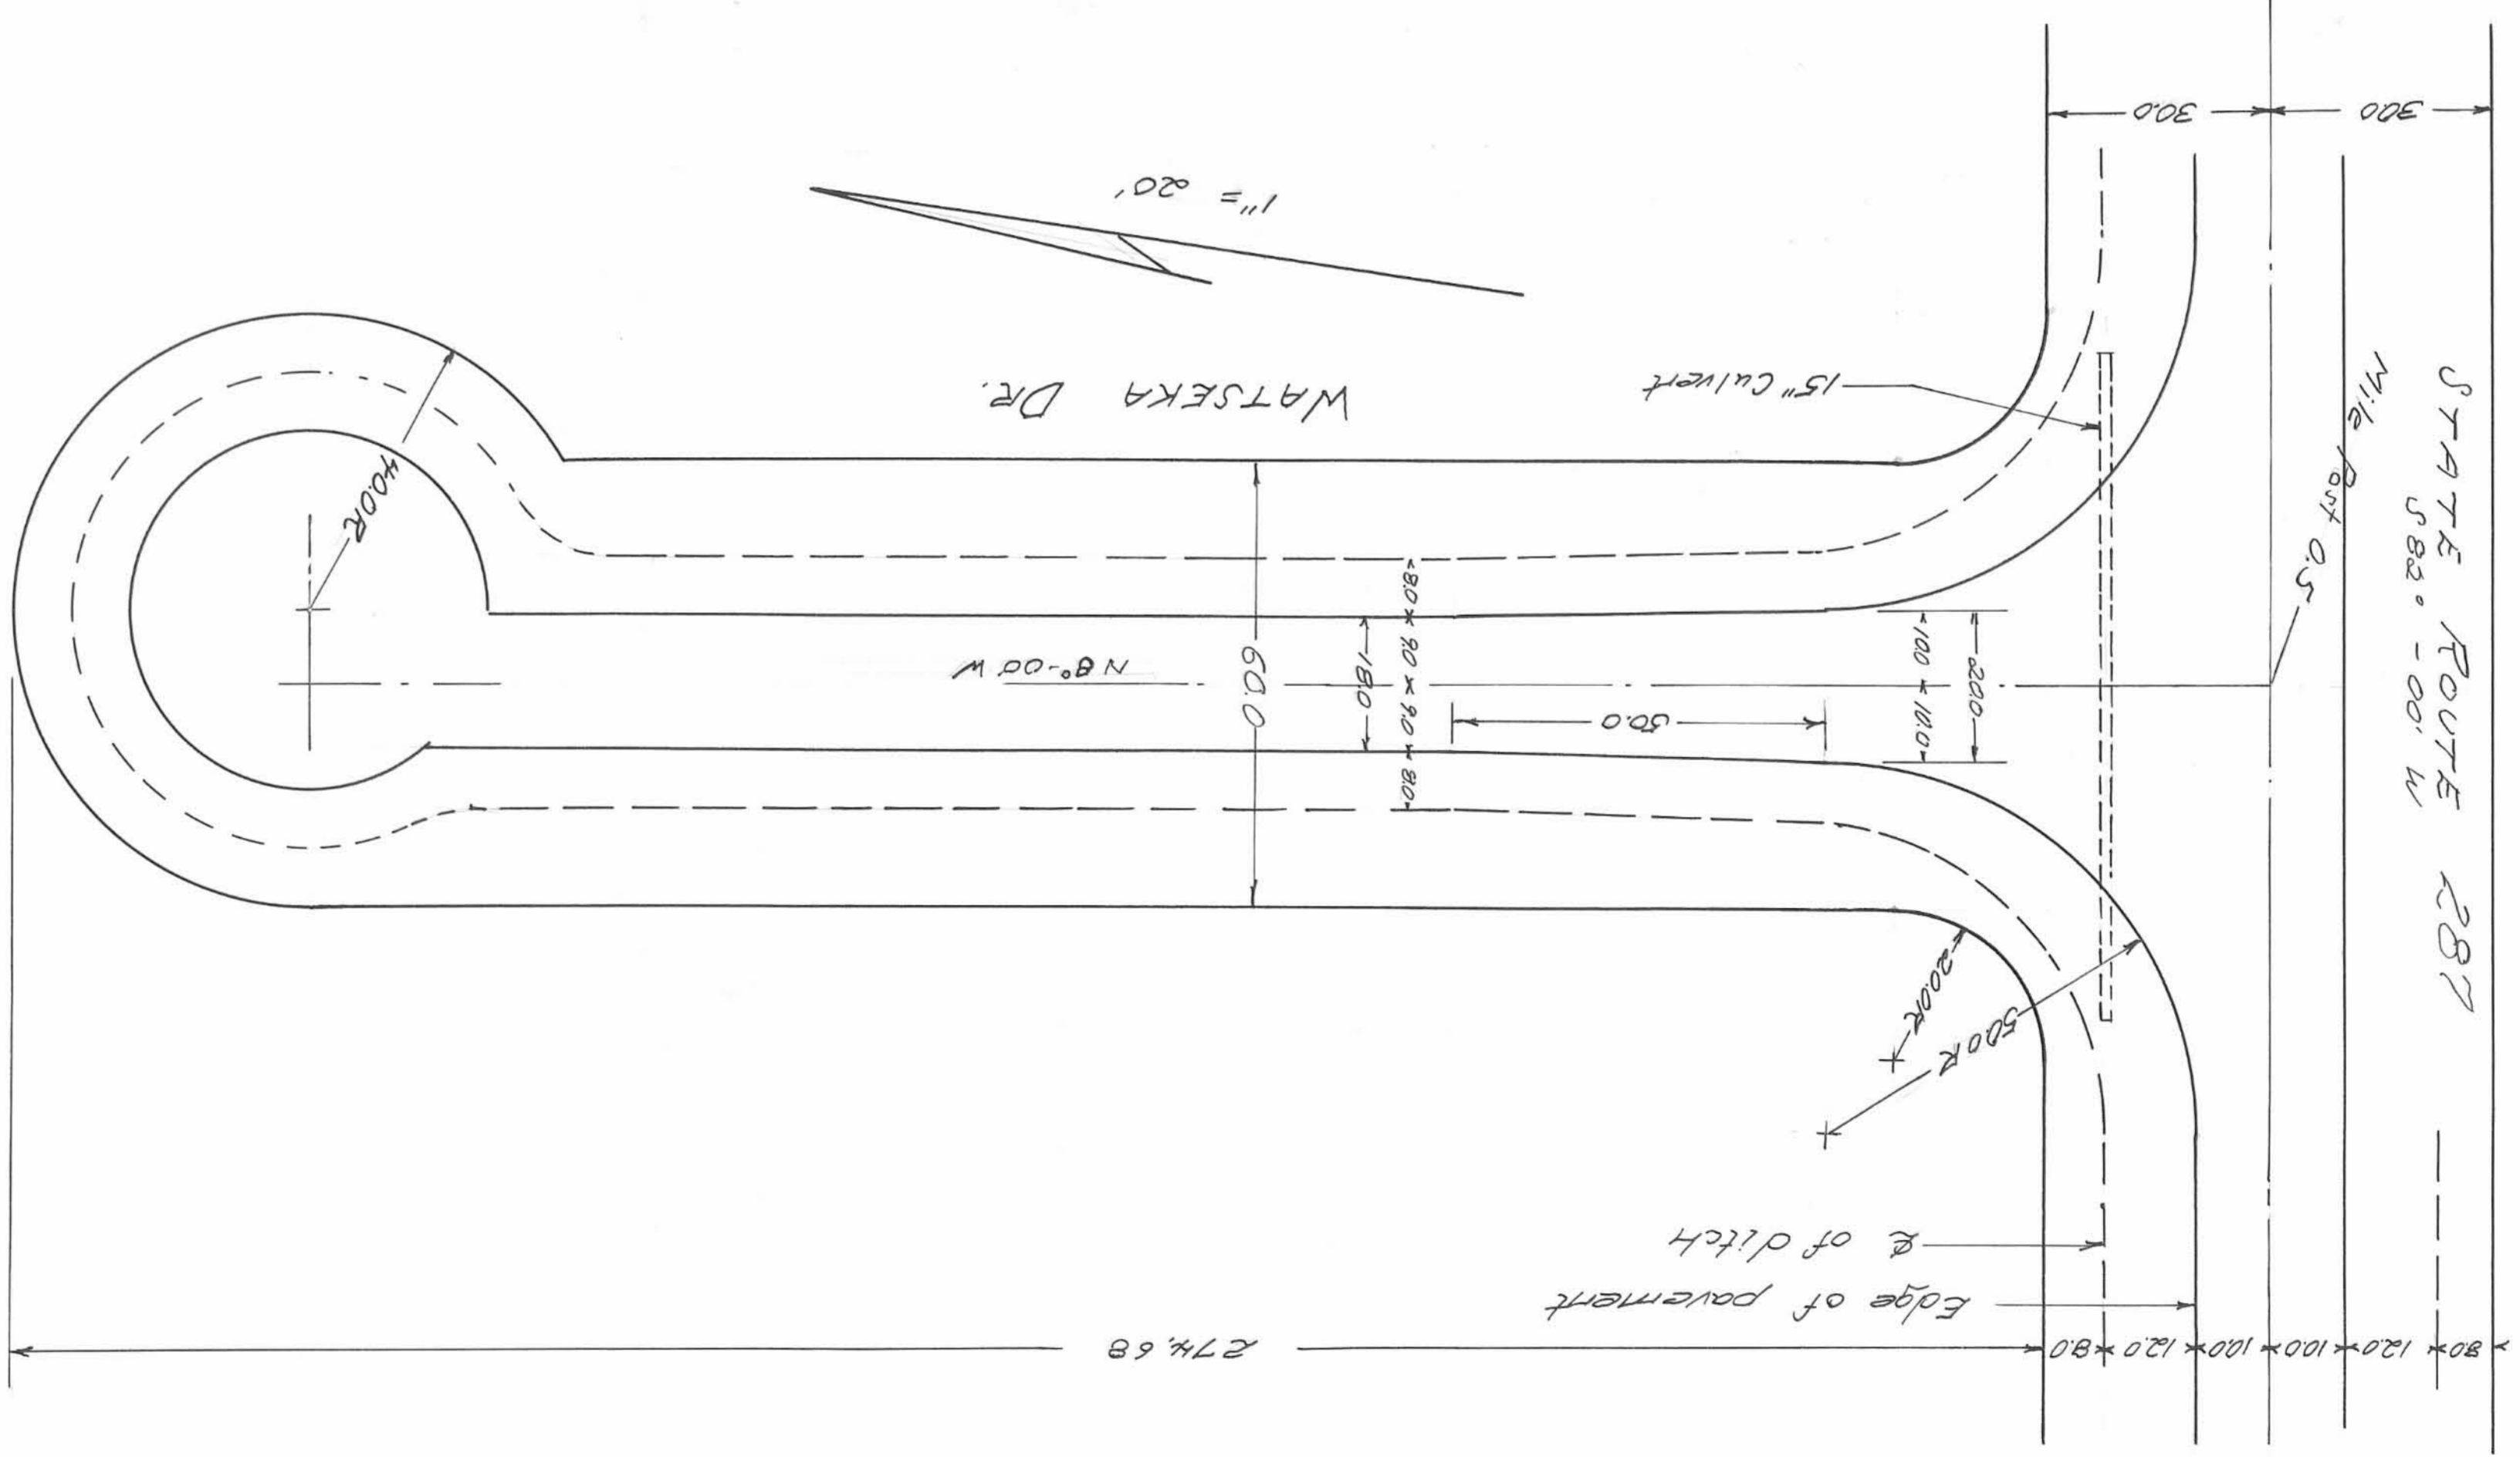


PROFILE	
SURVEYED	DATE
PLOTTED	BY
ADJUSTED	DATE
INSTRUMENT	NO.
STRUCTURE	NO.

PLAN	
SURVEYED	DATE
PLOTTED	BY
ADJUSTED	DATE
INSTRUMENT	NO.
STRUCTURE	NO.

1180  
1130  
1140  
1150

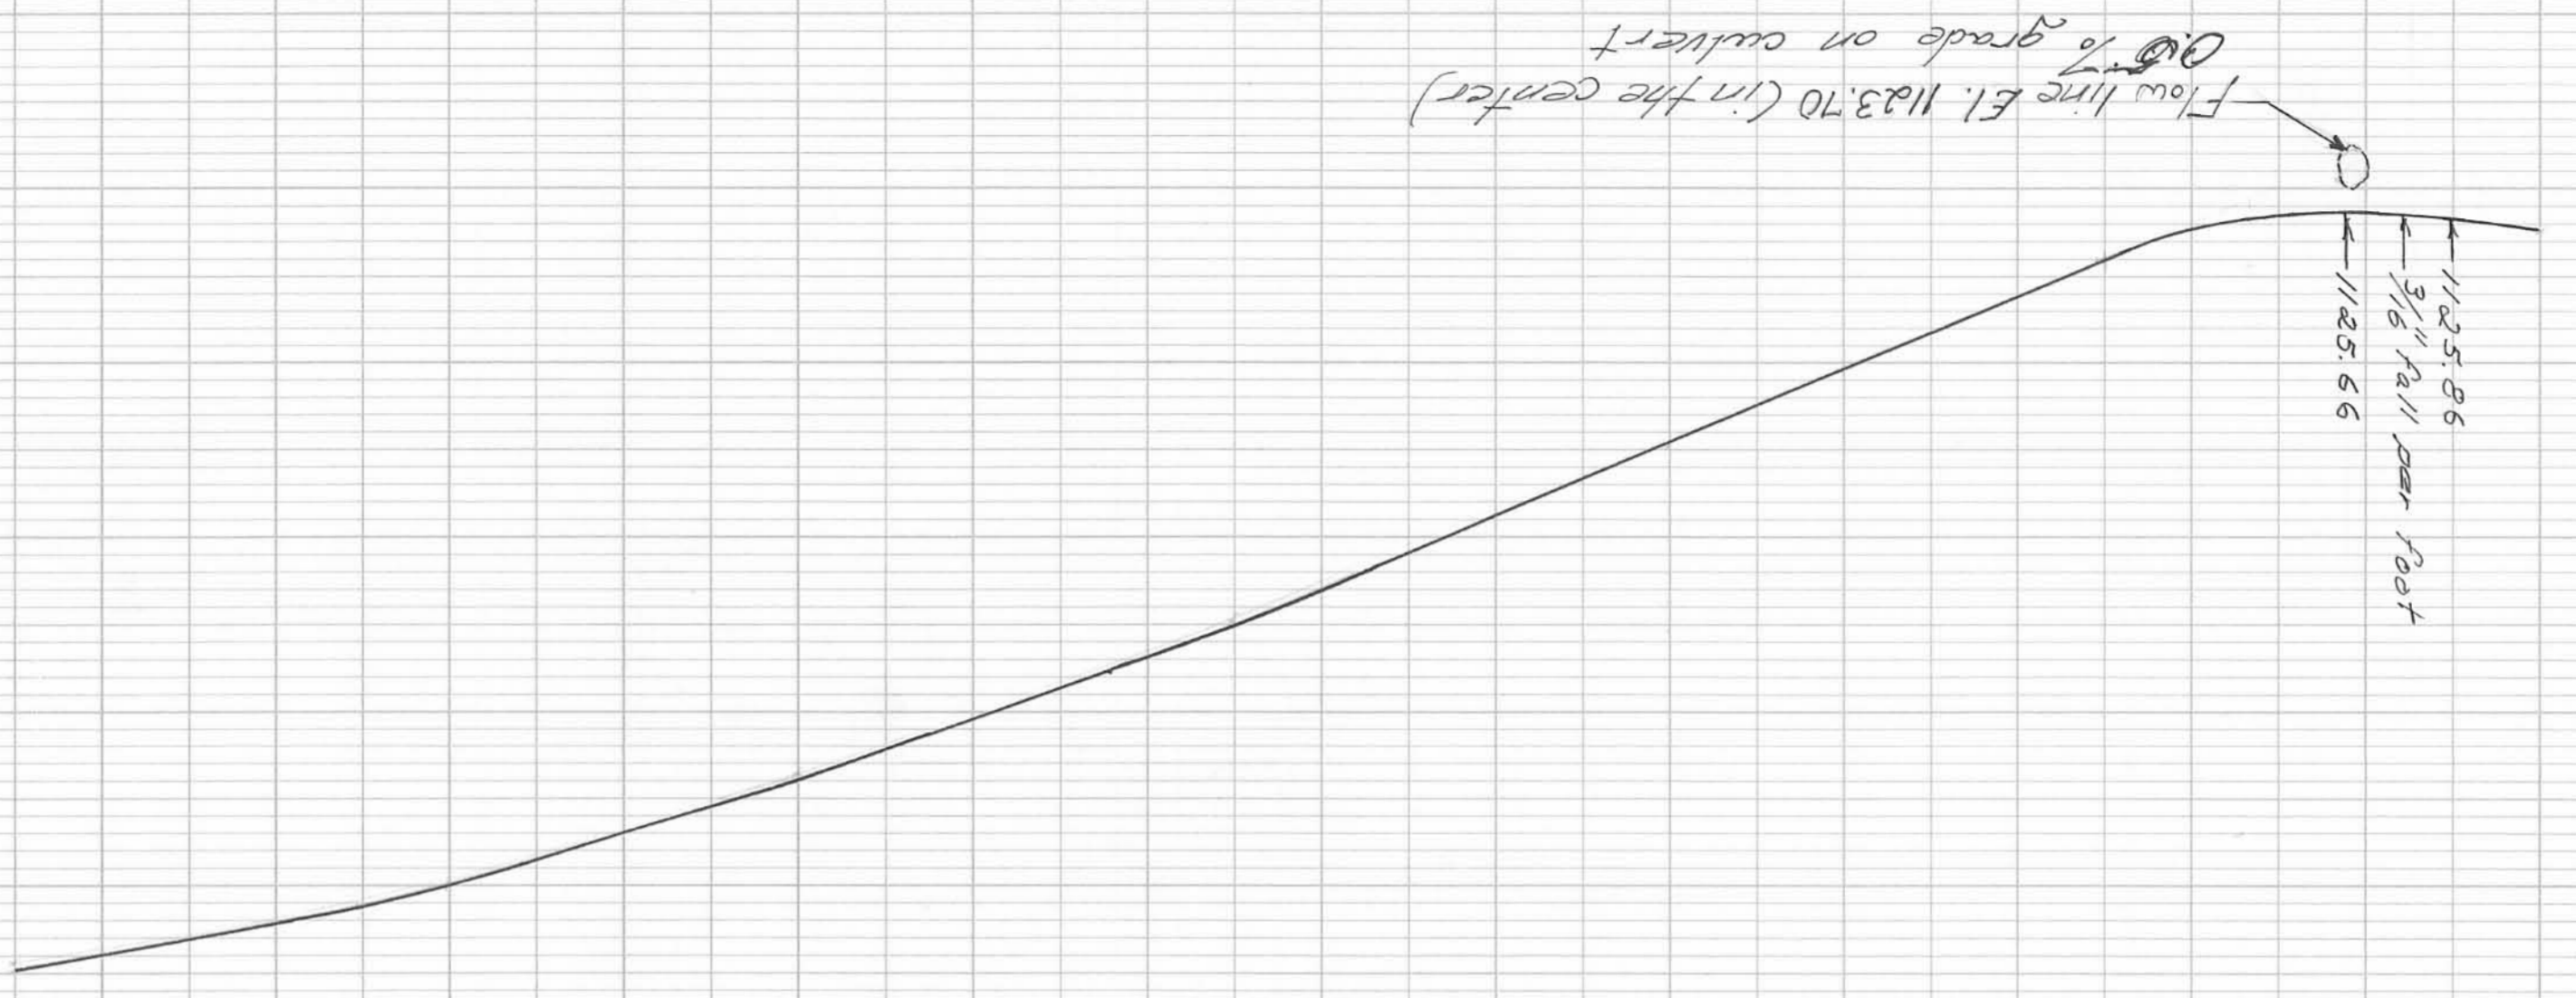

Entrance of Watsseka Dr.  
Montee Twp, Logan Co., Ohio  
Surveyed by O.K. Shirk, 4271