


PROFILE		DATE
SURVEYED	BY	
PLOTTED	BY	
FLIGHT CHECKED	BY	
NO. _____	STRUCTURE NOTATIONS ON P.L.D.	

PLAN		DATE
SURVEYED	BY	
PLOTTED	BY	
FLIGHT CHECKED	BY	
NO. _____	STRUCTURE NOTATIONS ON P.L.D.	


1230
1240
1250
1260

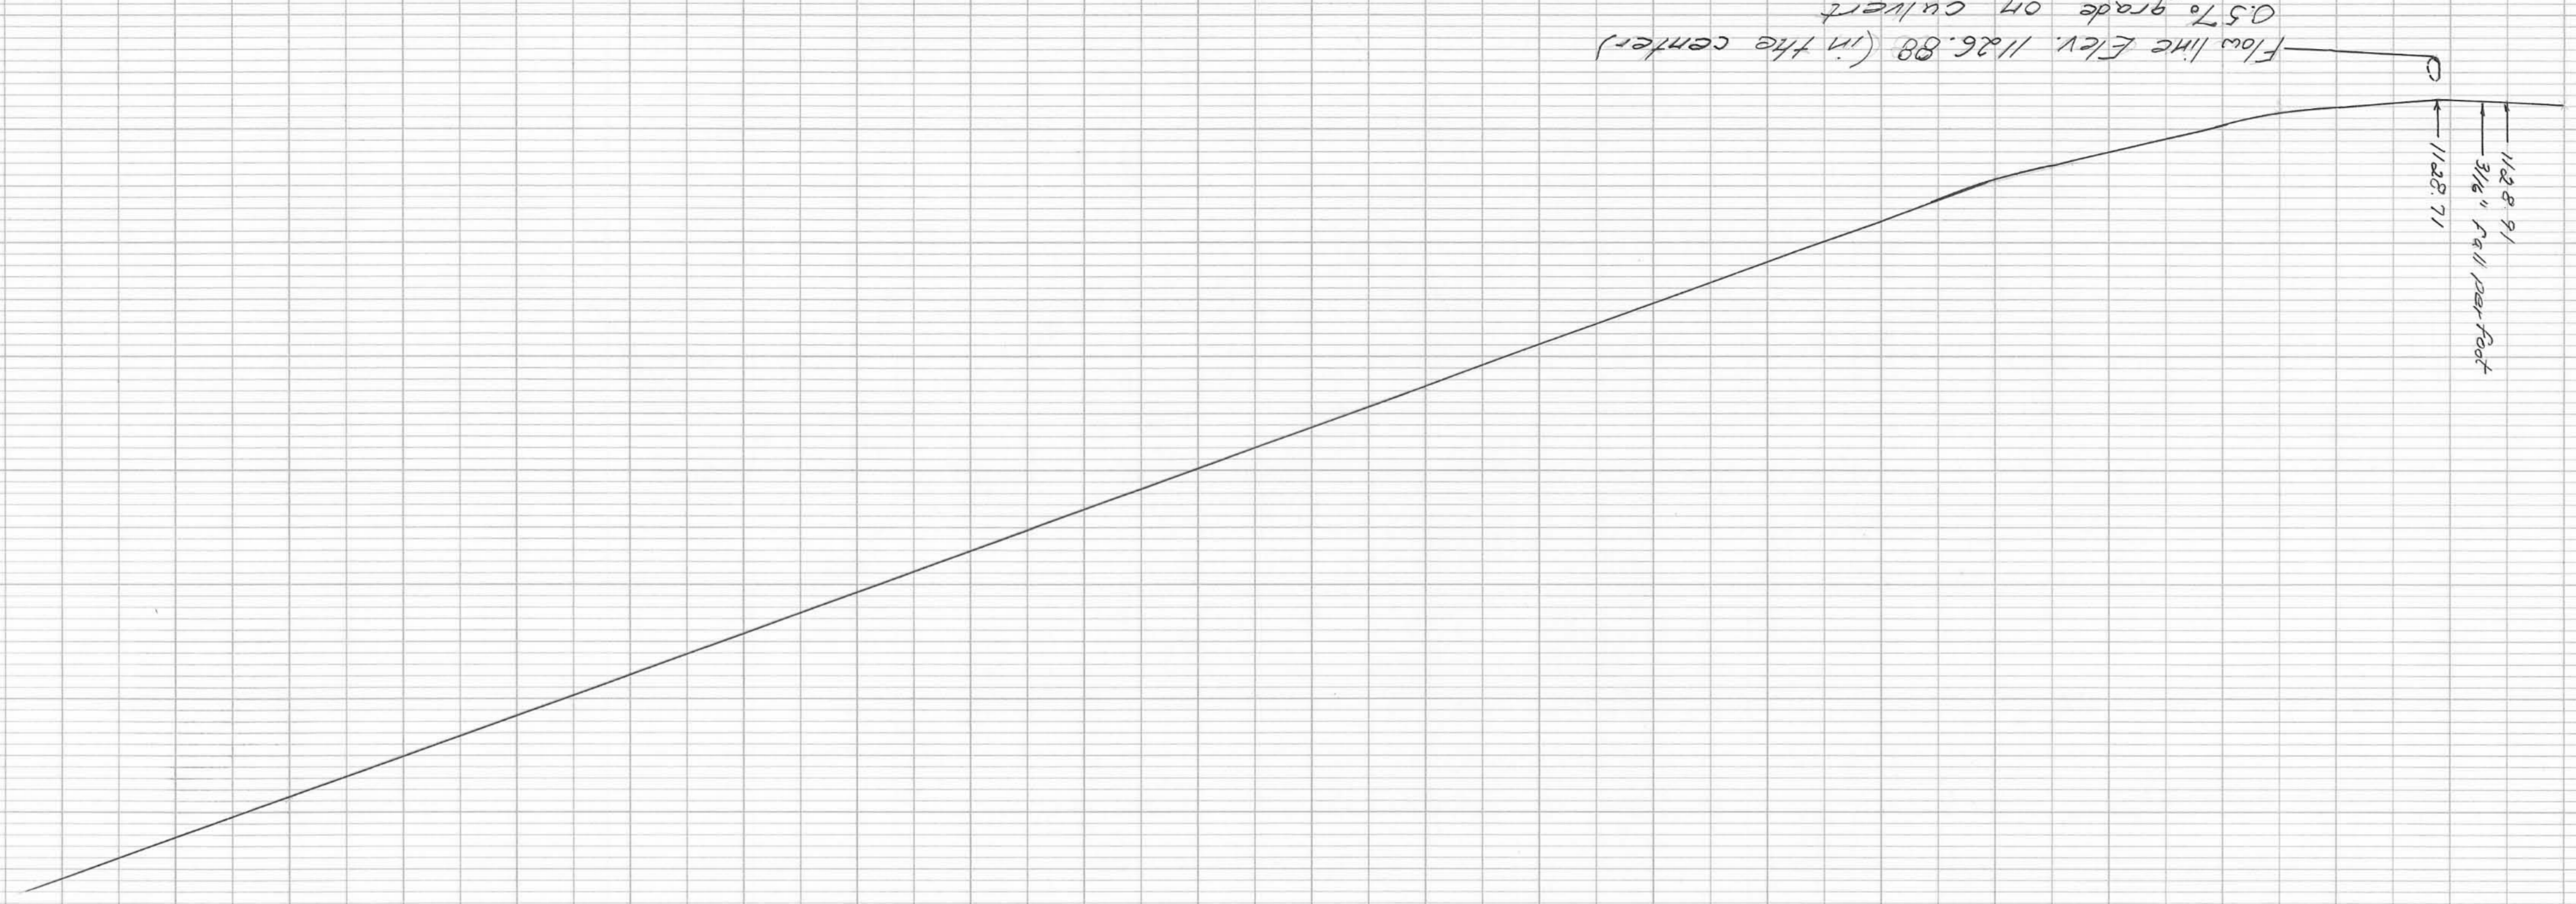

Flow line Elev. 1126.88 (in the center)

1128.91
3/8" fall per foot

1128.71

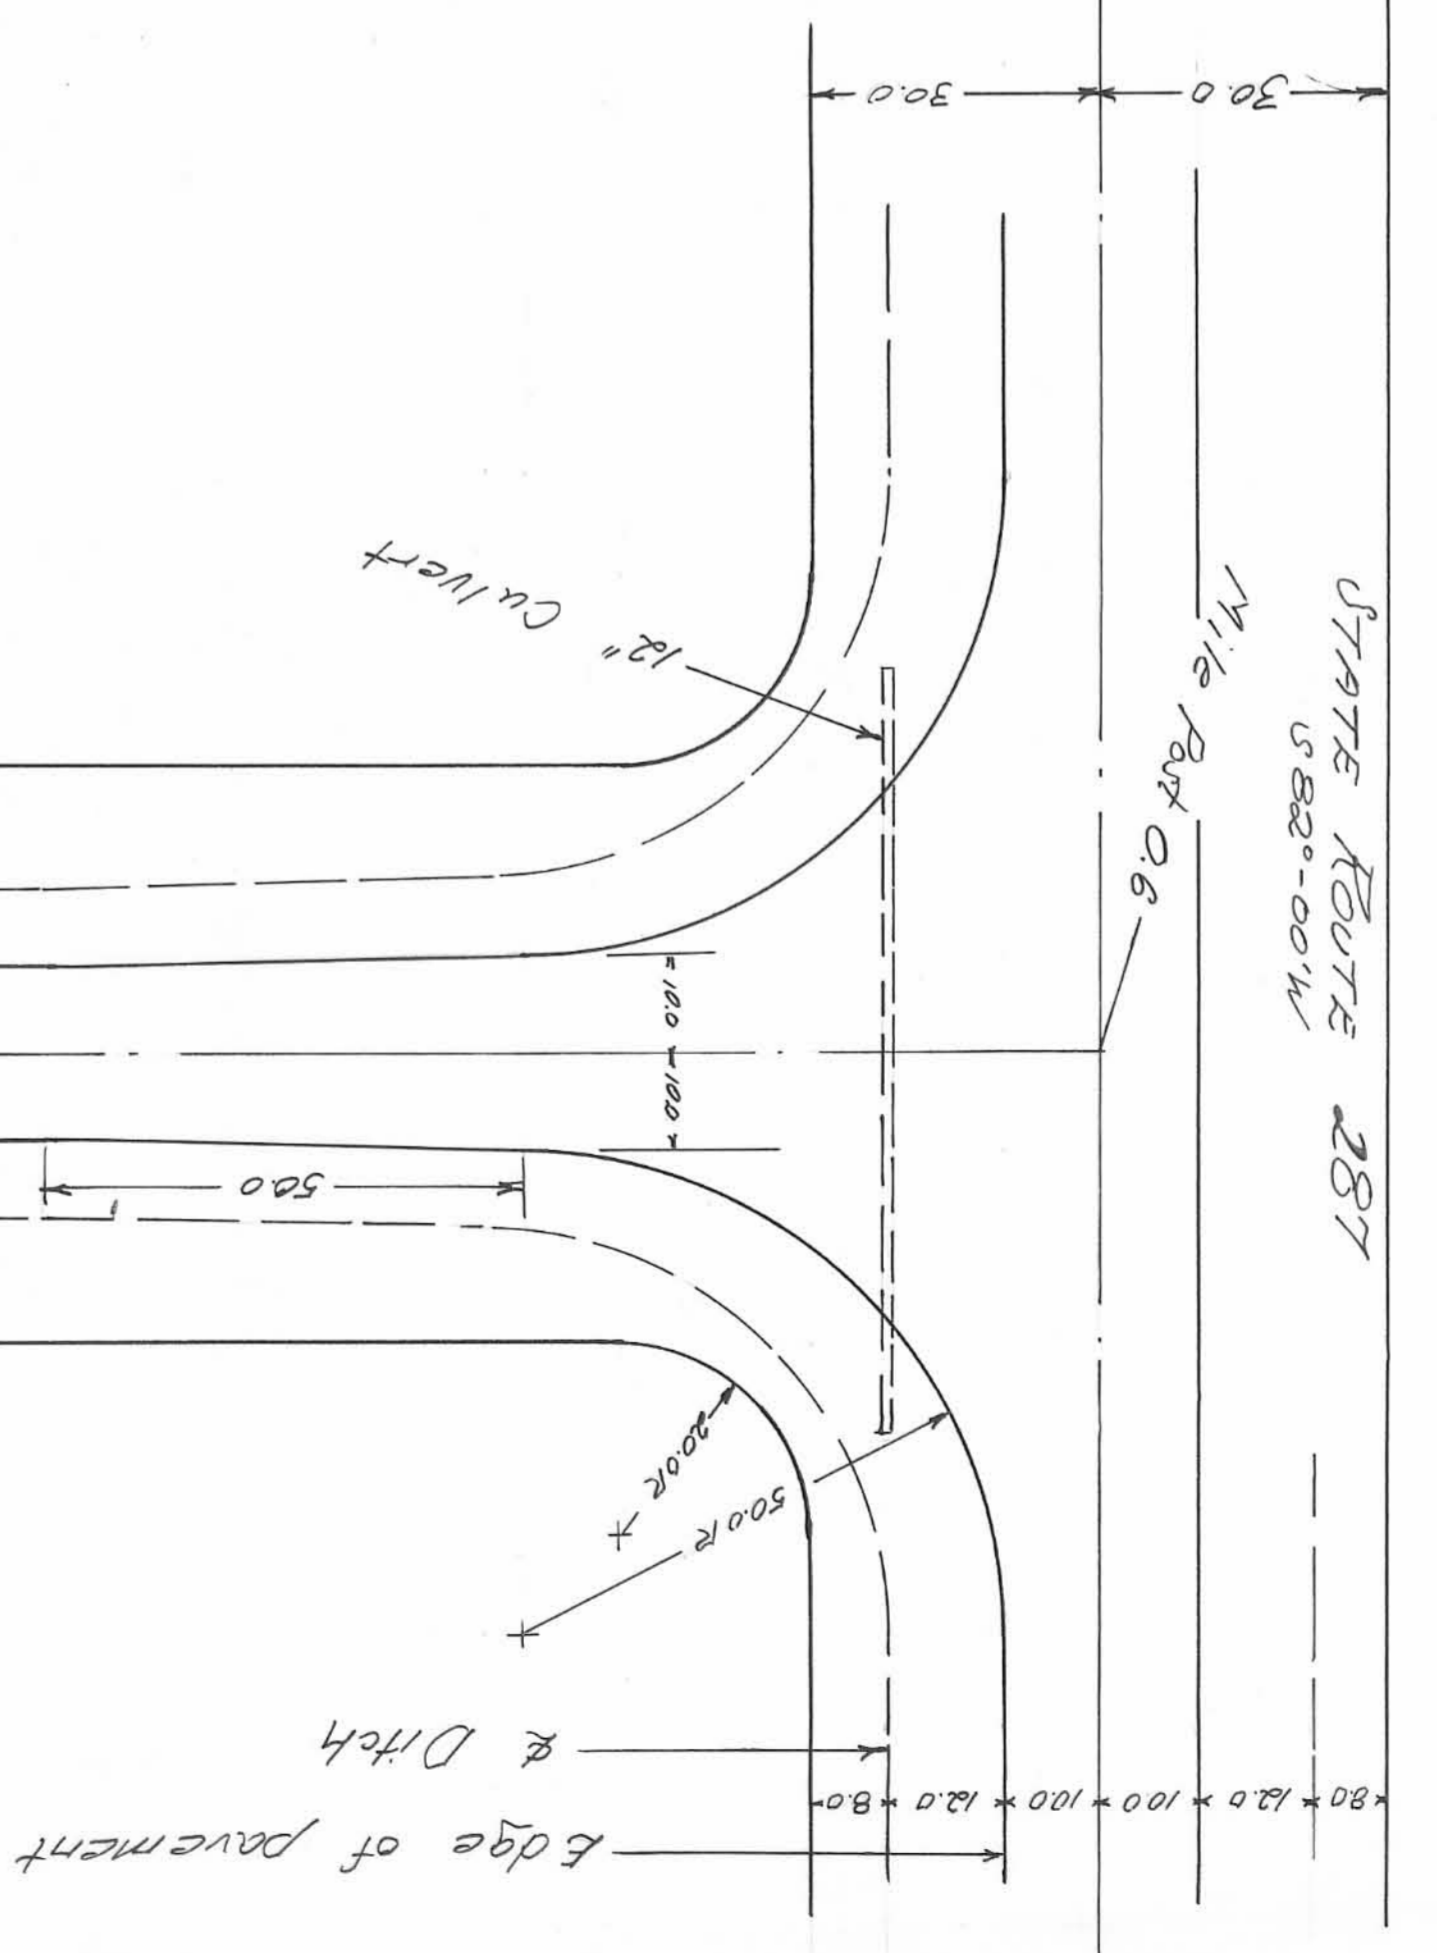

1" = 20'

TECUMSEH ROAD

12" Culvert

STATE ROUTE 287

Mile Post 0.6

30.0

30.0

100

100

58.0

80

80

N 8°-00'W

355.0

60.0

N 16°-03'E

Edge of pavement

& Ditch

500 R



2000 X

Entrance of Tecumseh Road
Monroe Township, Logan Co. Ohio
Surveyed by O.K. Shink, 4271

PROFILE		DATE
SURVEYED	BY	
PLOTTED	DATE	
ALIGNED	NO.	
CHECKED	BY	
STRUCTURE	NO.	

PLAN		DATE
SURVEYED	BY	
PLOTTED	DATE	
ALIGNED	NO.	
CHECKED	BY	
STRUCTURE	NO.	

1180
1130
1140
1150

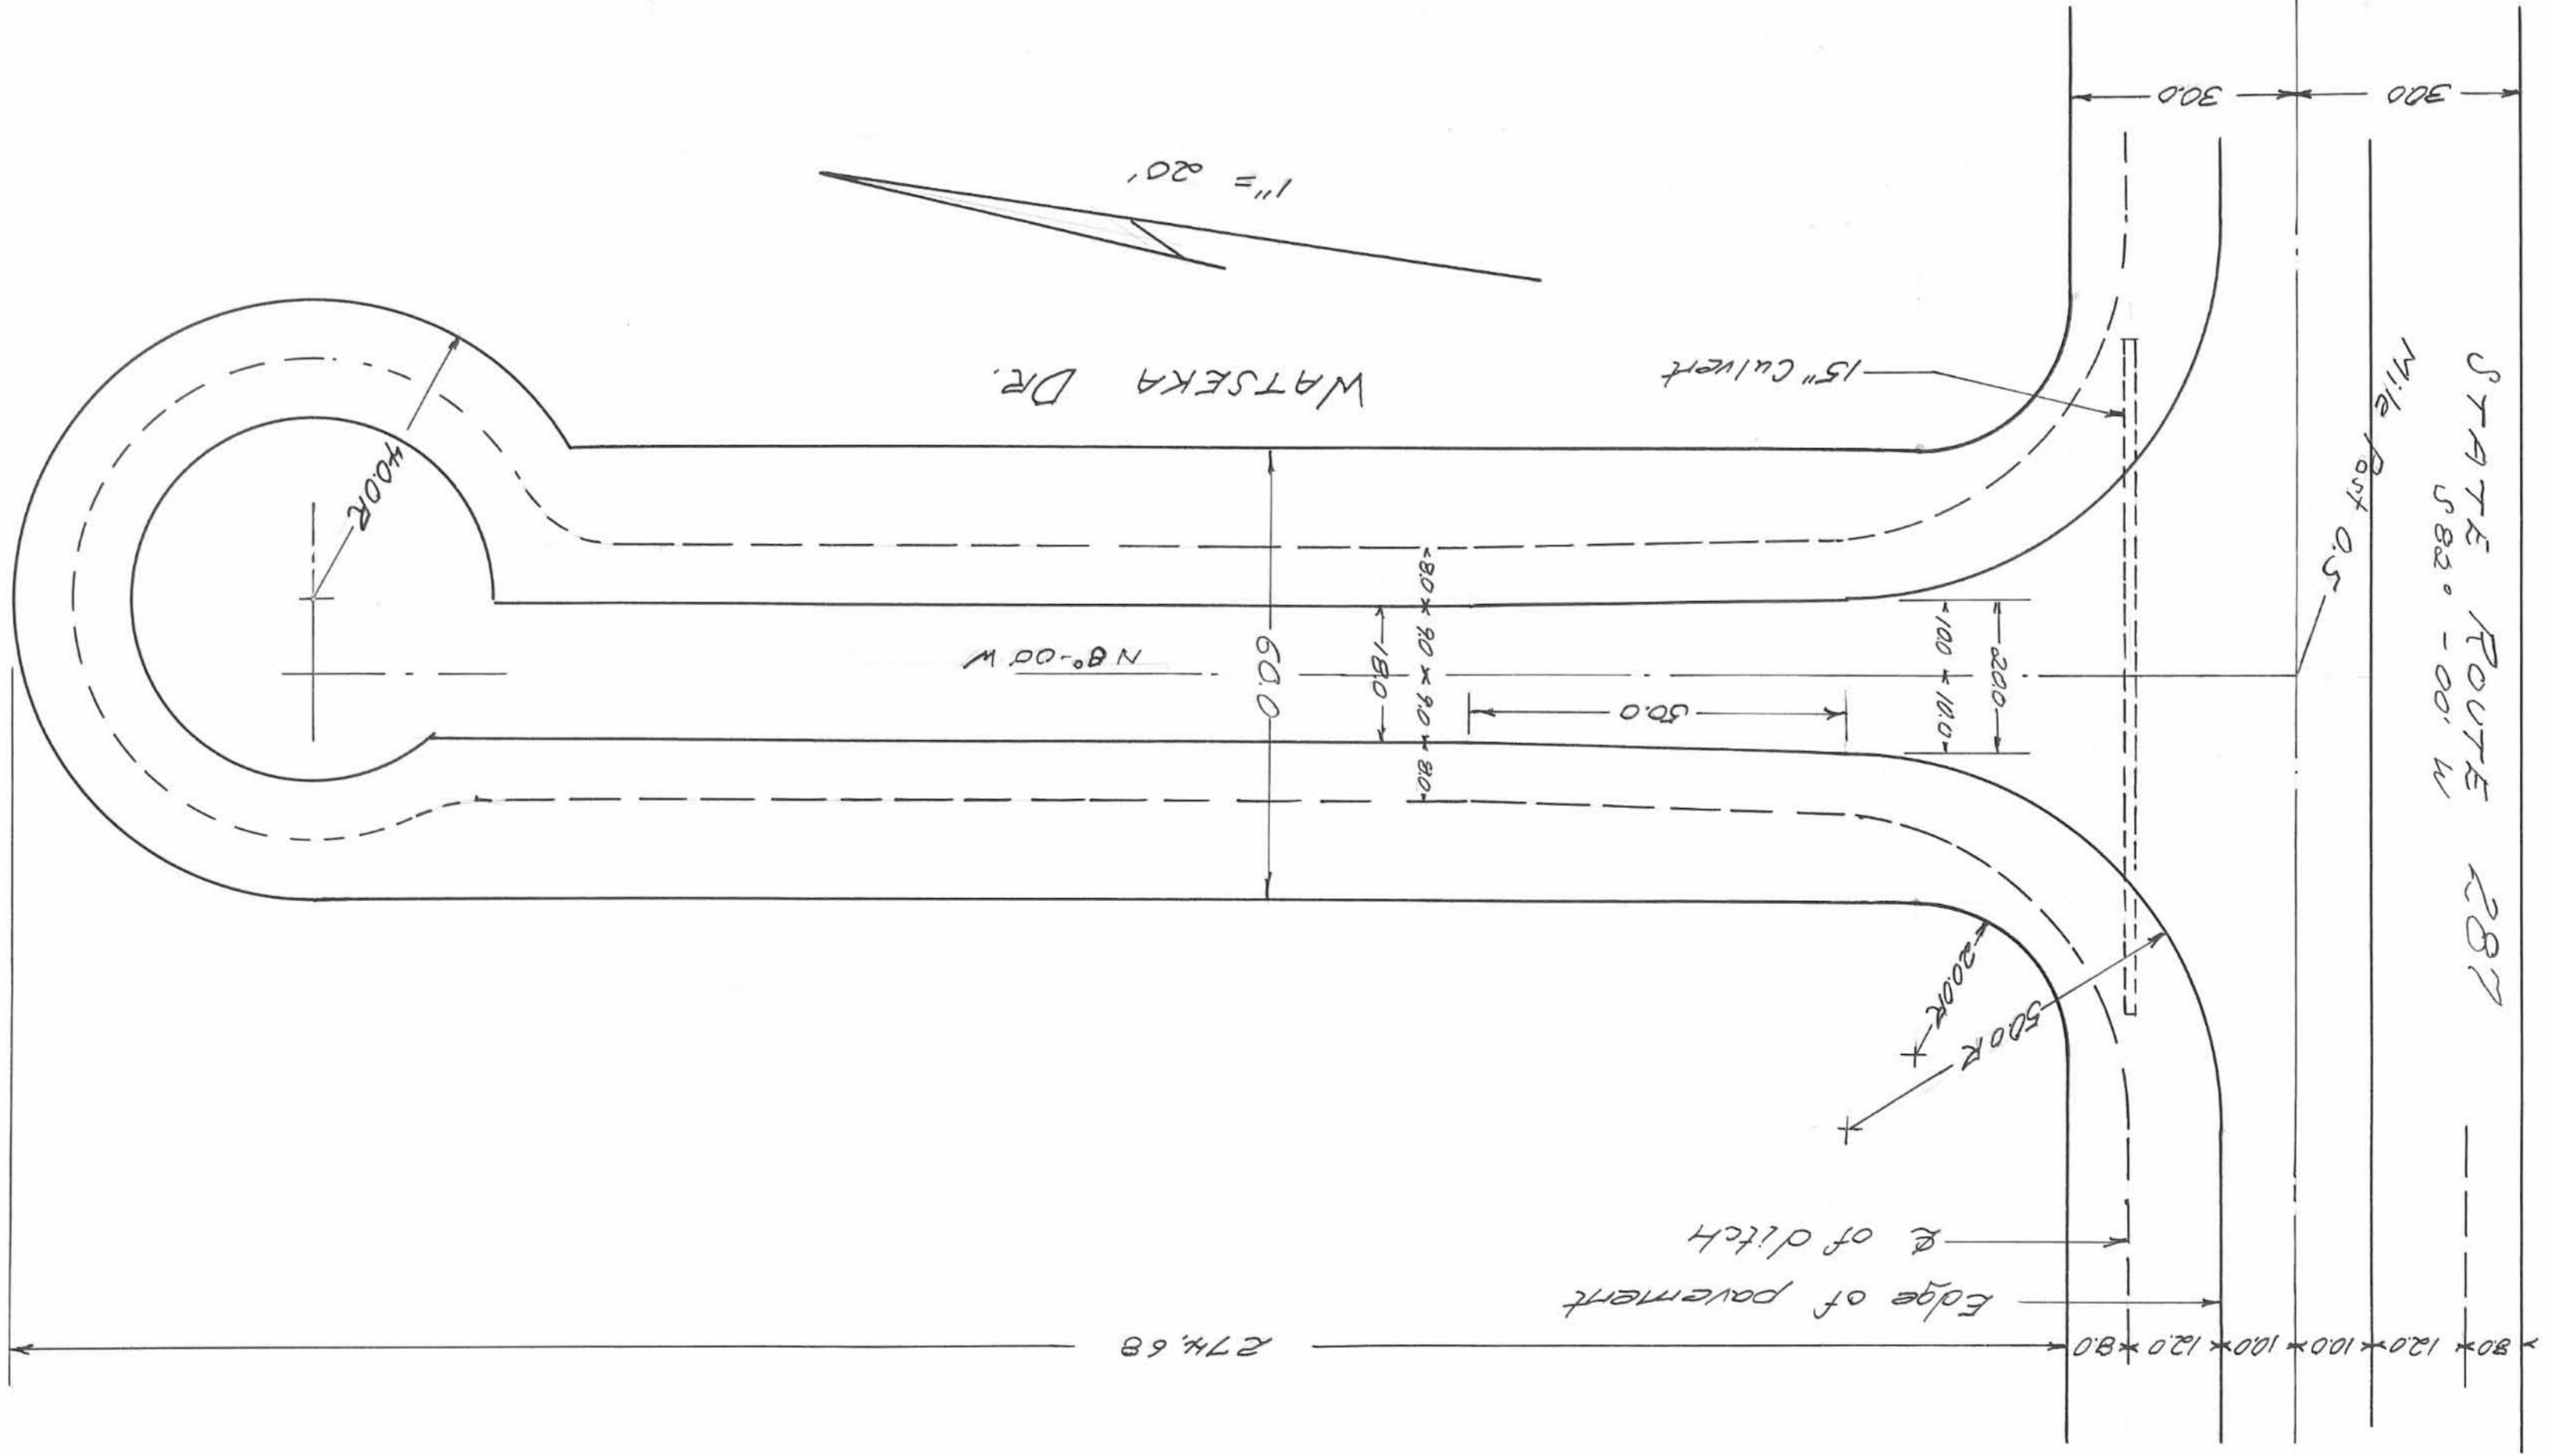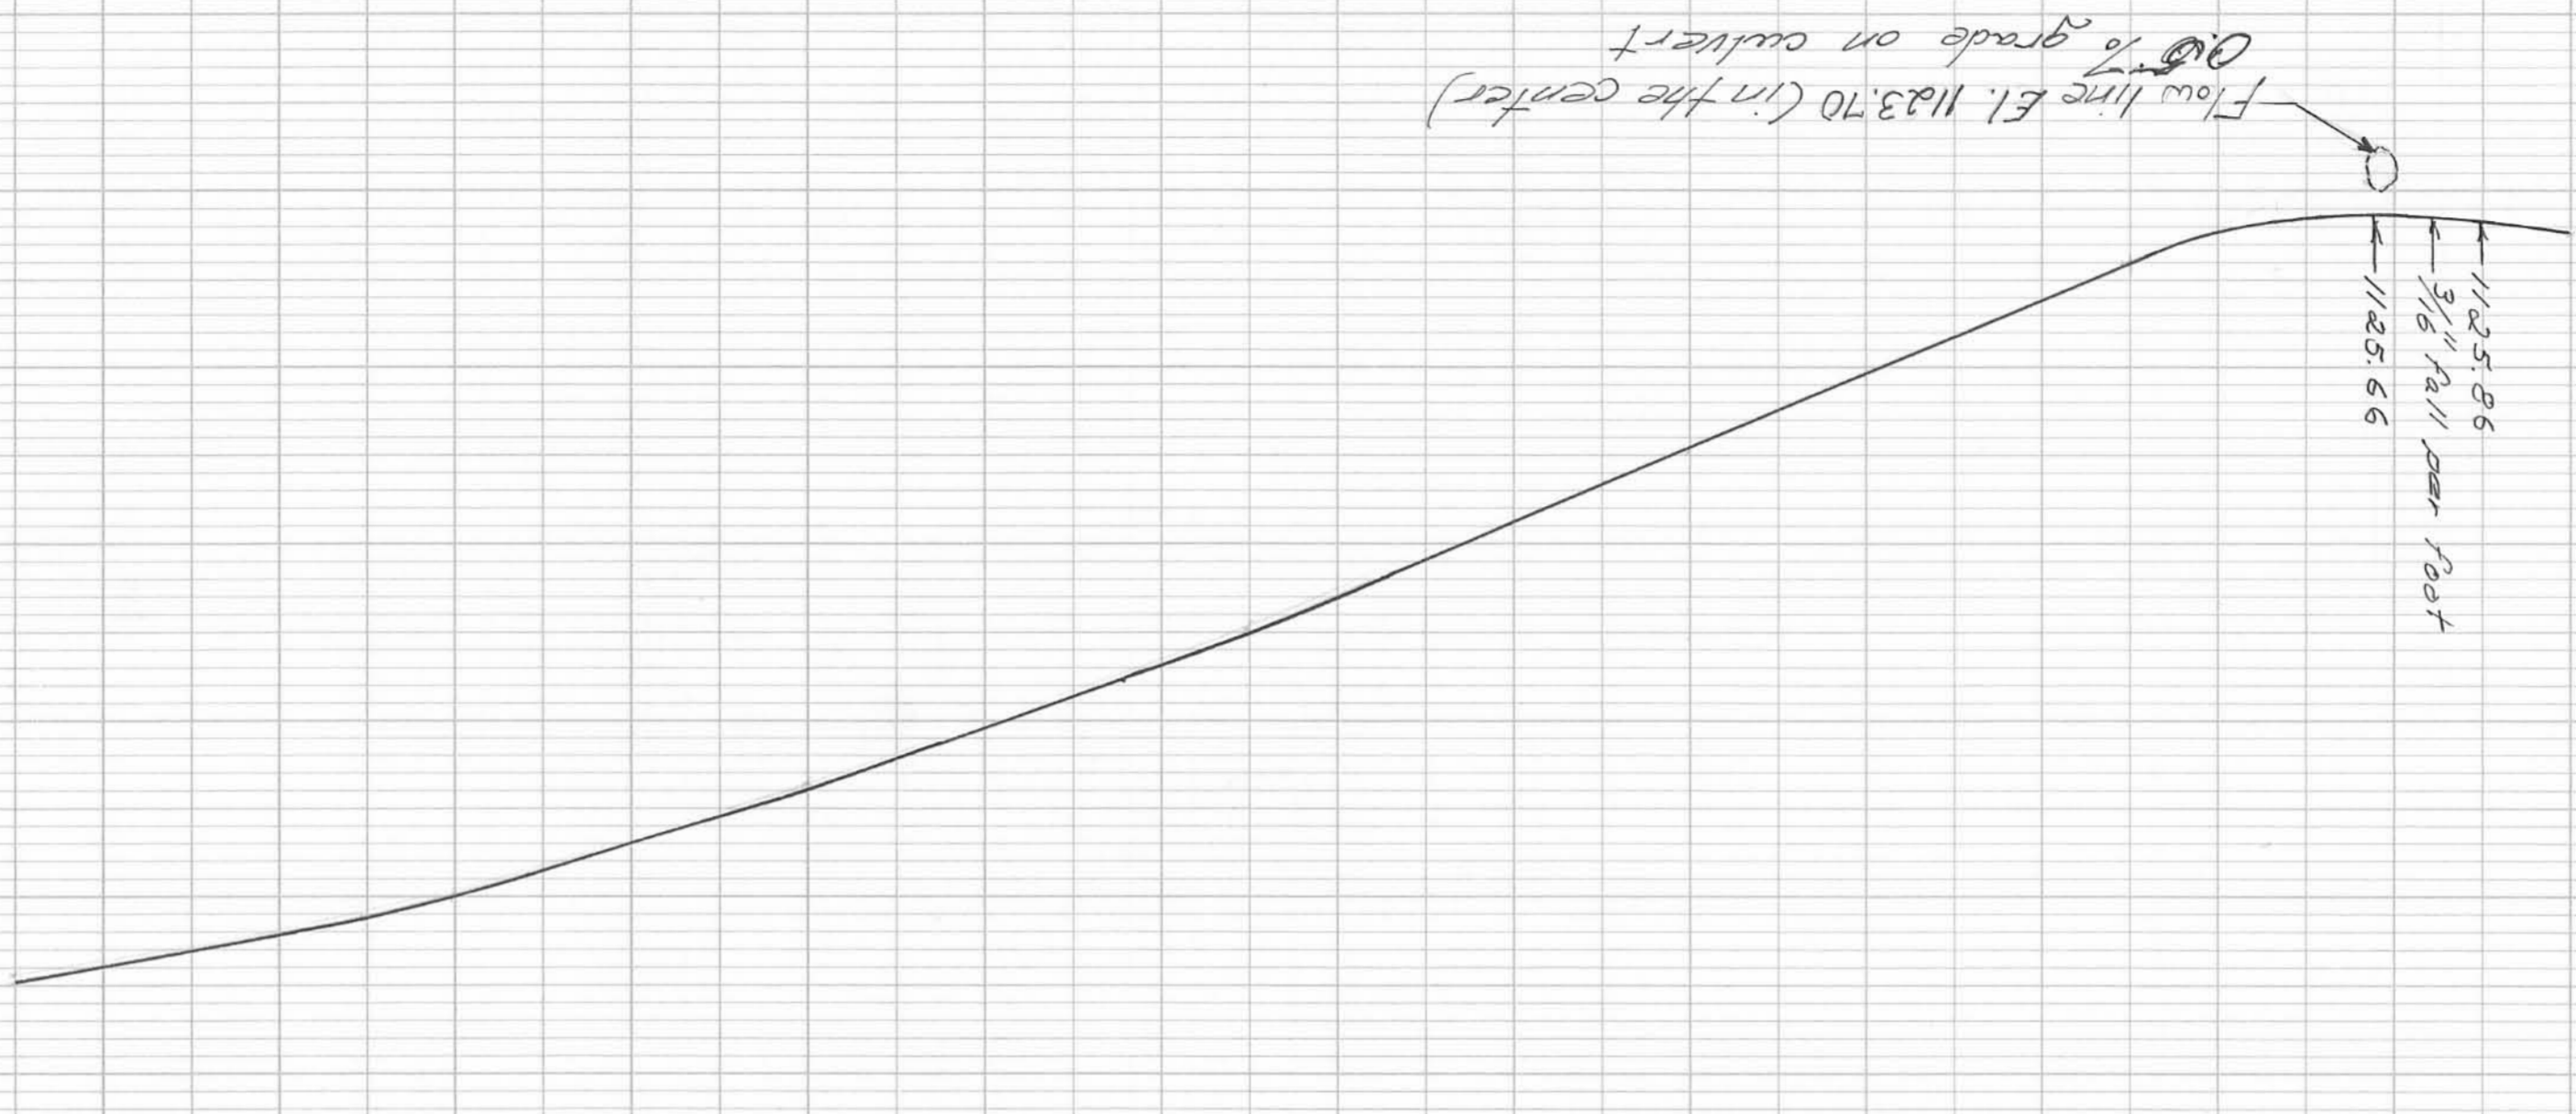

Entrance of Watsseka Dr.
Montee Twp, Logan Co., Ohio
Surveyed by O.K. Shirk, 4271

