



HARBOURSIDE ON THE LAGOON CONDOMINIUMS

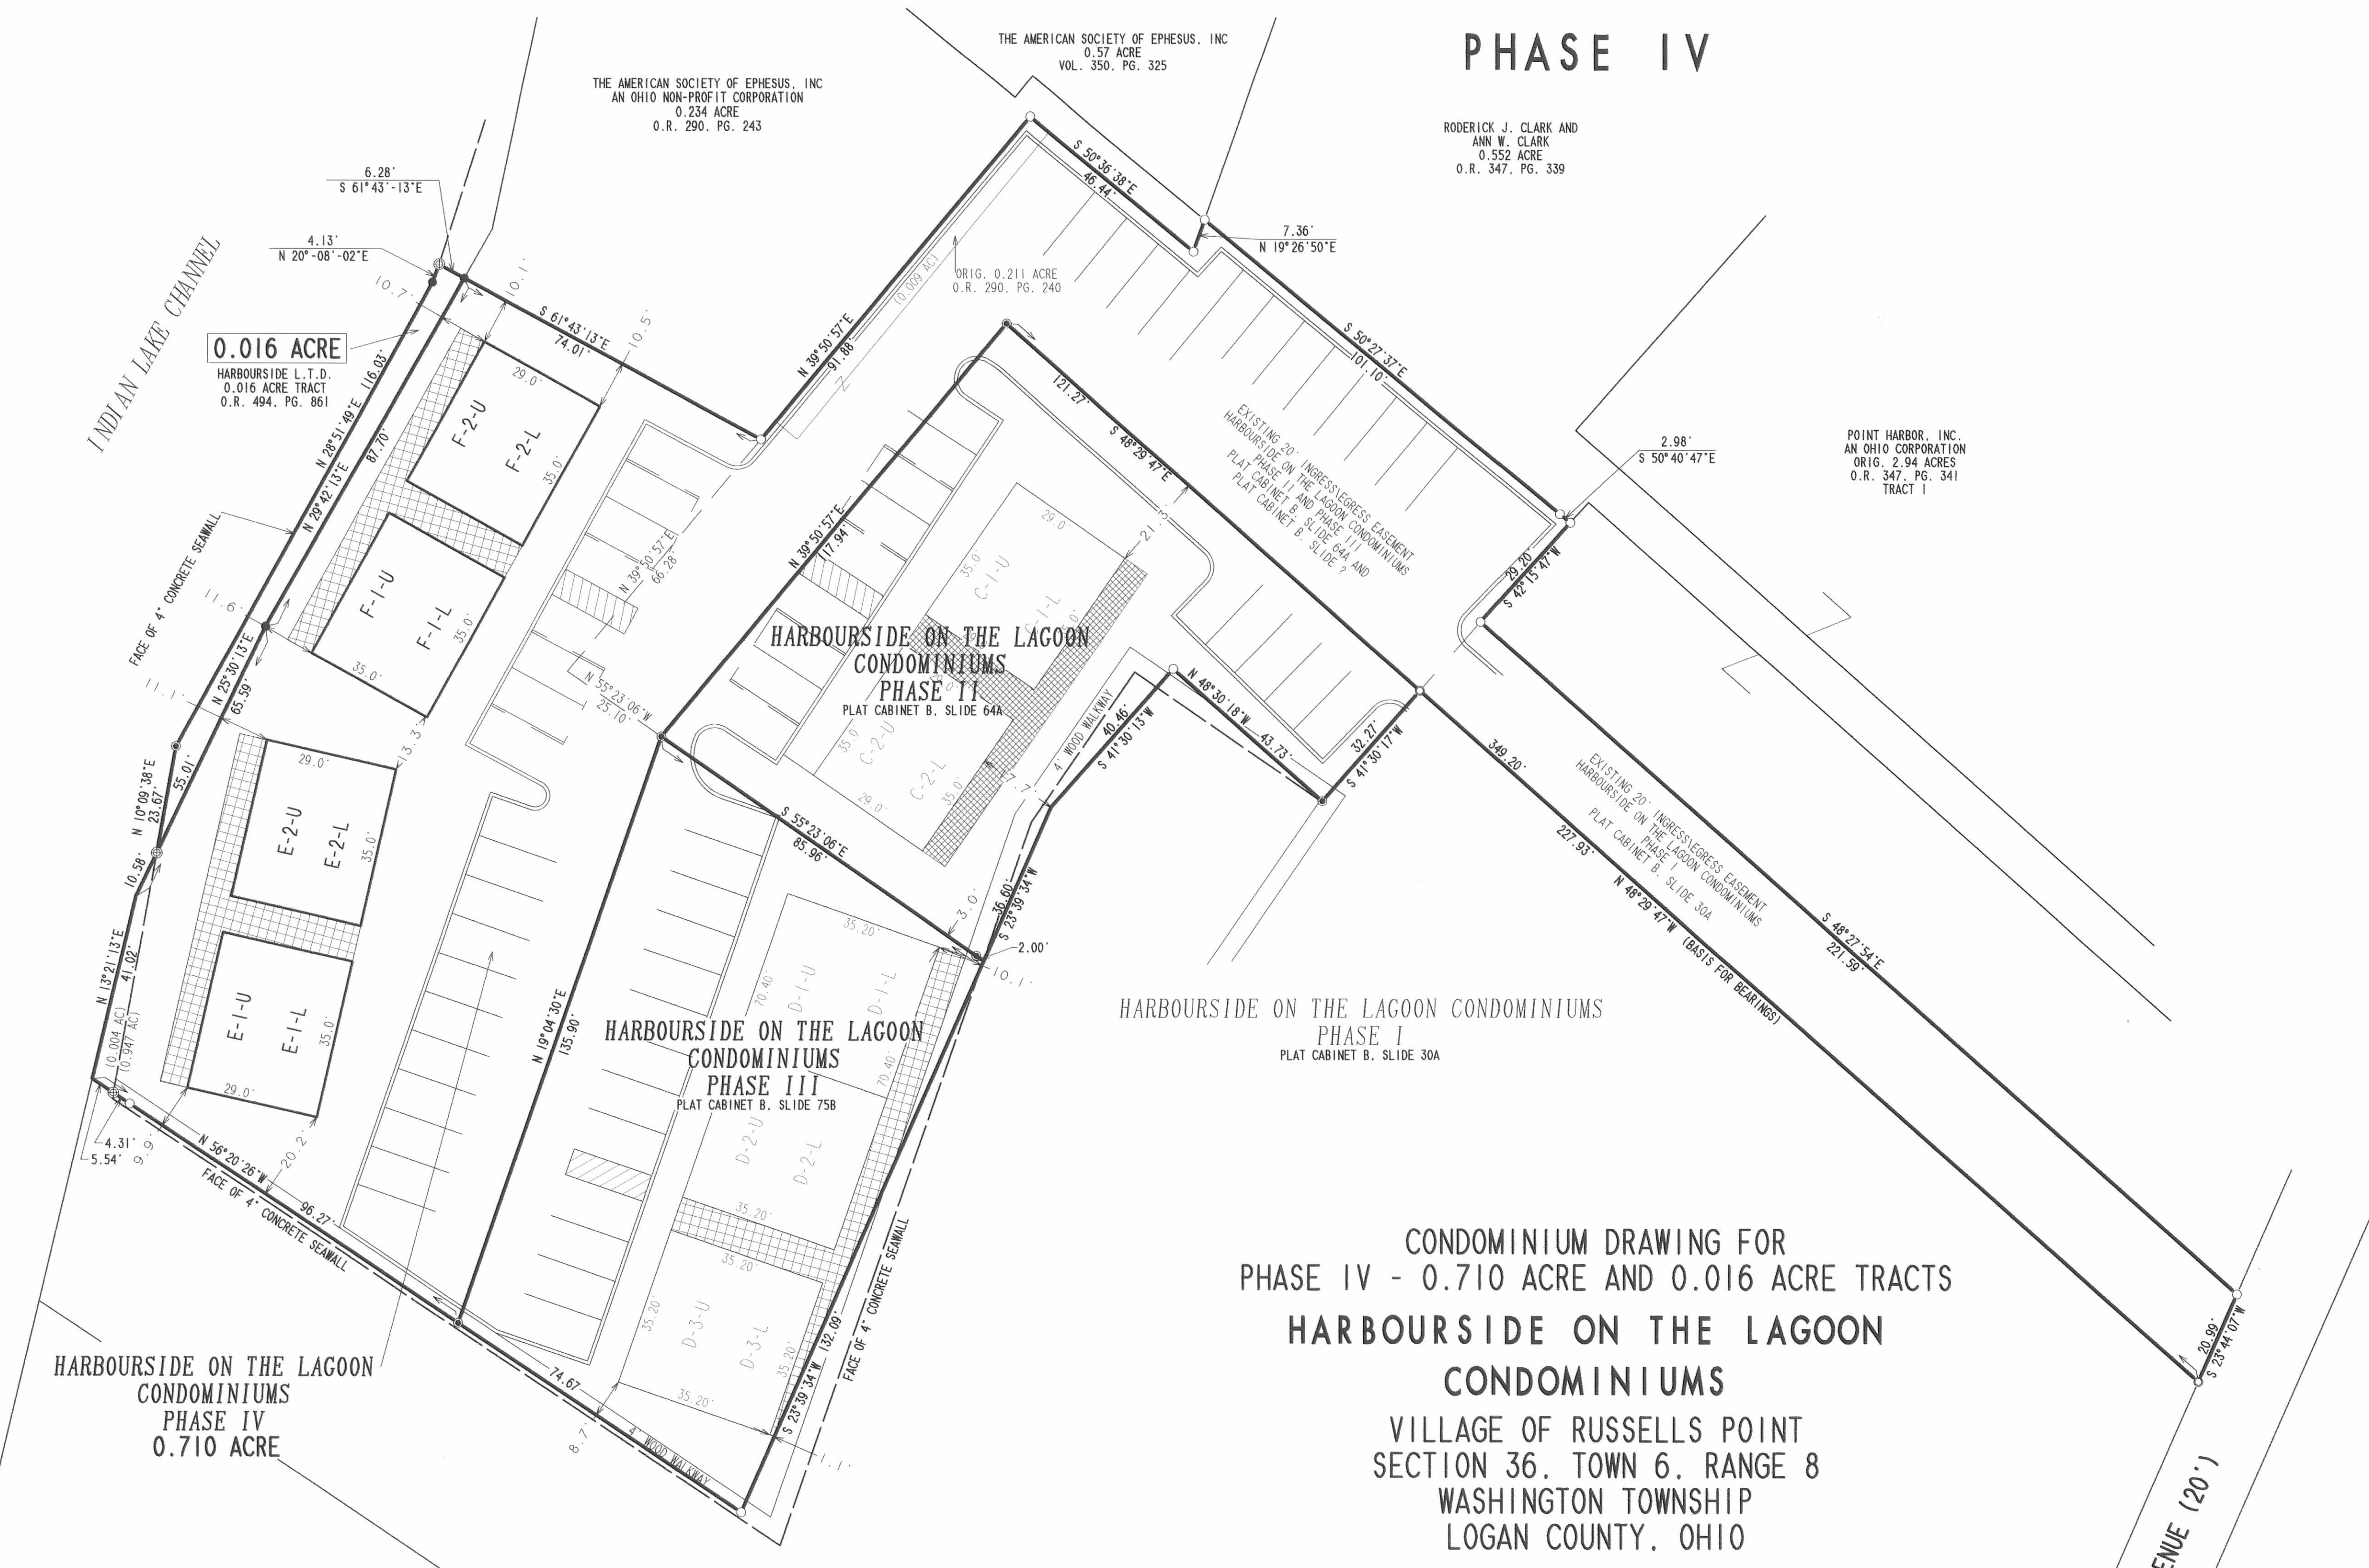

PHASE IV

CONDOMINIUM DRAWING FOR
 PHASE IV - 0.710 ACRE AND 0.016 ACRE TRACTS
**HARBOURSIDE ON THE LAGOON
 CONDOMINIUMS**
 VILLAGE OF RUSSELLS POINT
 SECTION 36, TOWN 6, RANGE 8
 WASHINGTON TOWNSHIP
 LOGAN COUNTY, OHIO

PART OF THE
 INDIAN LAKE HARBOURSIDE LIMITED PARTNERSHIP
 AN OHIO LIMITED PARTNERSHIP
 ORIGINAL 7.424 ACRES
 OFFICIAL RECORD 23, PAGE 93
 ALL OF THE ORIGINAL 0.211 ACRE
 OFFICIAL RECORD 290, PAGE 240
 AND ALL OF THE ORIGINAL 0.016 ACRE
 OFFICIAL RECORD 494, PAGE 861

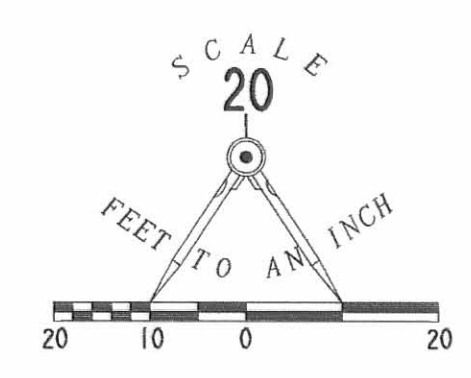

- LEGEND**
- 5/8 INCH IRON ROD SET
 - 5/8 INCH IRON ROD FOUND
 - MAG NAIL SET
 - ⊕ CHISELED 'X' IN CONCRETE SET
 - DRILL HOLE IN CONCRETE FOUND
 - ▨ LIMITED COMMON AREA

APPROVED BY THE RUSSELLS POINT PLANNING COMMISSION
 THIS _____ DAY OF _____, 2003.

CHAIRMAN, RUSSELLS POINT PLANNING COMMISSION

PLAT CHECKED Jon L. Wins 4-2-03
 DESCRIPTION CHECKED Jon L. Wins 4-2-03

TRANSFERRED THIS 3rd DAY OF April, 2003.

Michael E. Godwin
 AUDITOR, LOGAN COUNTY, OHIO
 RECORDED IN PLAT CABINET B, SLIDE 82A-83A
 RECEIVED FOR RECORD AT 11:01 O'CLOCK A.M.
 THIS 3rd DAY OF April, 2003.
Linda Hanson
 RECORDER, LOGAN COUNTY, OHIO

20030003674

INDIAN LAKE SANITARY SEWER DISTRICT

WE DO HEREBY STATE THAT THESE DRAWINGS OF HARBOURSIDE ON THE LAGOON CONDOMINIUMS, PHASE IV SHOW ALL BUILDINGS AS CONSTRUCTED.

Michael W. Bow
 MICHAEL W. BOW
 PROFESSIONAL SURVEYOR 38860
 JANUARY 30, 2003

Jeffrey I. Lee
 JEFFREY I. LEE
 PROFESSIONAL SURVEYOR 6359
 JANUARY 30, 2003



THE M & K ENGINEERING CO.
 1691 T.R. 31 NORTH
 BELLEFONTAINE, OHIO 43311
 (937) 592-2697

LEE SURVEYING AND MAPPING CO., INC.
 117 NORTH MADRIVER STREET
 BELLEFONTAINE, OHIO, 43311
 (937) 593-7335



2 WORKING DAYS
BEFORE YOU DIG
 CALL TOLL FREE **800-362-2764**
 OHIO UTILITIES PROTECTION SERVICE.

COPYRIGHT 2003 BY:
LEE SURVEYING & MAPPING CO., INC.
 117 North Madriver Street
 BELLEFONTAINE, OHIO 43311
 (937) 593-7335
 D-396 HRBRSD4 HRBRSD.DAT L-1134-1

J-294 C