


- LEGEND**
- 5/8" IRON ROD SET
  - 5/8" IRON ROD FOUND
  - ⊙ MAG NAIL SET
  - ⊗ RAILROAD SPIKE FOUND
  - 12A UNIT NUMBER
  - ▨ LIMITED COMMON AREA
  - ALL AREAS AND IMPROVEMENTS NOT LABELED WITH A UNIT DESIGNATION OR AS LIMITED COMMON AREA ARE COMMON AREA.

**REFERENCES**  
 LOGAN COUNTY ENGINEER'S FILES:  
 PLAT OF INDIAN MEADOWS NO. 2  
 PLAT CABINET B, SLIDE 8A & 82  
 OK SHIRKS BOOK 9, PAGES 43 & 42  
 R-3878

CURVE	DELTA ANGLE	RADIUS	ARC	TANGENT	CHORD	CHORD BEARING
C 1	16°30'00"	60.00'	17.28'	8.70'	17.22'	N 89°12'51"W
C 2	16°30'00"	60.00'	17.28'	8.70'	17.22'	N 89°12'51"W

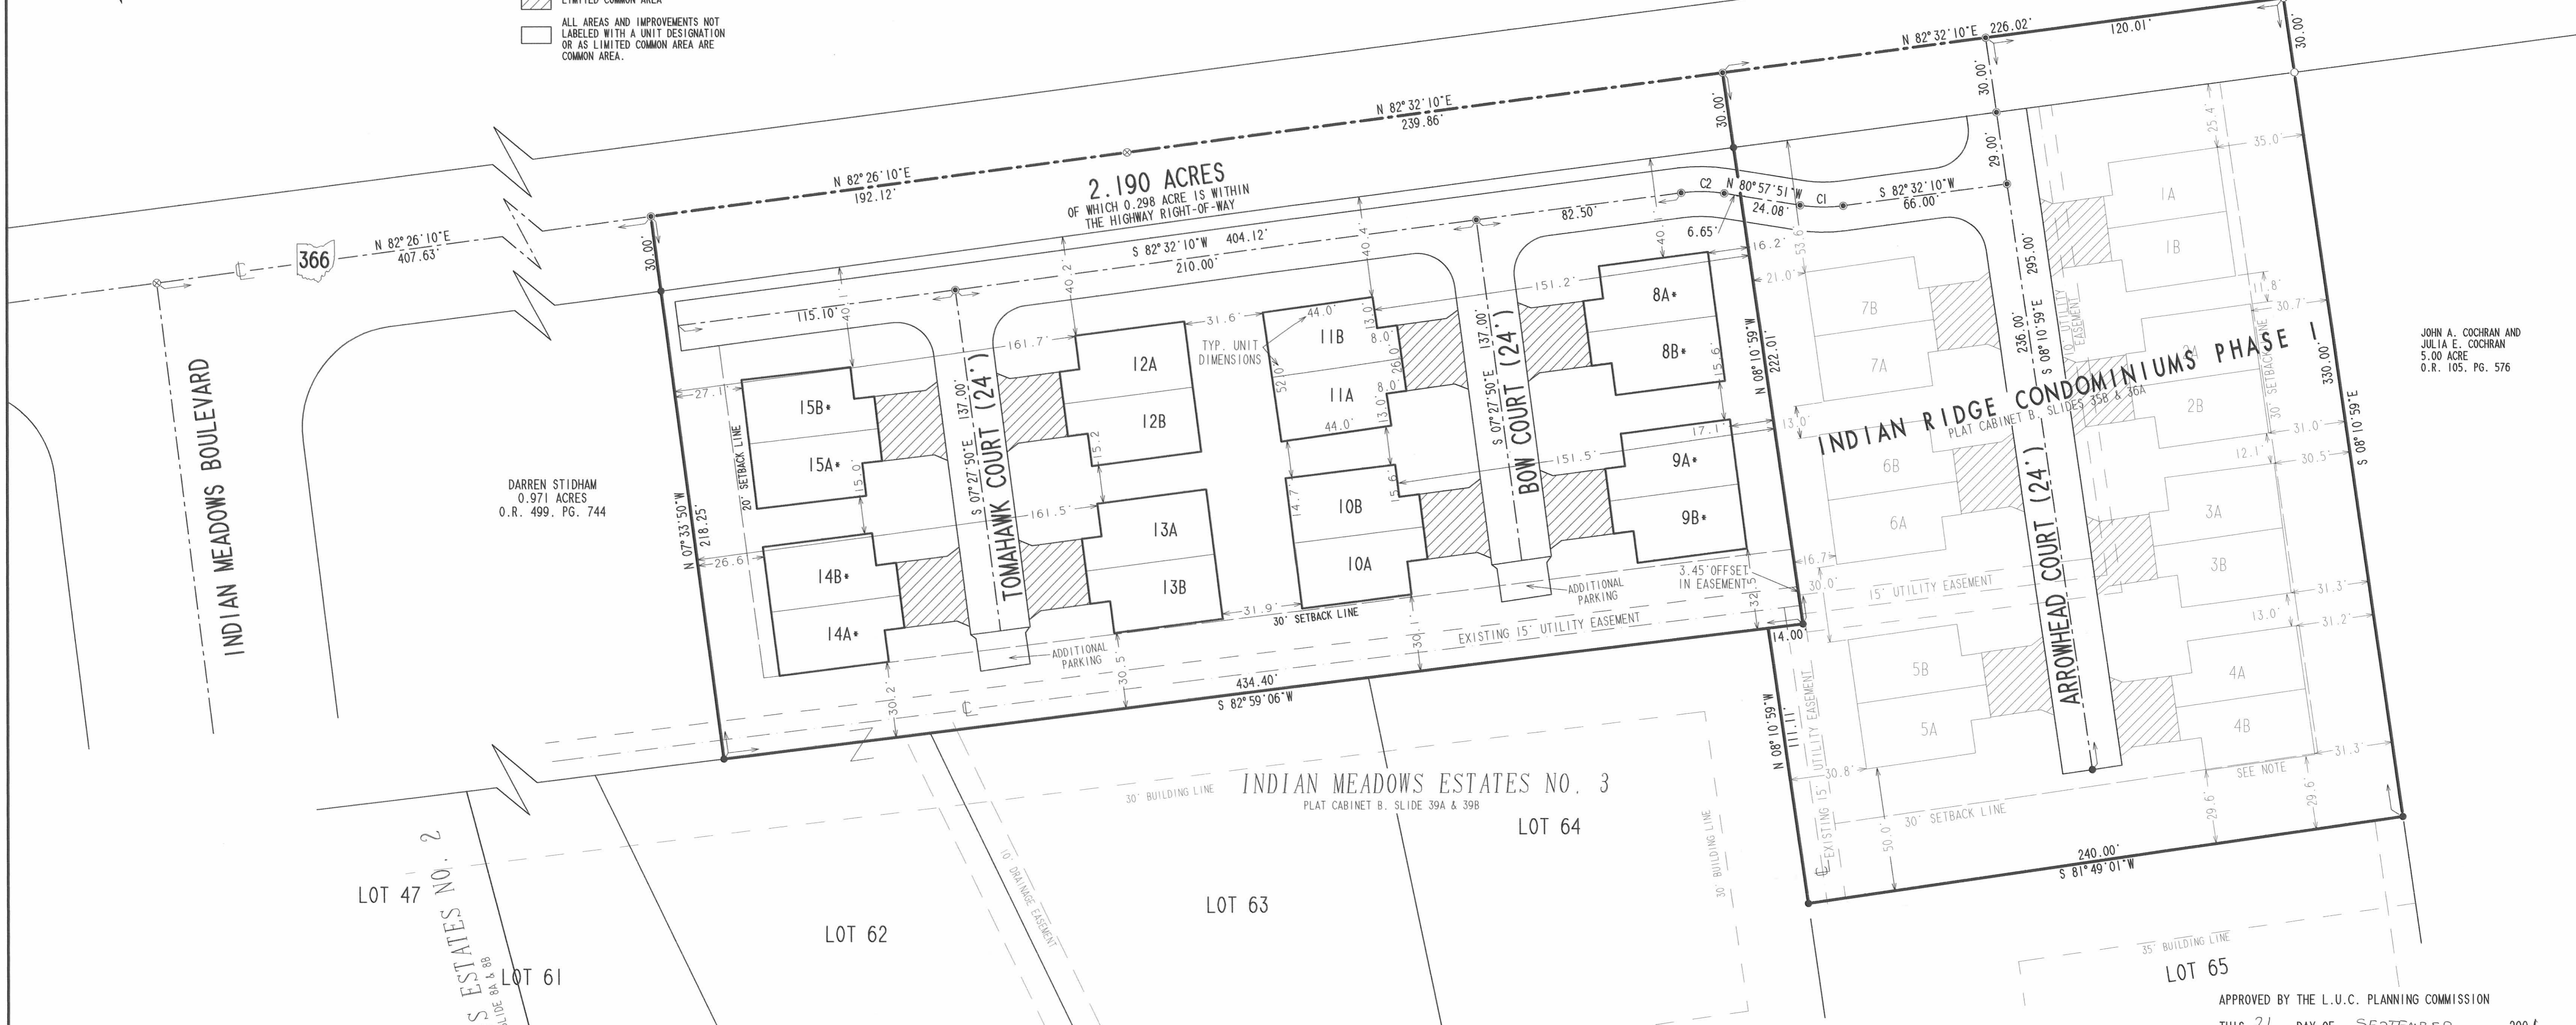

JOHN A. COCHRAN AND  
 JULIA E. COCHRAN  
 5.00 ACRE  
 O.R. 105, PG. 576

DARREN STIDHAM  
 0.971 ACRES  
 O.R. 499, PG. 744

**NOTE:**  
 \* INDICATES THAT AS OF SEPTEMBER 7, 2001, IMPROVEMENTS TO THE UNITS HAVE BEGUN BUT ARE "(NOT YET COMPLETED)".

WE DO HEREBY STATE THAT THIS DRAWING OF INDIAN RIDGE CONDOMINIUM SHOWS ALL BUILDINGS AS CONSTRUCTED.




*Michael W. Bow*  
 MICHAEL W. BOW  
 PROFESSIONAL ENGINEER 38860  
 AUGUST 17, 2001

**THE M & K ENGINEERING CO.**  
 1691 T.R. 31 North  
 BELLEFONTAINE, OHIO 43311  
 (937) 592-2697

*Jeffrey I. Lee*  
 JEFFREY I. LEE  
 PROFESSIONAL SURVEYOR 6359  
 AUGUST 17, 2001

**LEE SURVEYING & MAPPING CO., INC.**  
 117 North Madriver Street  
 BELLEFONTAINE, OHIO 43311  
 (937) 593-7335

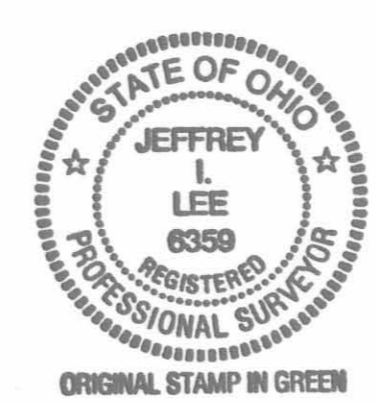

CONDOMINIUM DRAWING FOR  
 PHASE II - 2.190 ACRES  
**INDIAN RIDGE CONDOMINIUMS**  
 VIRGINIA MILITARY SURVEY 9947  
 RICHLAND TOWNSHIP  
 LOGAN COUNTY, OHIO

PART OF THE  
 JAMES DAVID DUFF AND  
 RENEE LORAINE DUFF  
 ORIGINAL 54.391 ACRES  
 OFFICIAL RECORD 225, PAGE 744

APPROVED BY THE L.U.C. PLANNING COMMISSION  
 THIS 21 DAY OF SEPTEMBER, 2001.  
*Gregg A. Harris*  
 DIRECTOR, PLANNING COMMISSION  
 PRE-APPROVAL *Jon C. Hines* 9-7-01  
 PLAT CHECKED *Jon C. Hines* 9-20-01  
 TRANSFERRED THIS 21st DAY OF SEPTEMBER, 2001.  
*Michael E. Anderson*  
 AUDITOR, LOGAN COUNTY, OHIO  
 RECORDED IN PLAT CABINET B, SLIDE 69A & 69B  
 RECEIVED FOR RECORD AT 1:10 pm 0'CLOCK p.m.  
 THIS 21 DAY OF September, 2001.  
*Linda Hanson*  
 RECORDER, LOGAN COUNTY, OHIO

2 WORKING DAYS  
**BEFORE YOU DIG**  
 CALL TOLL FREE 800-362-2764  
 OHIO UTILITIES PROTECTION SERVICE.

J-295A

J-295A



