


PLAT CABINET B SLIDE 124B

PIRATE'S COVE AT INDIAN LAKE CONDOMINIUM PHASE VI

EXHIBIT B TO DECLARATION AND BYLAWS OF

16.752 ACRE TRACT, OFFICIAL RECORD 795, PAGE 858, 0.115 ACRE TRACT, OFFICIAL RECORD 796, PAGE 255
 0.047 ACRE TRACT AND 0.111 ACRE TRACT, OFFICIAL RECORD 1013, PAGE 786, EXHIBIT A-1 AND A-2
 VIRGINIA MILITARY SURVEYS 10121, 9946 AND 9925
 WASHINGTON TOWNSHIP, LOGAN COUNTY, OHIO

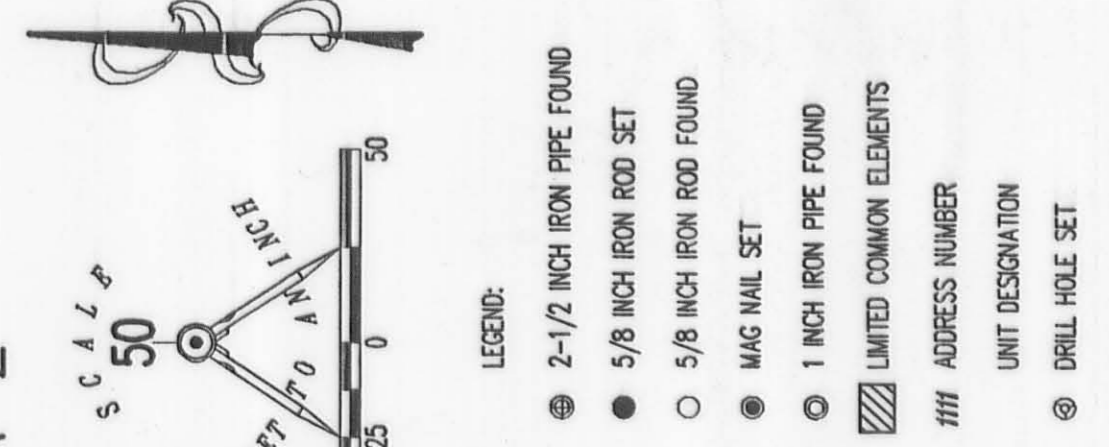

CURVE	DELTA ANGLE	RADIUS	ARC LENGTH	CHORD BEARING	CHORD LENGTH
C1	54°21'40"	30.00'	28.46'	S 54°19'44" W	27.41'
C2	34°05'33"	30.00'	17.85'	S 10°06'00" W	17.59'
C3	90°00'00"	30.00'	47.12'	S 91°56'36" E	42.43'
C4	90°00'00"	35.00'	54.98'	S 91°56'36" E	49.50'
C5	28°46'59"	124.00'	62.29'	N 07°39'17" E	61.64'
C6	12°15'16"	100.00'	21.39'	N 15°55'09" E	21.35'
C7	90°00'00"	20.00'	31.94'	N 91°56'36" W	28.28'
C8	61°02'35"	100.00'	50.24'	S 52°33'04" W	30.46'
C9	28°46'59"	100.00'	78.72'	S 07°39'17" W	49.71'
C10	90°12'26"	50.00'	39.22'	S 91°50'25" E	70.84'
C11	45°00'00"	49.83'	39.22'	S 60°33'22" W	38.22'
C12	45°00'00"	49.83'	39.22'	S 15°33'22" W	38.22'
C13	90°00'00"	28.86'	45.45'	S 91°56'36" E	40.95'

SURVEYOR'S CERTIFICATION:
 THE DRAWINGS ACCURATELY REFLECT THE LOCATION OF IMPROVEMENTS AND RECORDED EASEMENTS.

William K. Bane
 WILLIAM K. BANE
 PROFESSIONAL SURVEYOR 7437
 SEPTEMBER 27, 2010

COPYRIGHT 2010 BY:
 LEE SURVEYING & ENGINEERING CO., INC.
 117 North Redfield Street
 Bellefontaine, OH 43111
 (615) 593-7335

ARCHITECT'S CERTIFICATION:
 THE DRAWINGS ACCURATELY SHOW EACH BUILDING AS-BUILT OR CONSTRUCTED.

Alexander Luque
 ALEXANDER LUQUE
 PROFESSIONAL ARCHITECT OHIO 5382
 SEPTEMBER 27, 2010



PRE-APPROVAL *Ernyue M. Vesty* 12-10-10
 PLAT CHECKED *Ernyue M. Vesty* 12-10-10
 TRANSFERRED THIS 10th DAY OF December, 2010
Michael E. Fotel
 AUDITOR, LOGAN COUNTY, OHIO
 RECORDED IN PLAT CABINET B, SLIDE 124B
 RECEIVED FOR RECORD AT 12:07 O'CLOCK P.M.
 THIS 10th DAY OF December, 2010
Leslie S. Hanson
 RECORDER, LOGAN COUNTY, OHIO

- NOTES:**
- EASEMENTS IF SHOWN ARE AS PROVIDED BY DEVELOPER. THE SURVEYOR DID NOT SEARCH FOR ADDITIONAL EASEMENTS.
 - THE WORD "CERTIFY" IS INTENDED TO BE AS DEFINED IN OHIO ADMINISTRATIVE CODE 4733-35-04(C).
 - BUILDING HEIGHT FROM PEAK OF ROOF TO GROUND:
 BUILDING 10 IS 30.5'
 BUILDING 11 IS 30.5'

2 WORKING DAYS
BEFORE YOU DIG
 CALL TOLL FREE 800-362-2764
 AND INCLUDE PROJECT NUMBER.

