



S.R. 275-245  
0.0 to 0.87

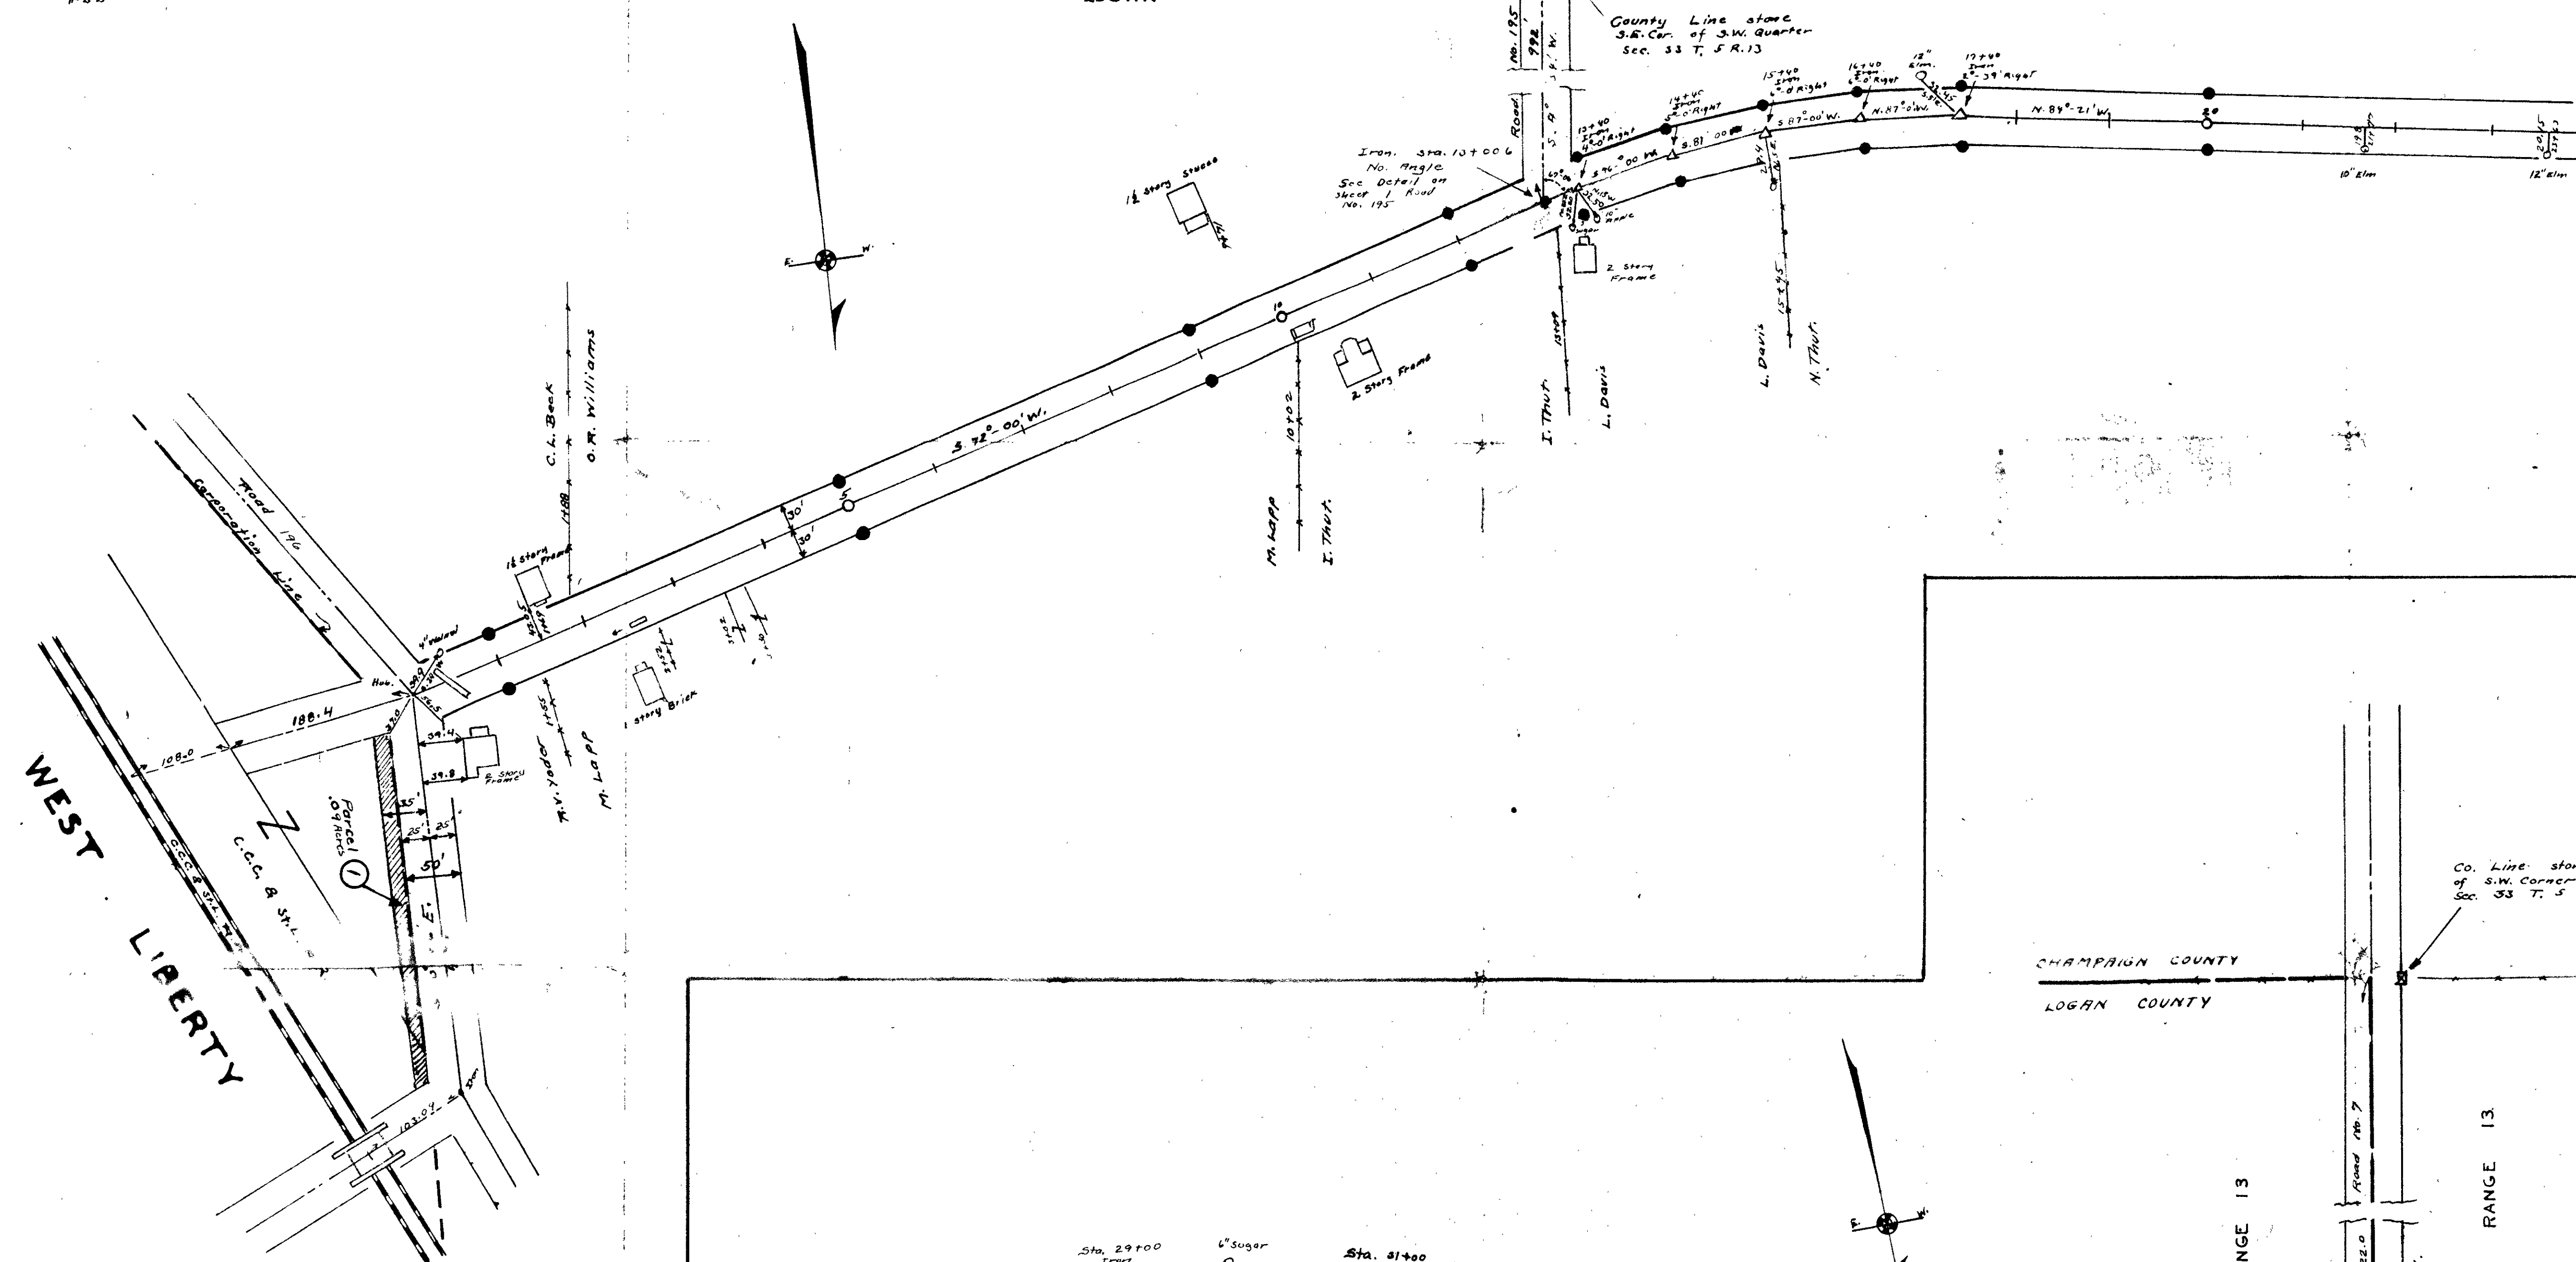

WEST LIBERTY

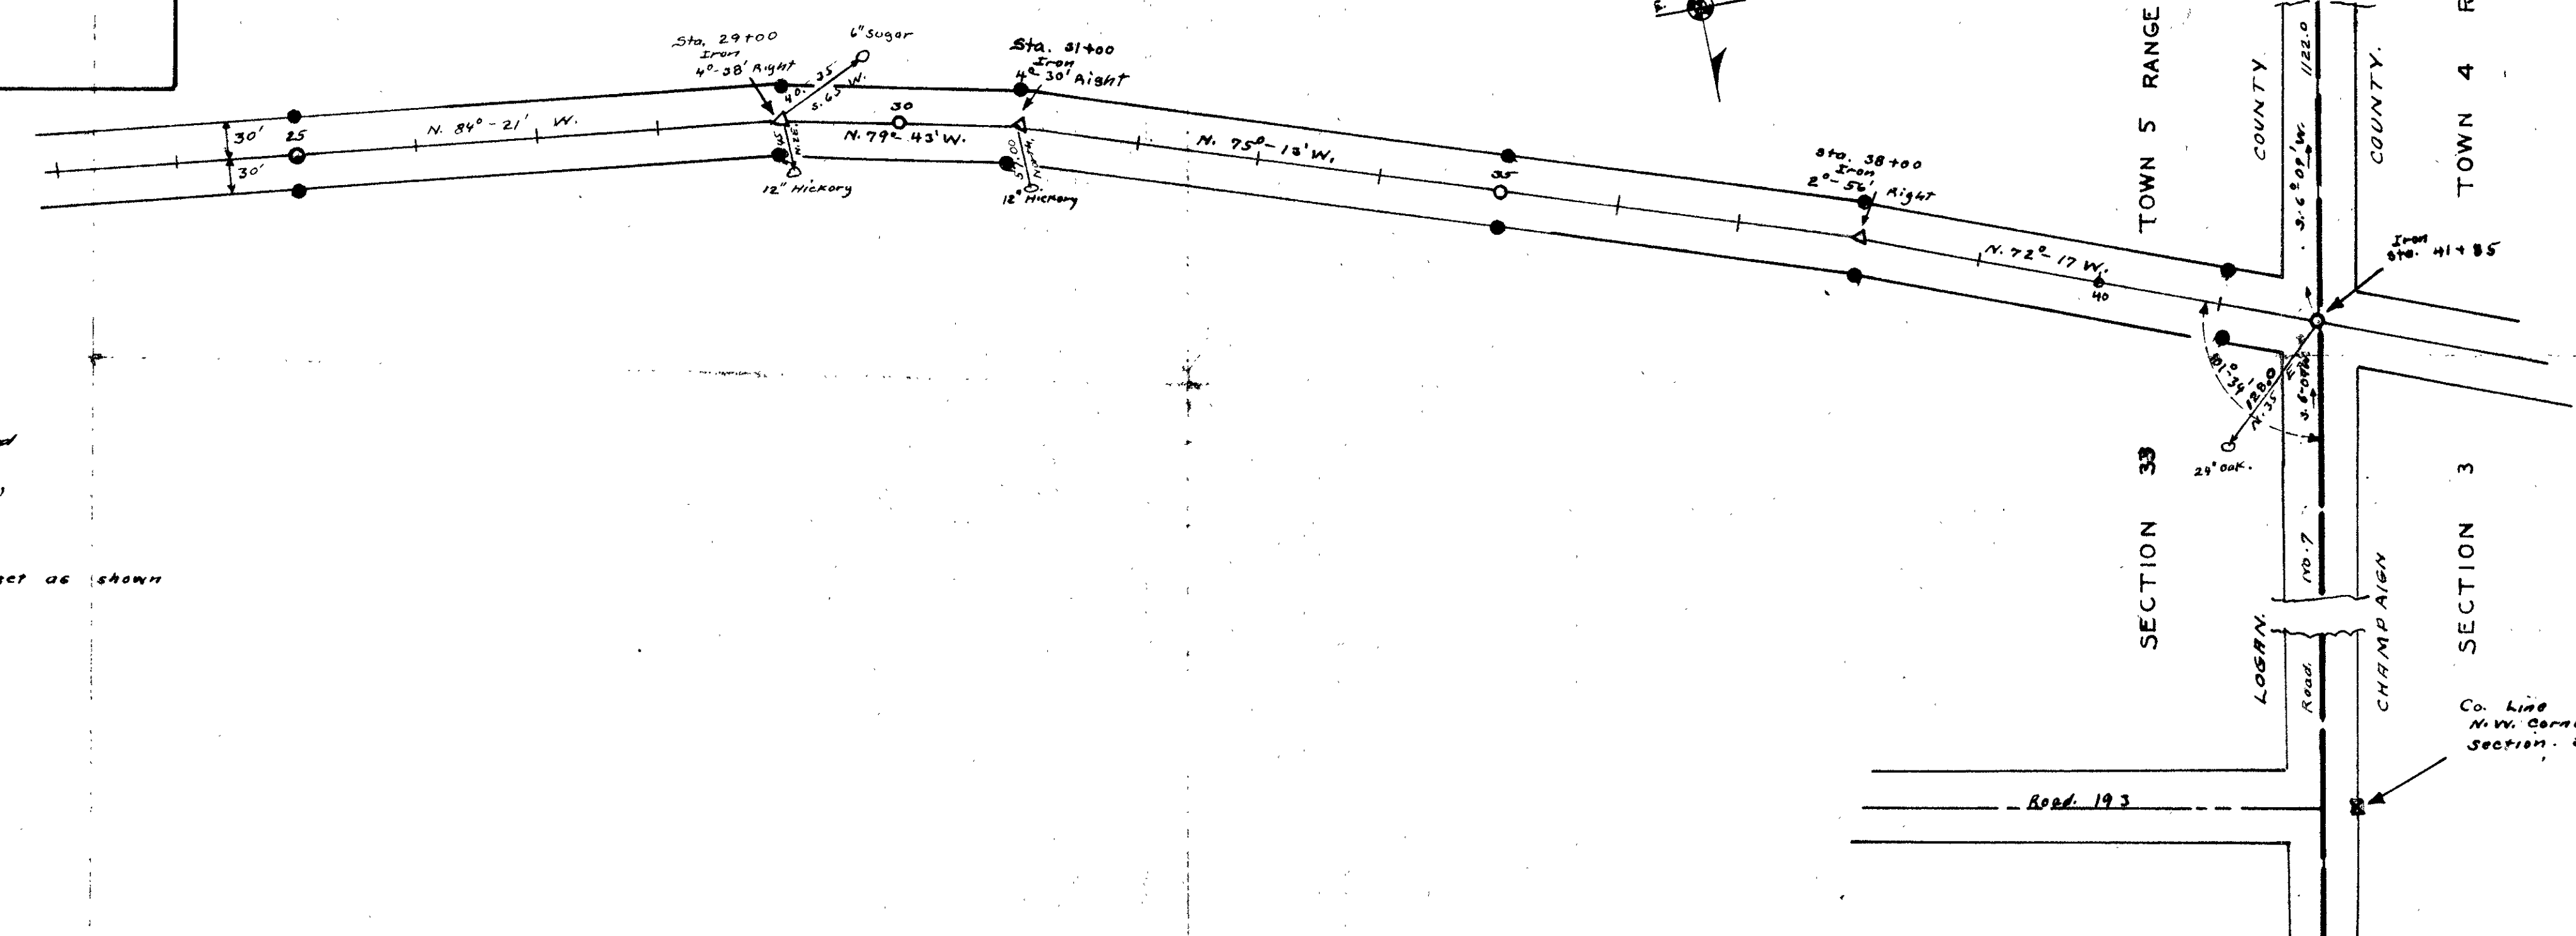

Length 4185 Feet  
Length 0.79 Miles.

Note:- 60' Road Free Turn Pike Record  
No. 2 Page 6-1849  
Record shows 60' from second  
band (which is my station 1700)

● Concrete Right-of-way Posts set as shown

Surveyed by J.E. Wright  
Drawn by P.C. Wright  
Library Notes Book 596

