







**UTILITY LINES**

The Ohio Edison Co. Springfield, Ohio  
 The Dayton Power & Light Co. Dayton, Ohio  
 The Lake Gas Co. Russells Point, Ohio  
 The United Telephone Co. Bellfontaine, Ohio

LOGAN COUNTY	
S.H. 168 RELOCATION	
SECS F (P), RUSSELLS POINT, LAKEVIEW (P)	
R/W PLANS	
DATE	DRAWN BY
REVISED MAY 1946	
LENGTH OF PROJECT	MILES

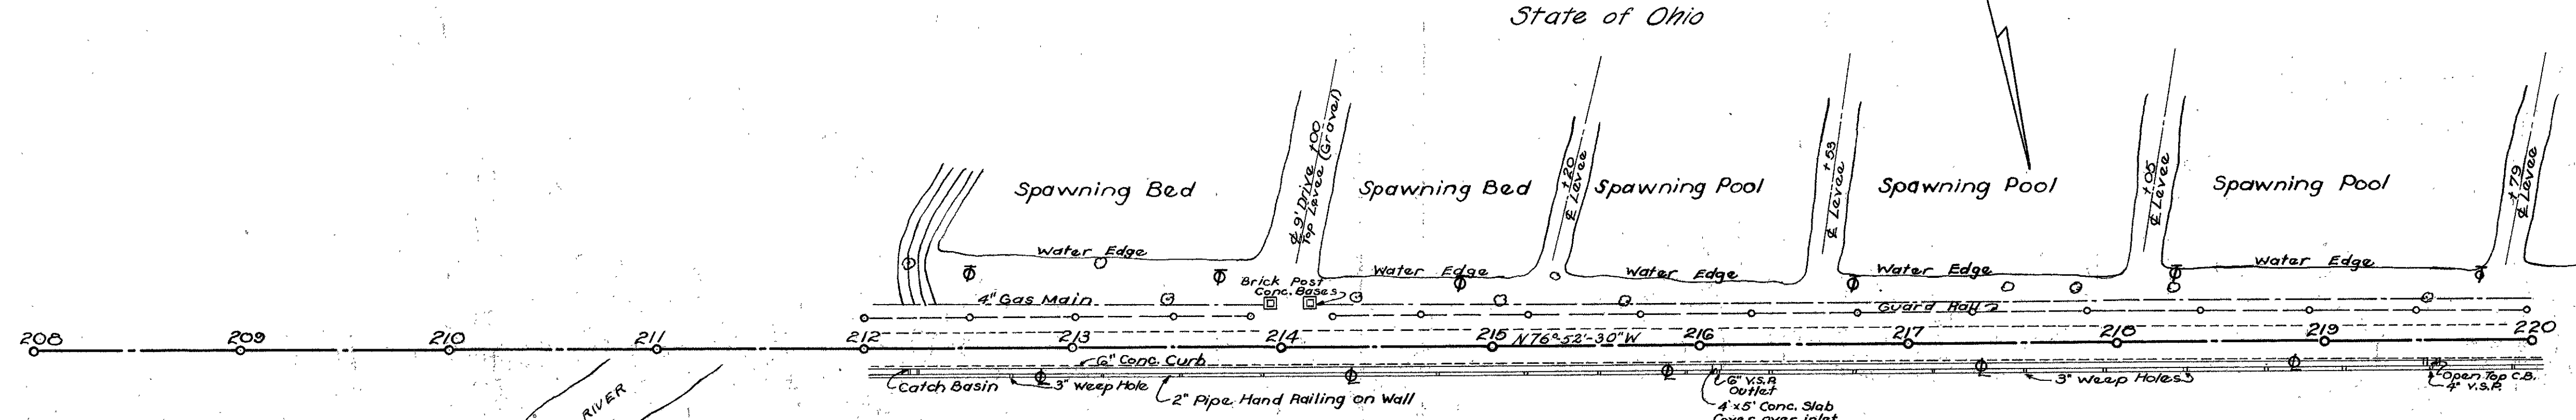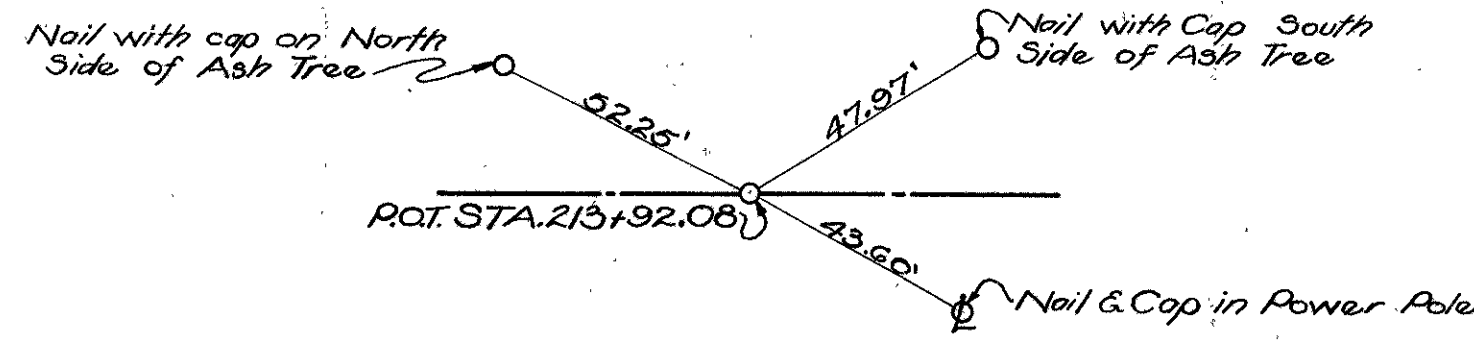

State of Ohio


INDIAN LAKE

State of Ohio

Pursuant to Sec. 1178-20 of the General Code and Hearing held in Bellefontaine Co. Dec. 21, 1944 Jr. Entry Vol. 29, Pa. 483 Dec. 29, 1944 approved the relocation as a Limited Access Facility

Sec. 1, T7R8E  
Washington Twp.

THE BELLEFONTAINE DEVELOPMENT CO.

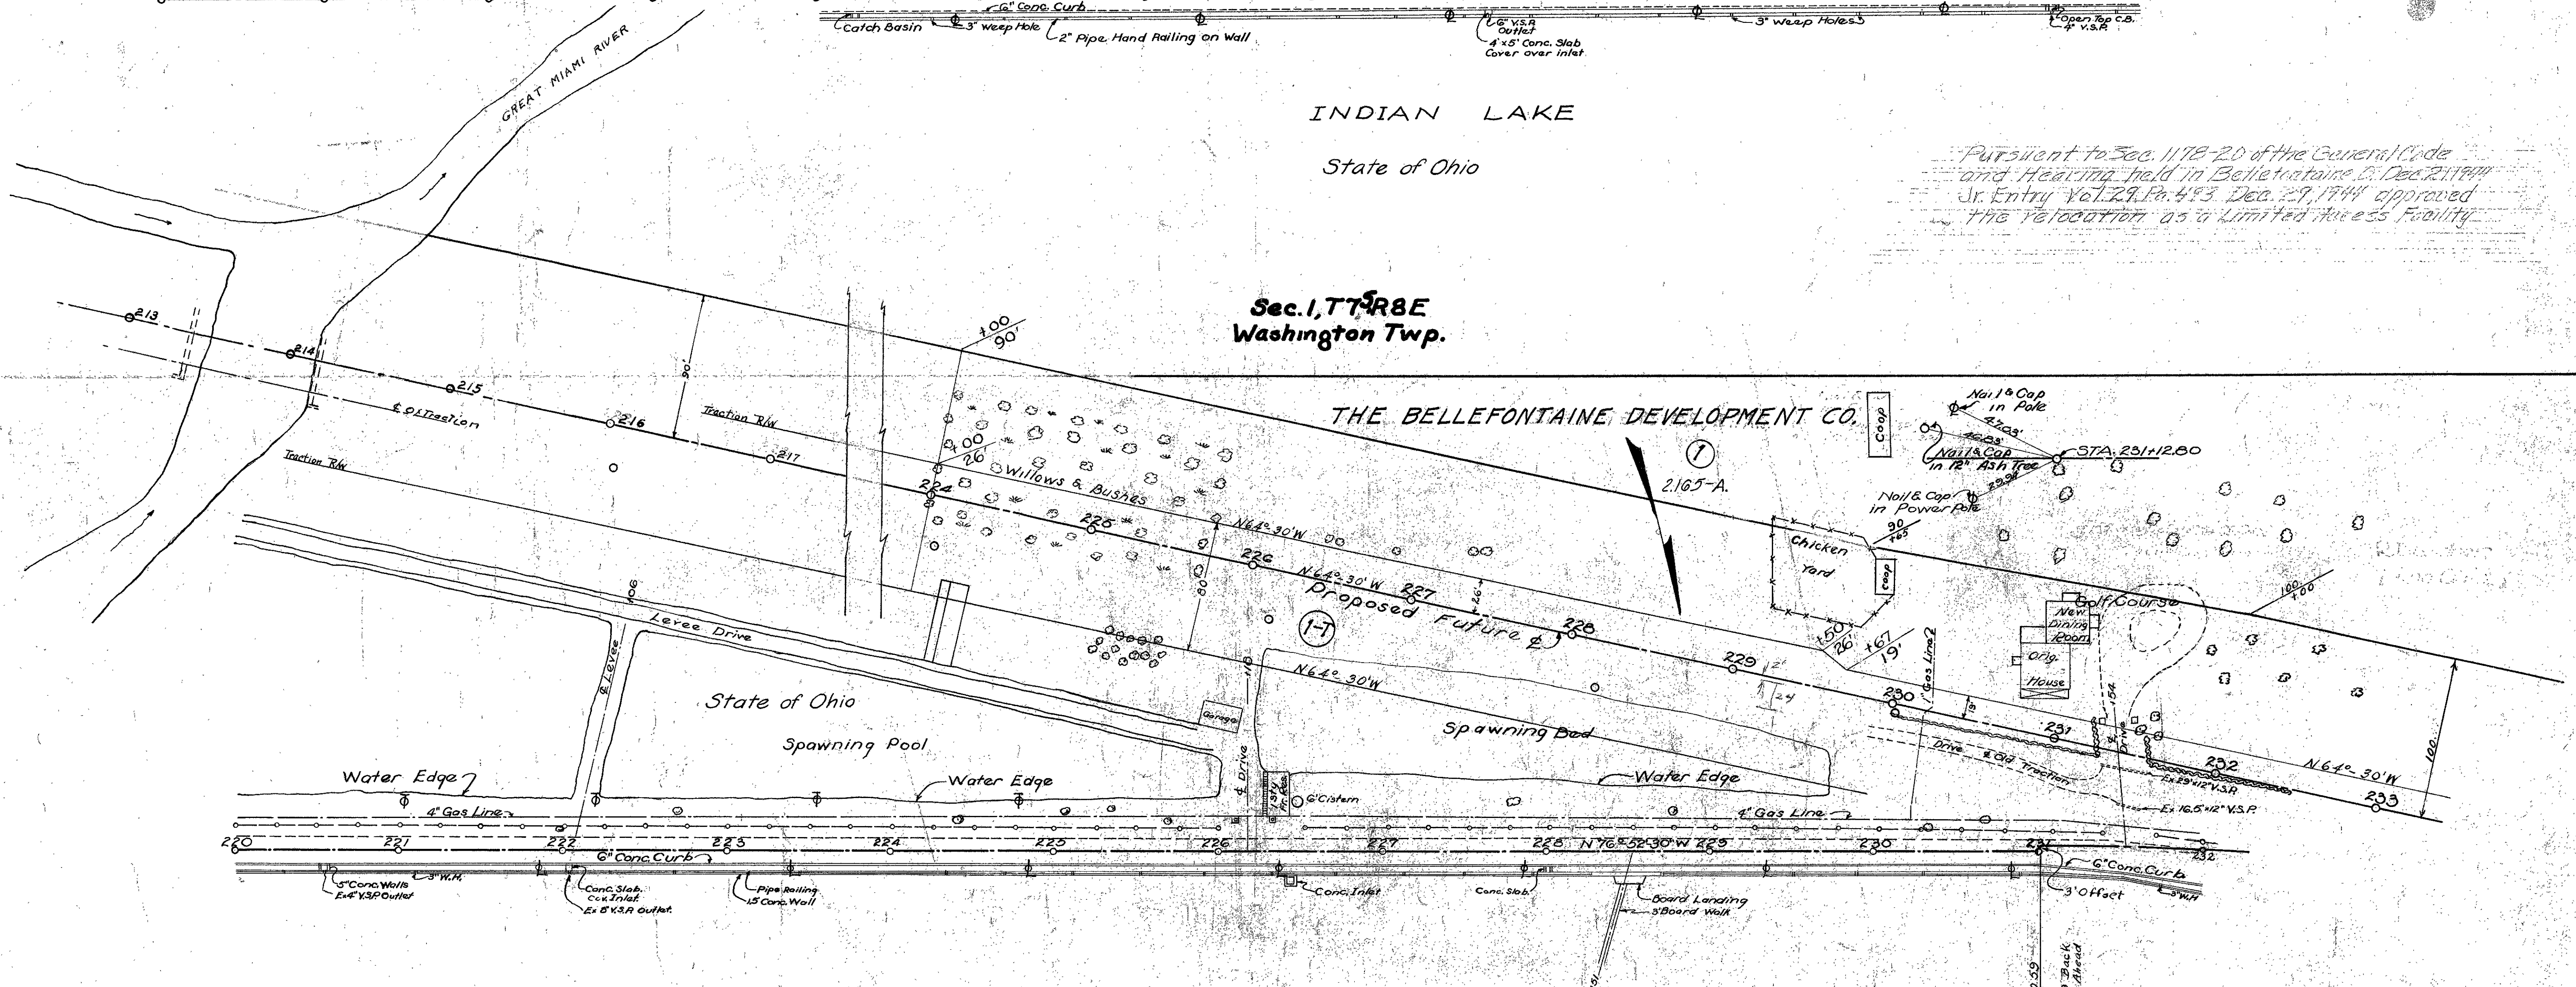

State of Ohio

State of Ohio

Sec. 1, T7R8E  
Washington Twp.

Sta 208+00 To Sta 232+00












**LOGAN COUNTY  
S.H. 168 RELOCATION  
SEC. F (PD), RUSSELLS  
POINT, LAKEVIEW, E (PD)  
R/W PLANS**

4  
11

DATE \_\_\_\_\_ DRAWN BY \_\_\_\_\_  
REVISED MAY 1946  
LENGTH OF PROJECT \_\_\_\_\_


**CURVE DATA**

$\Delta = 42^\circ 1'$   
 $D = 6'$   
 $T = 366.72'$   
 $L = 700.28'$   
 $R = 954.93'$   
 $E = 67.99'$

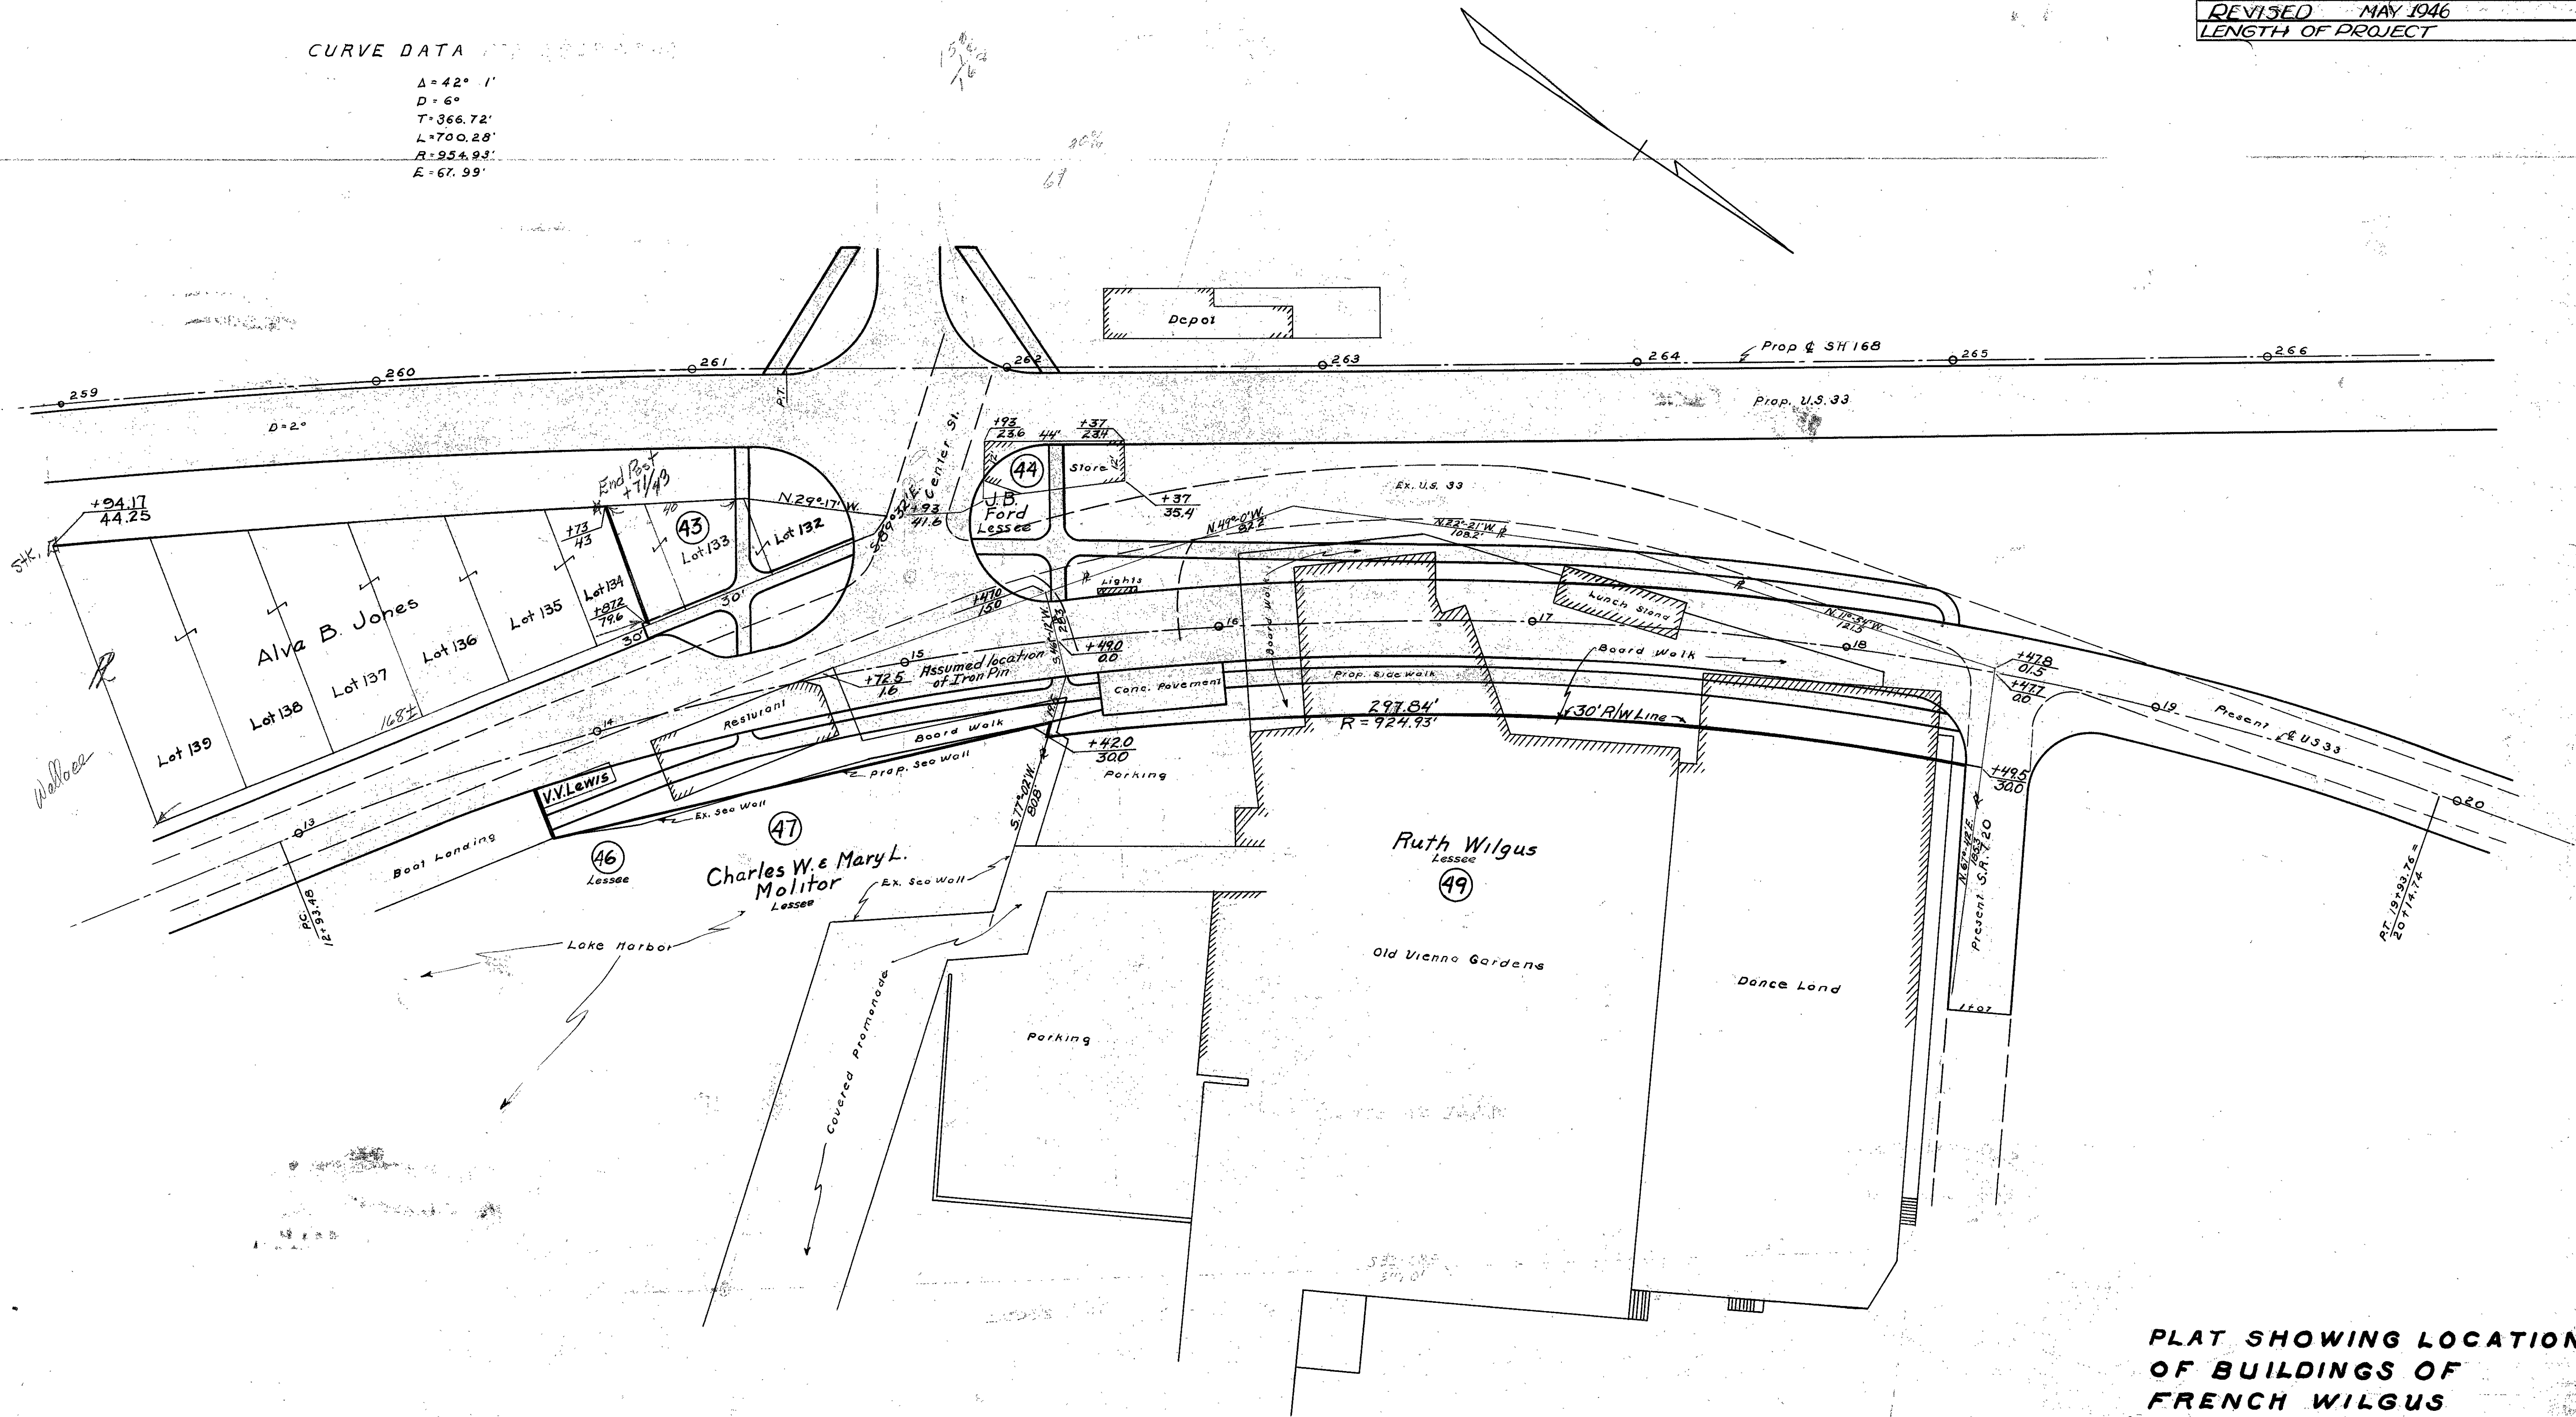


**PLAT SHOWING LOCATION  
OF BUILDINGS OF  
FRENCH WILGUS**  
Scale 1" = 25'



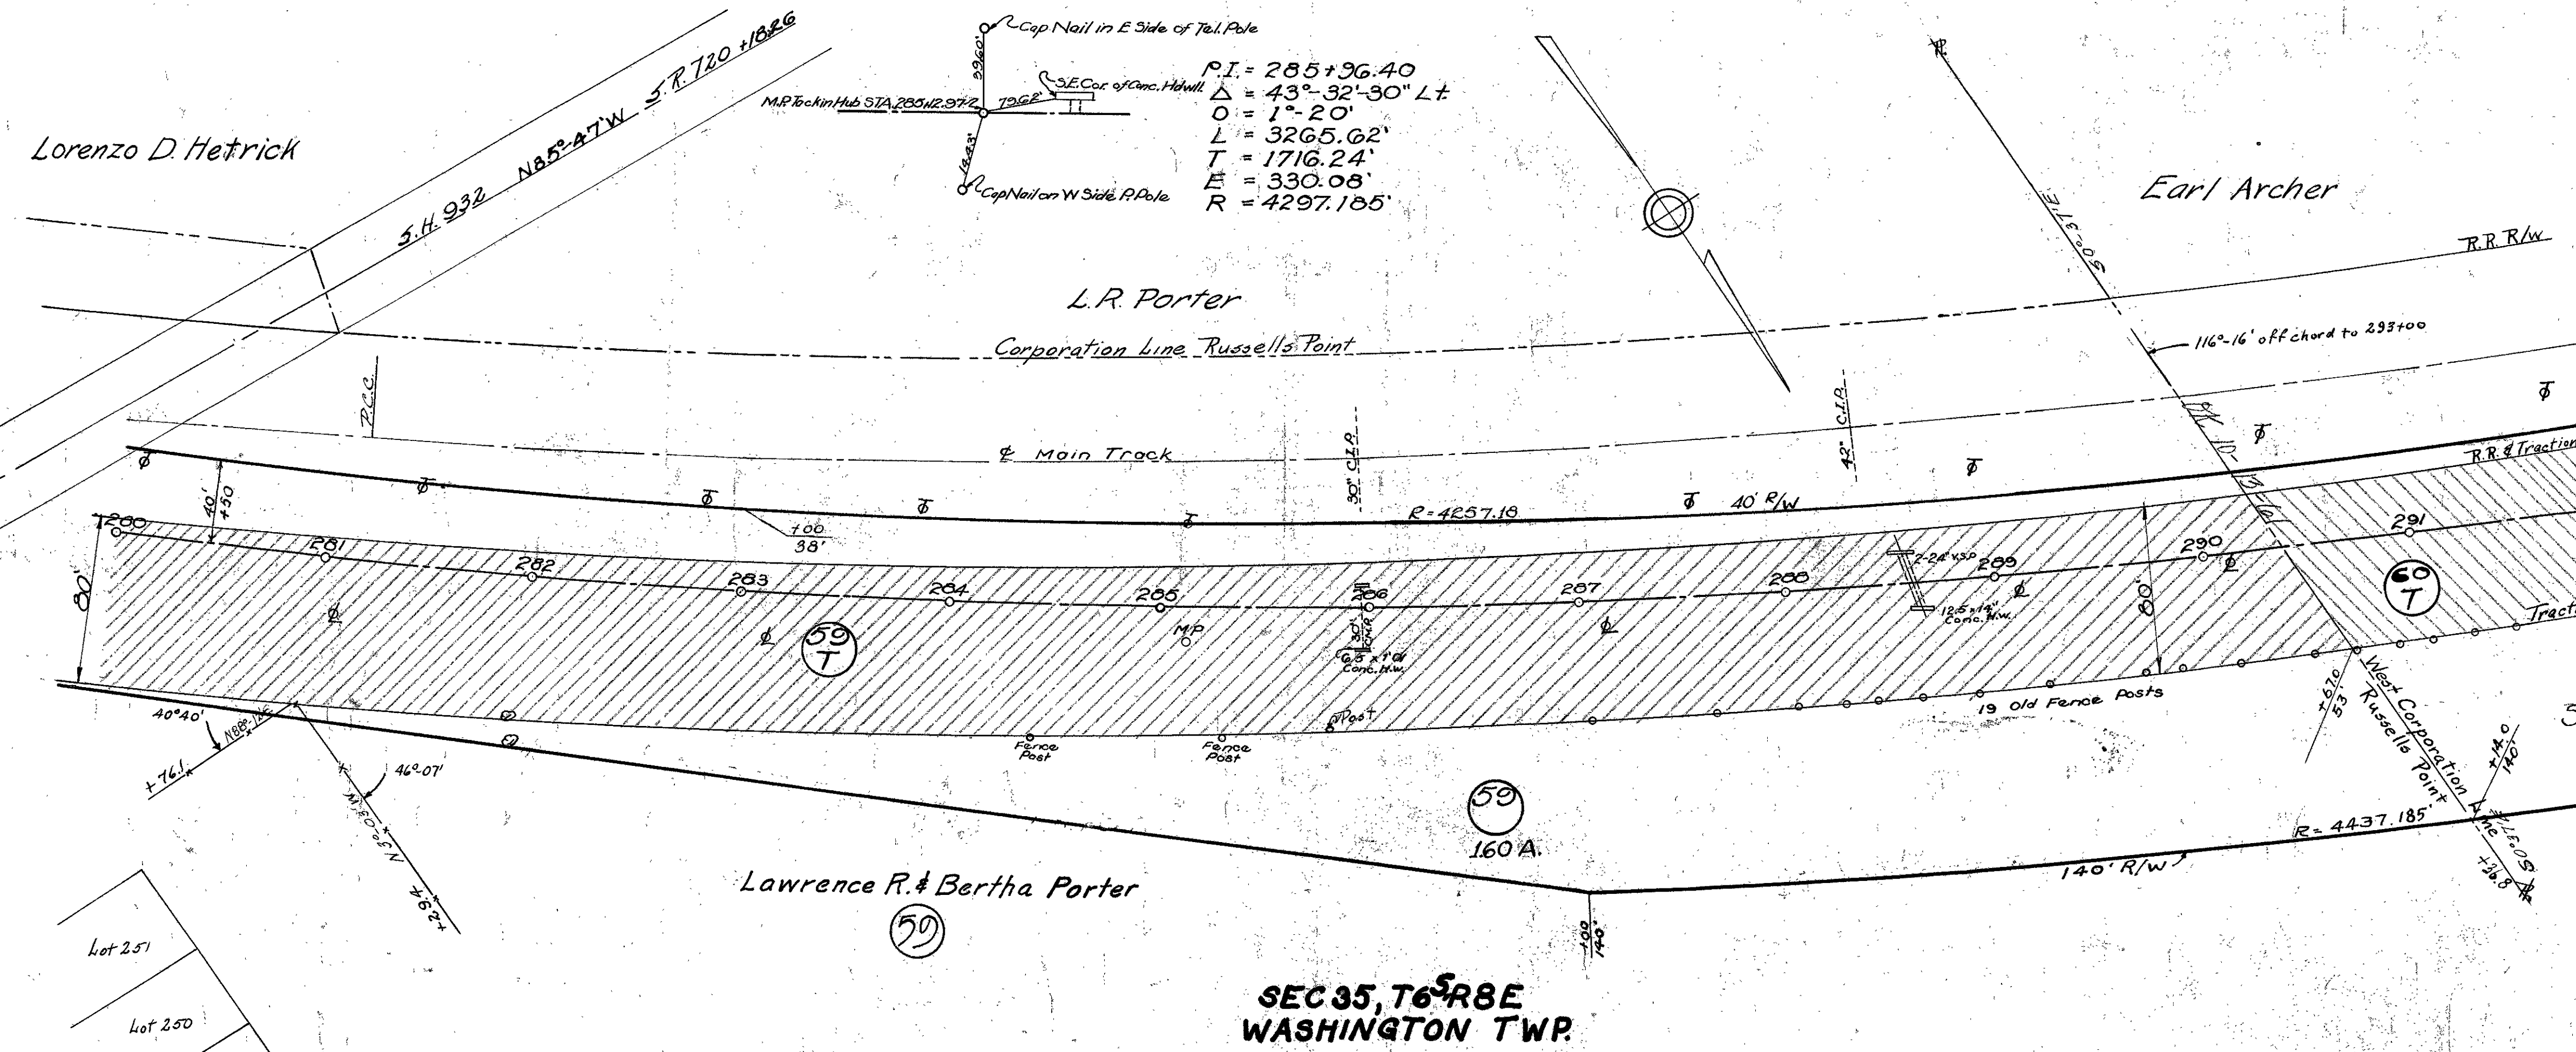



SEC 35, T6S, R8E  
 WASHINGTON TWP.

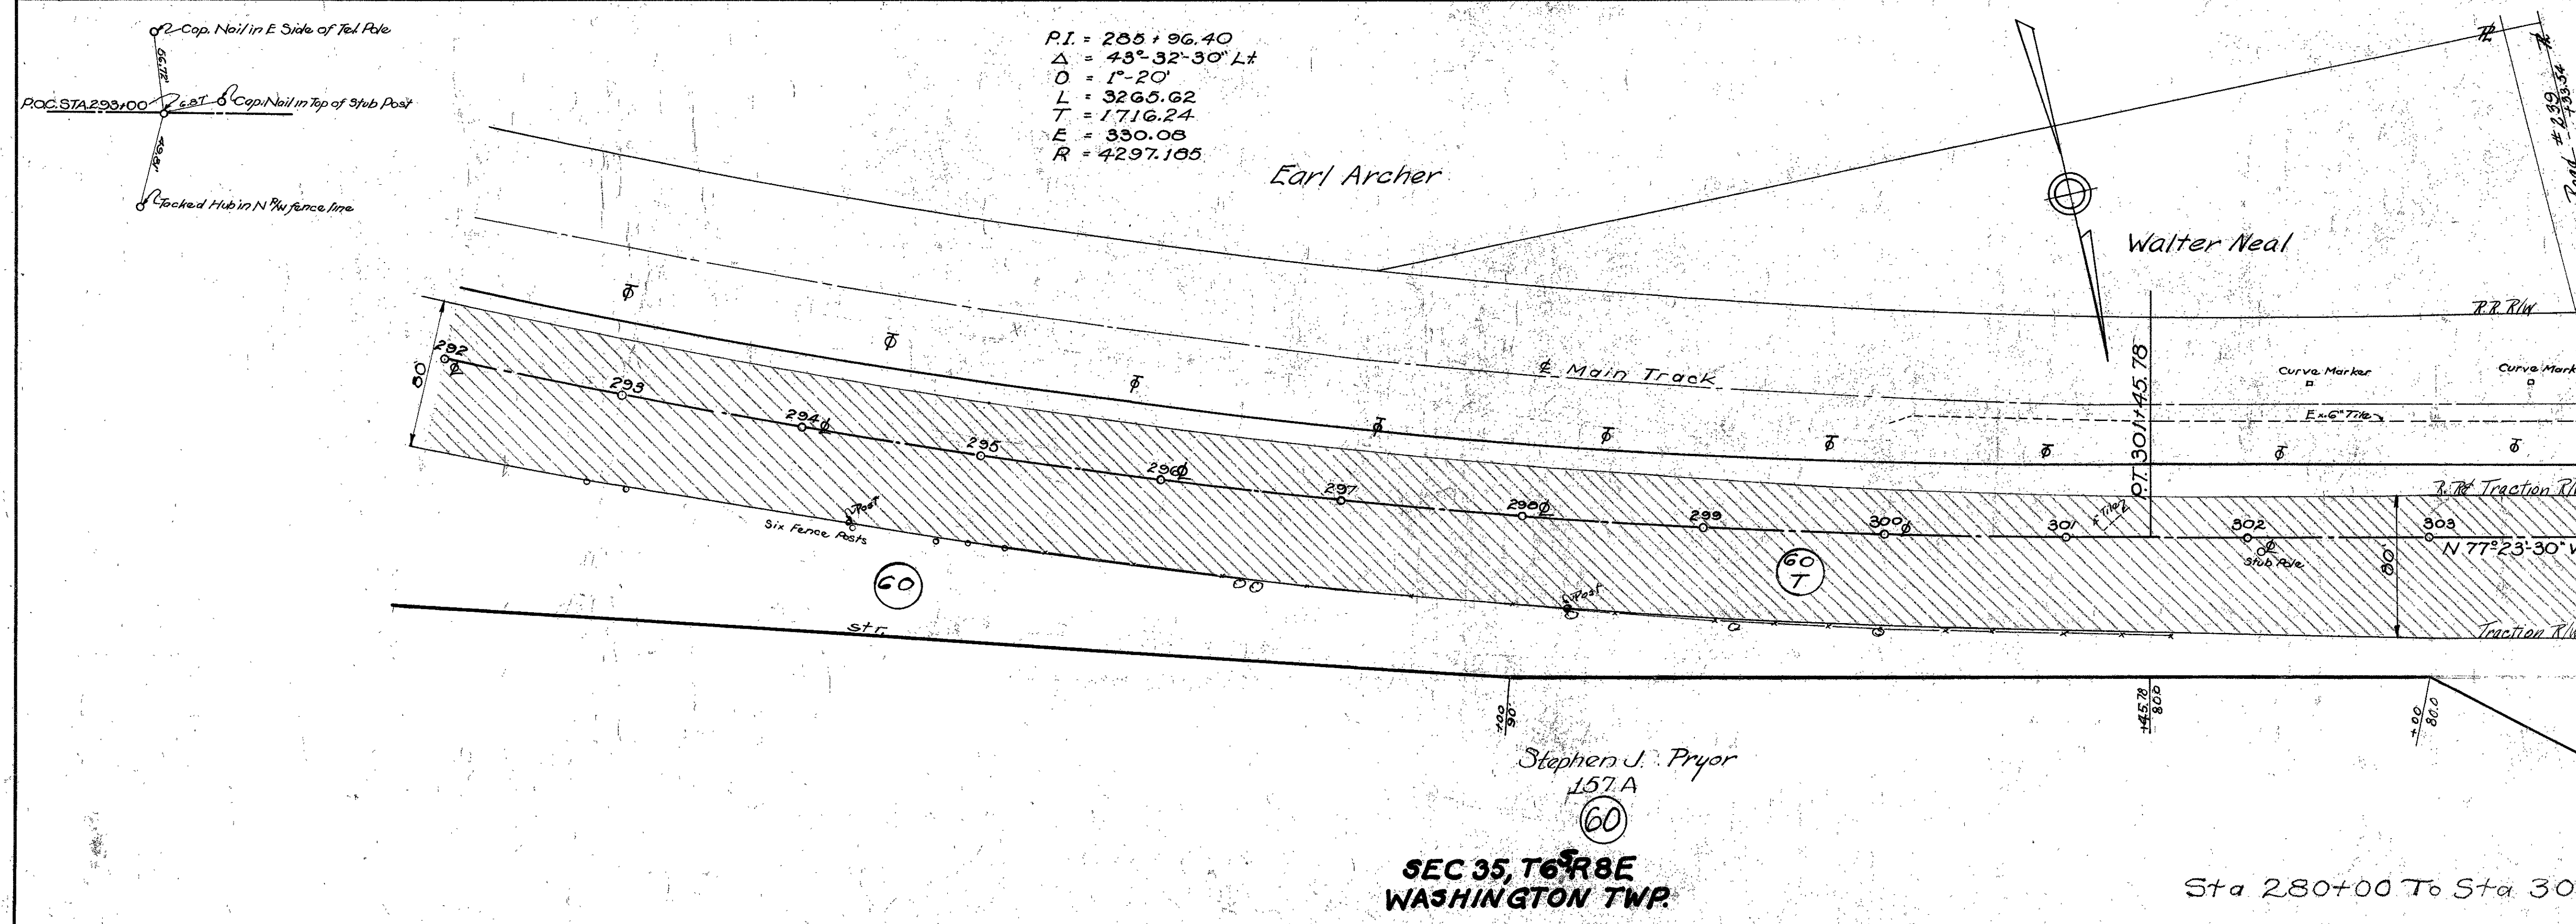



SEC 35, T6S, R8E  
 WASHINGTON TWP.

Sta 280+00 To Sta 304+00



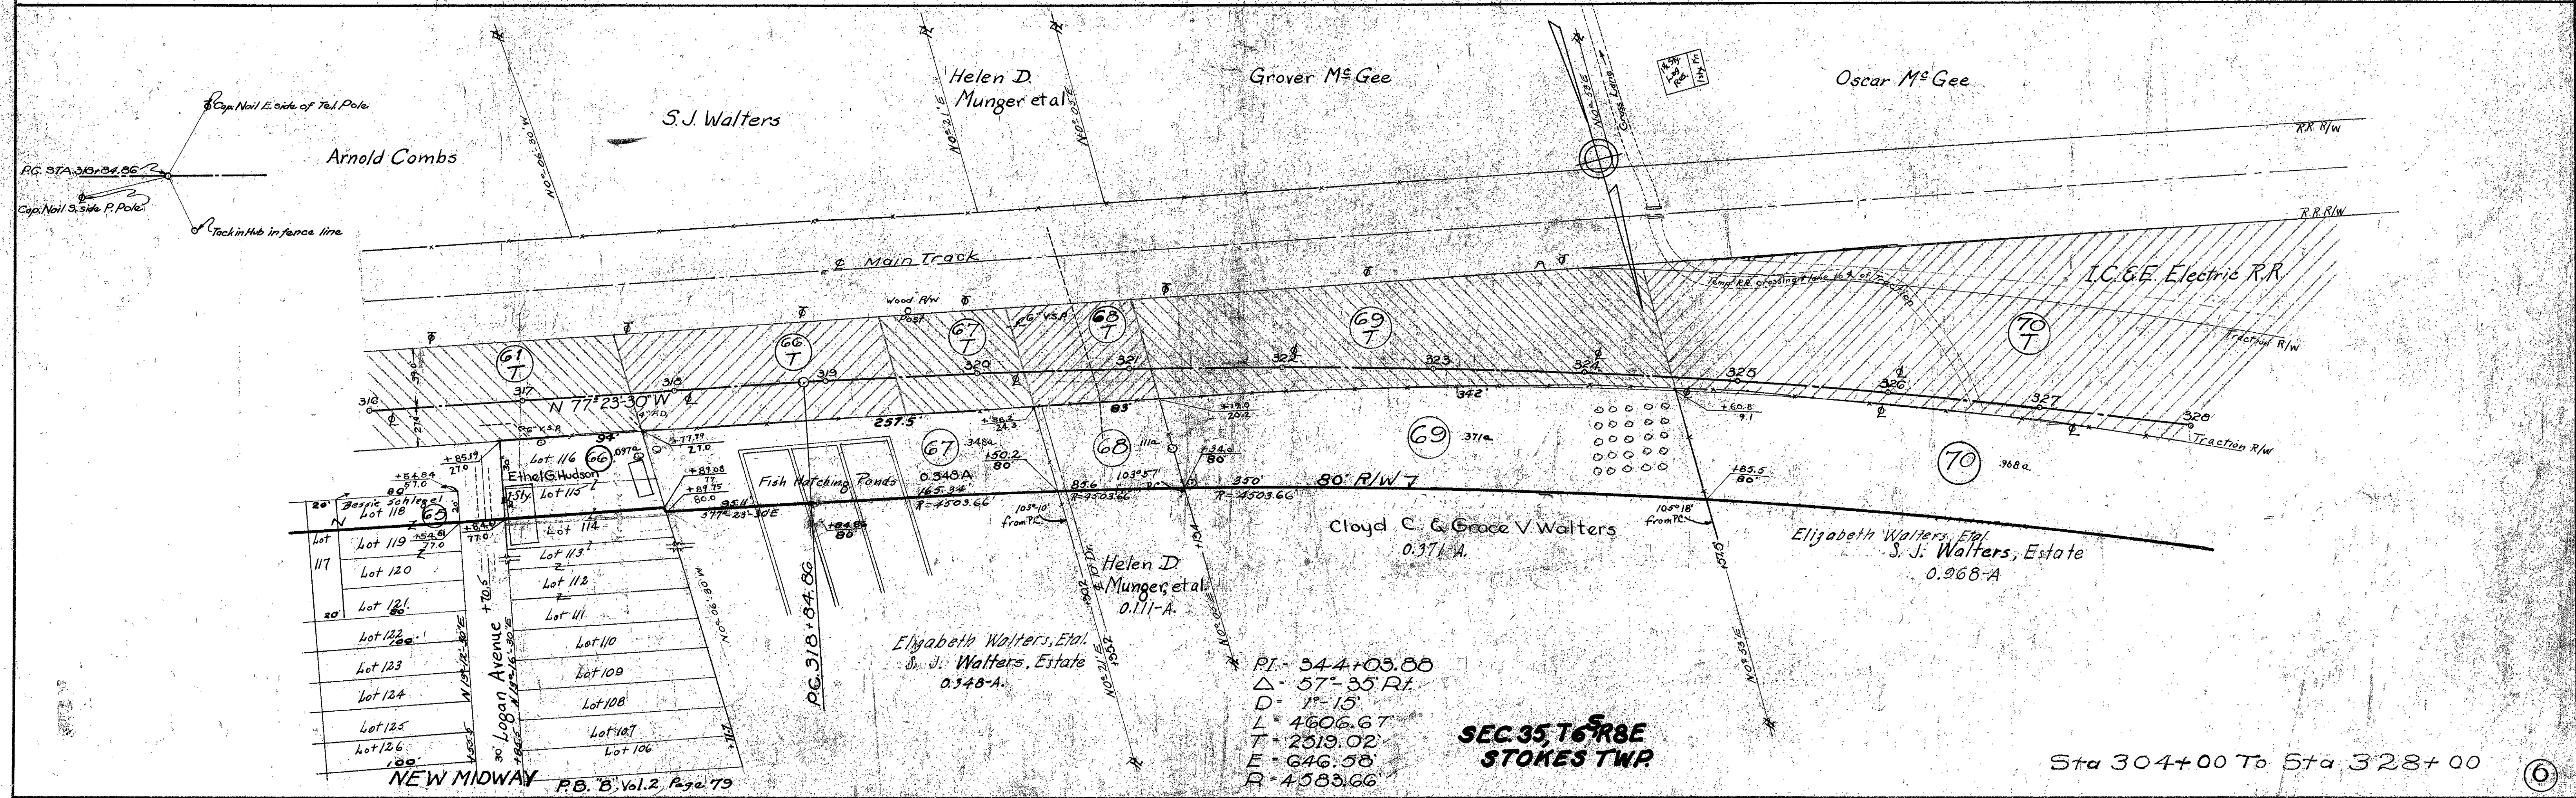
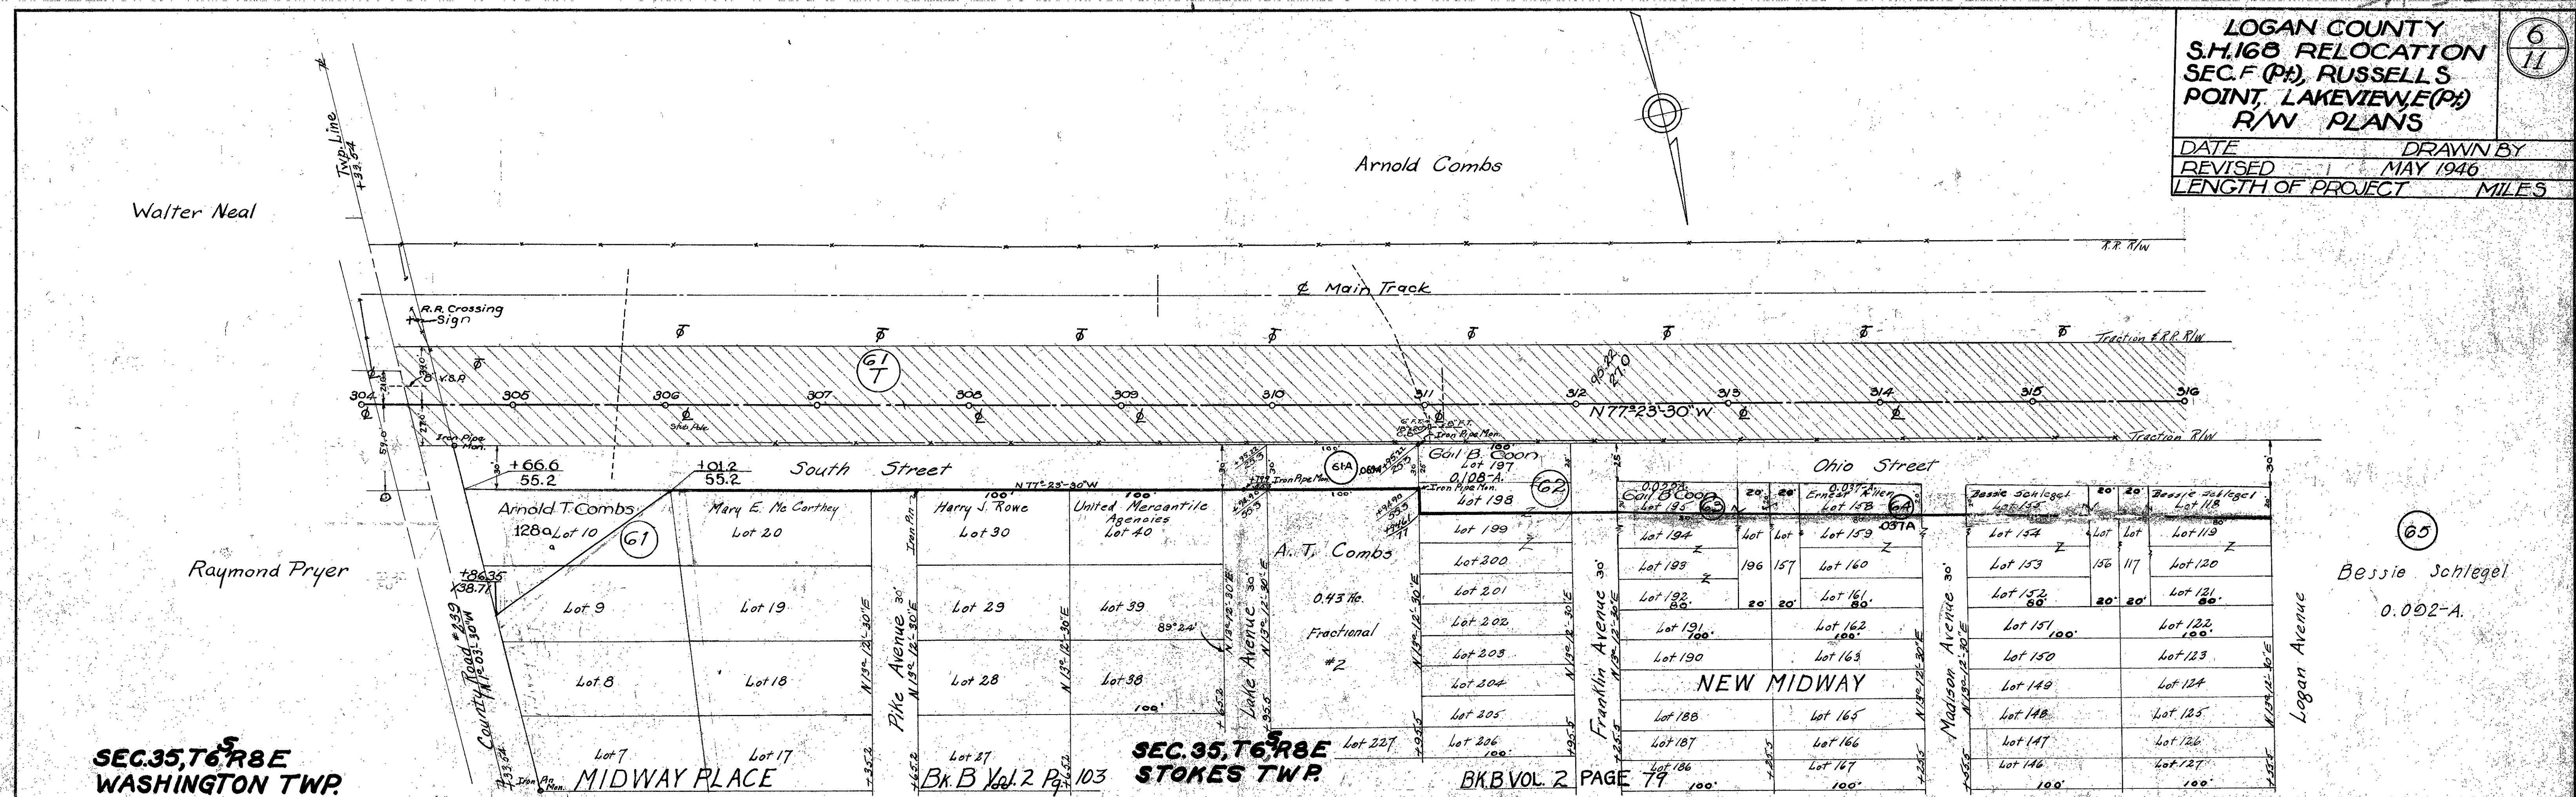




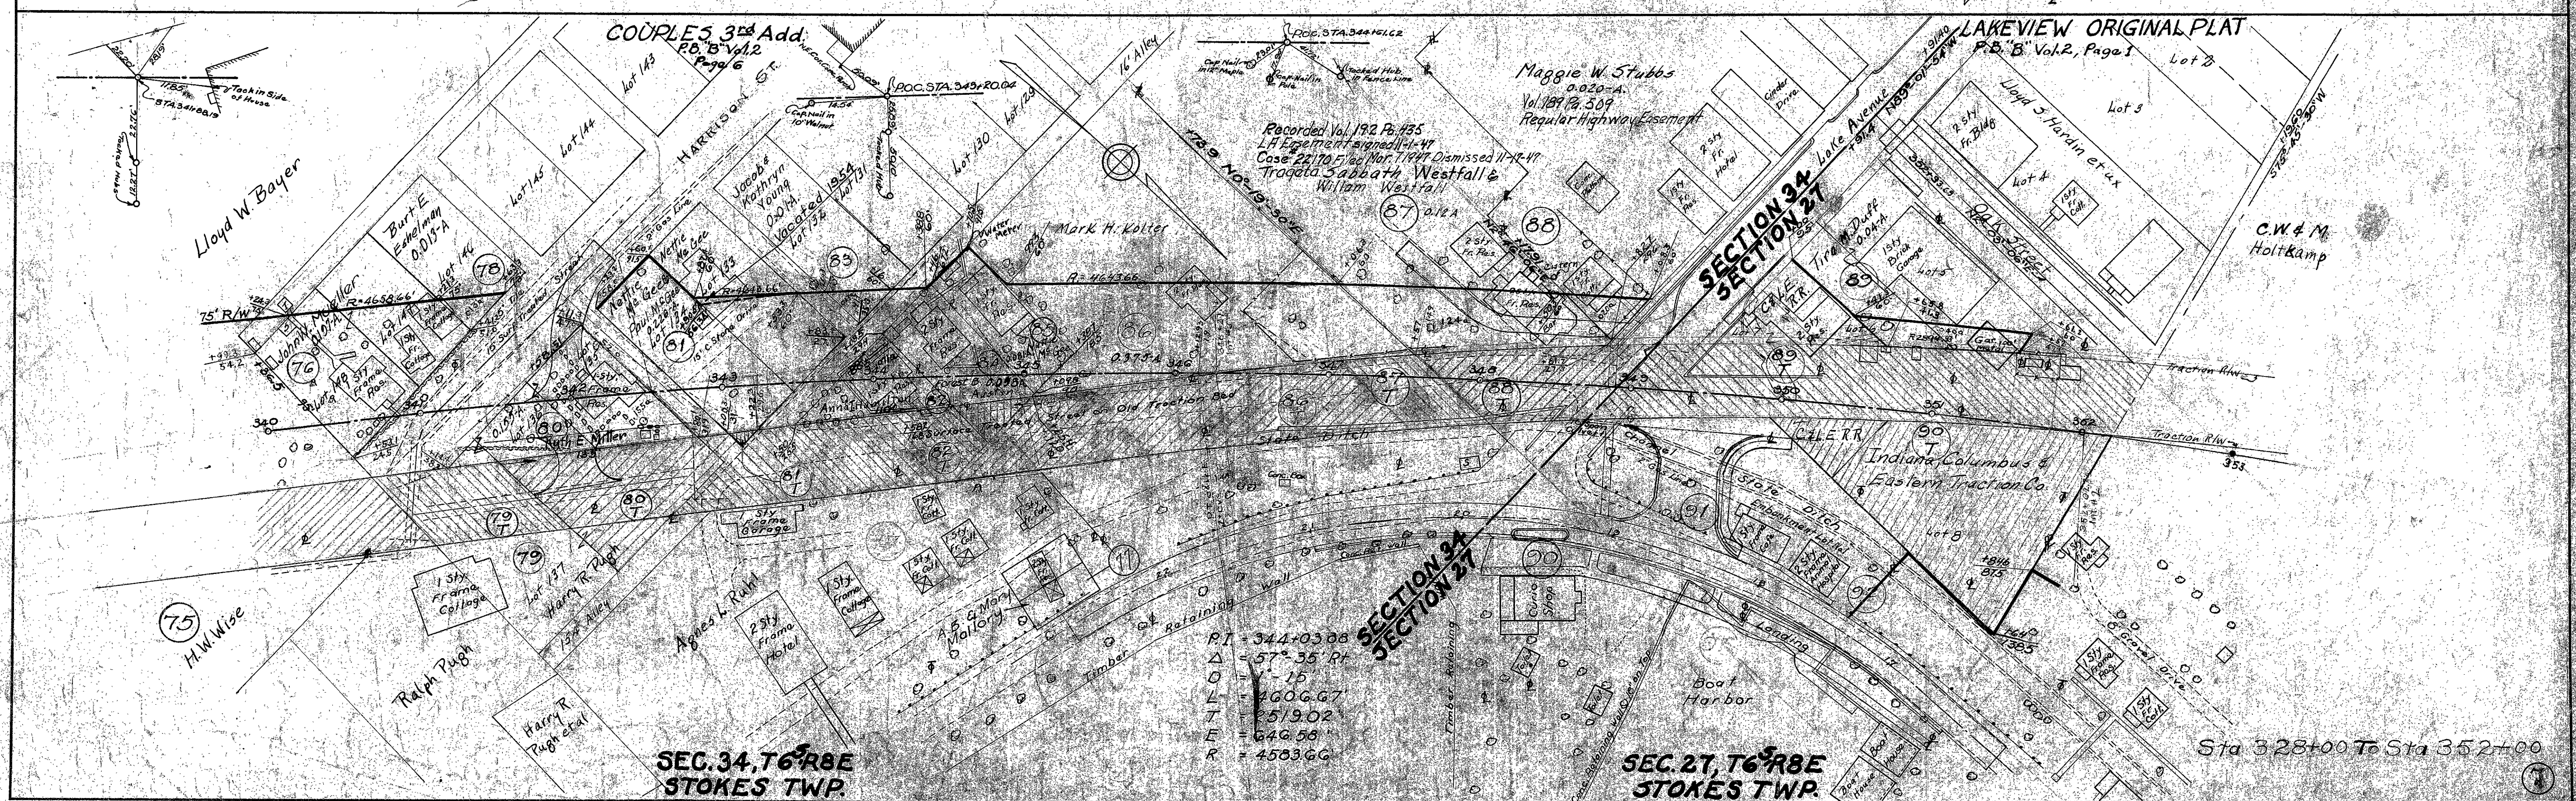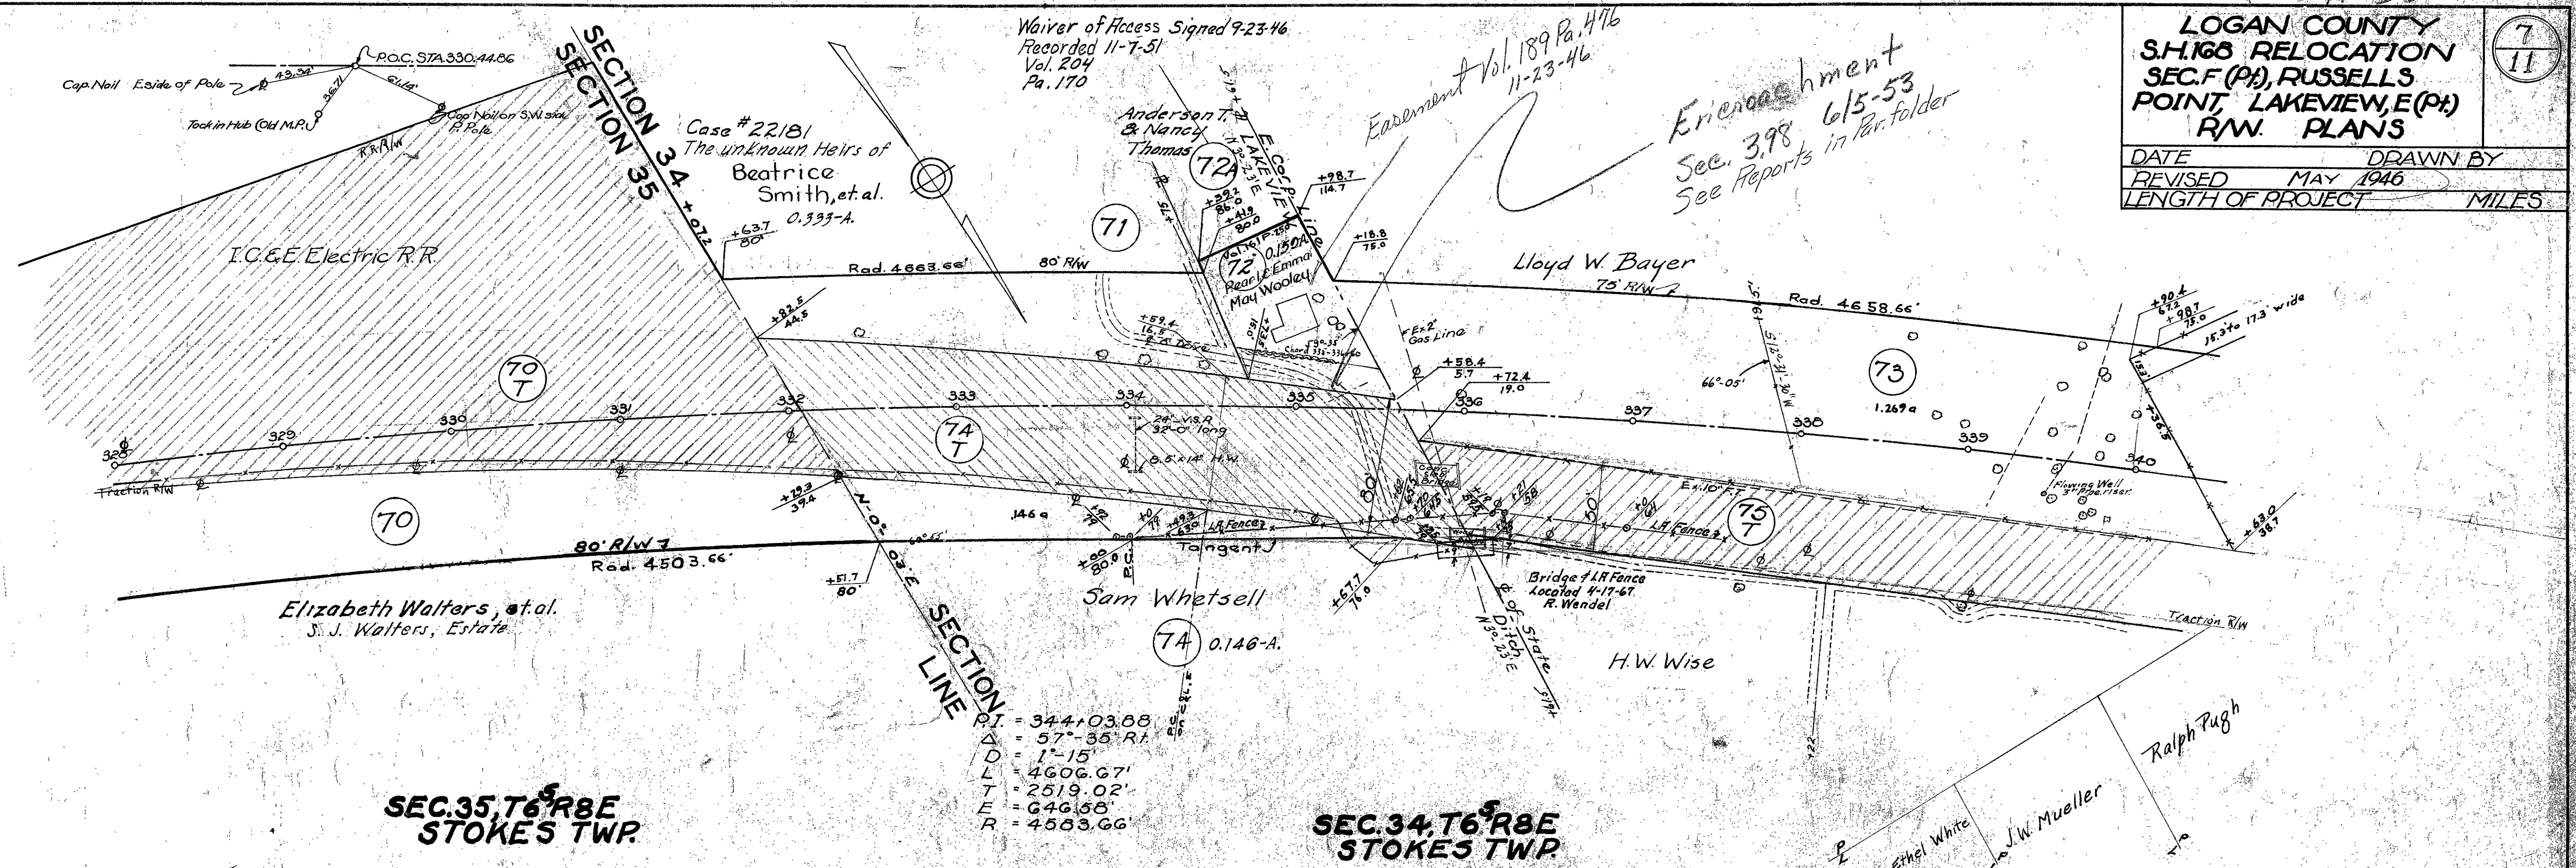




DATE DRAWN BY  
REVISED MAY 1946  
LENGTH OF PROJECT MILES

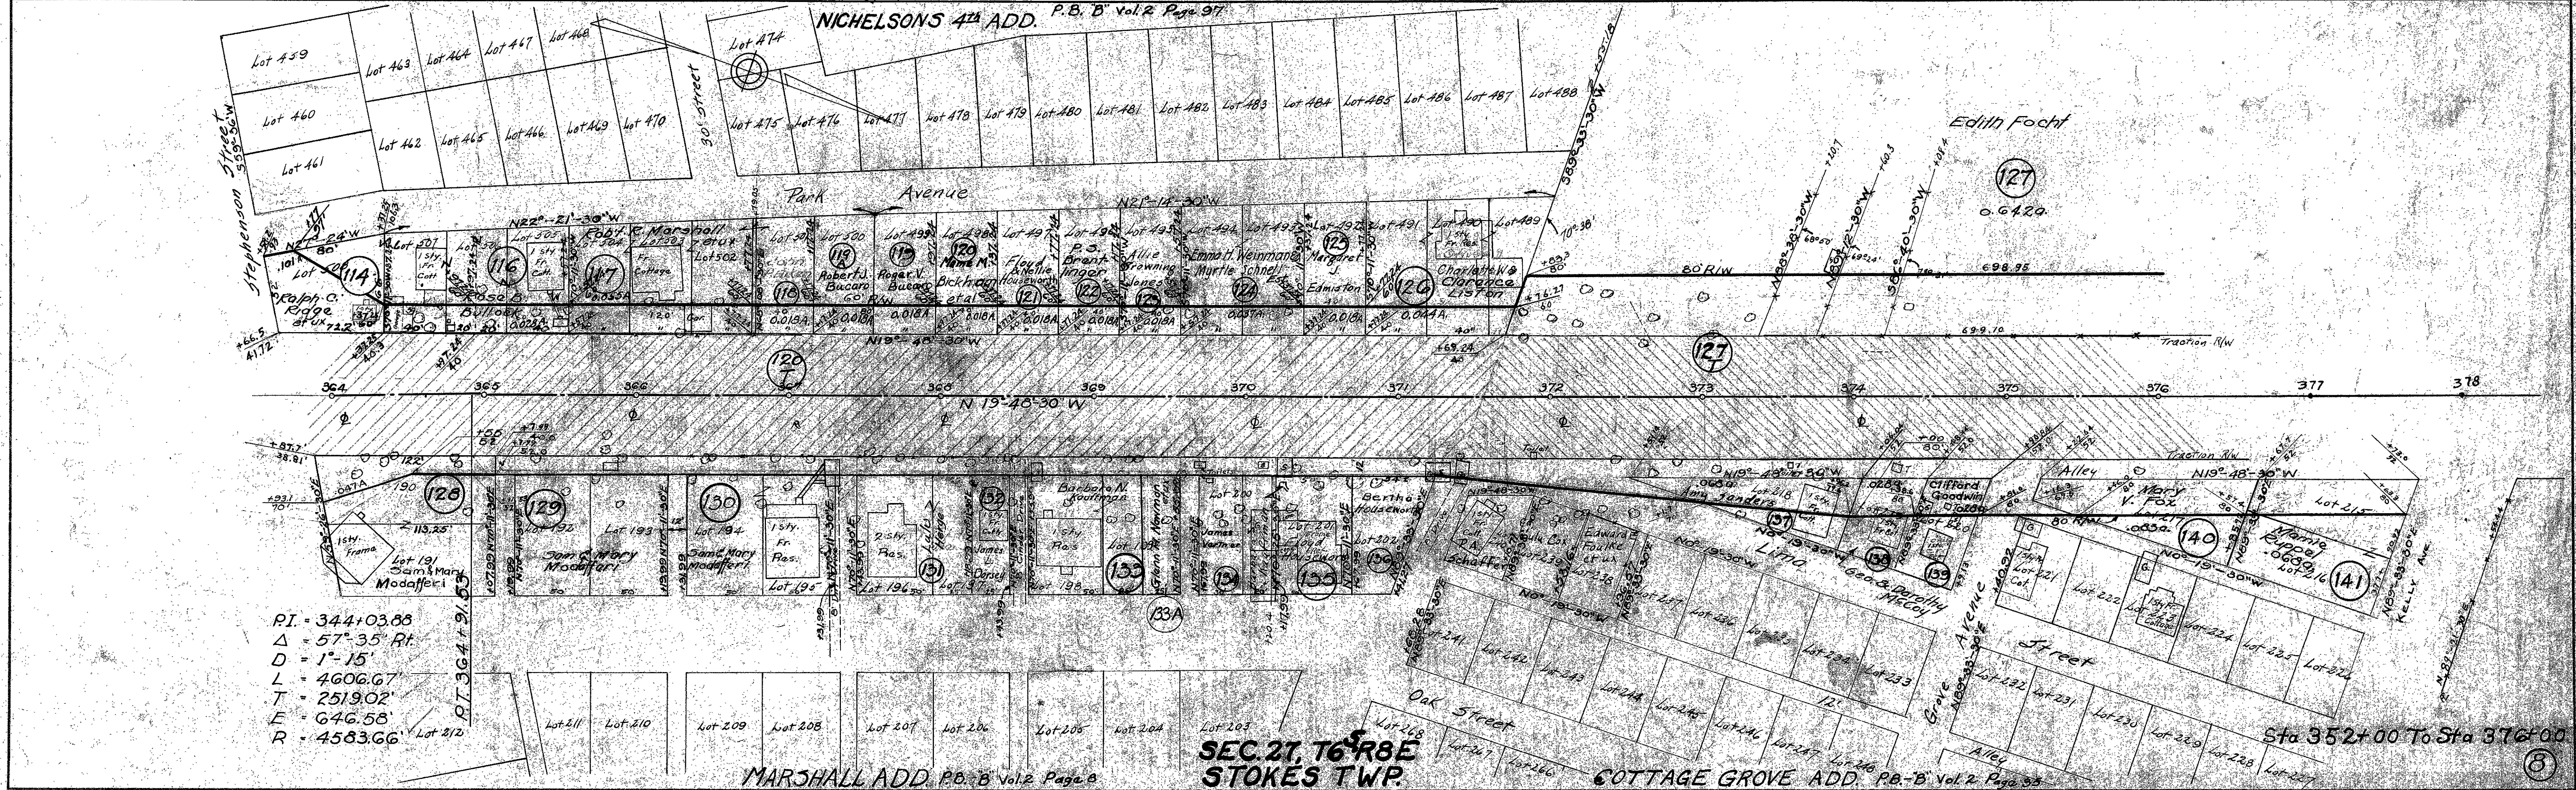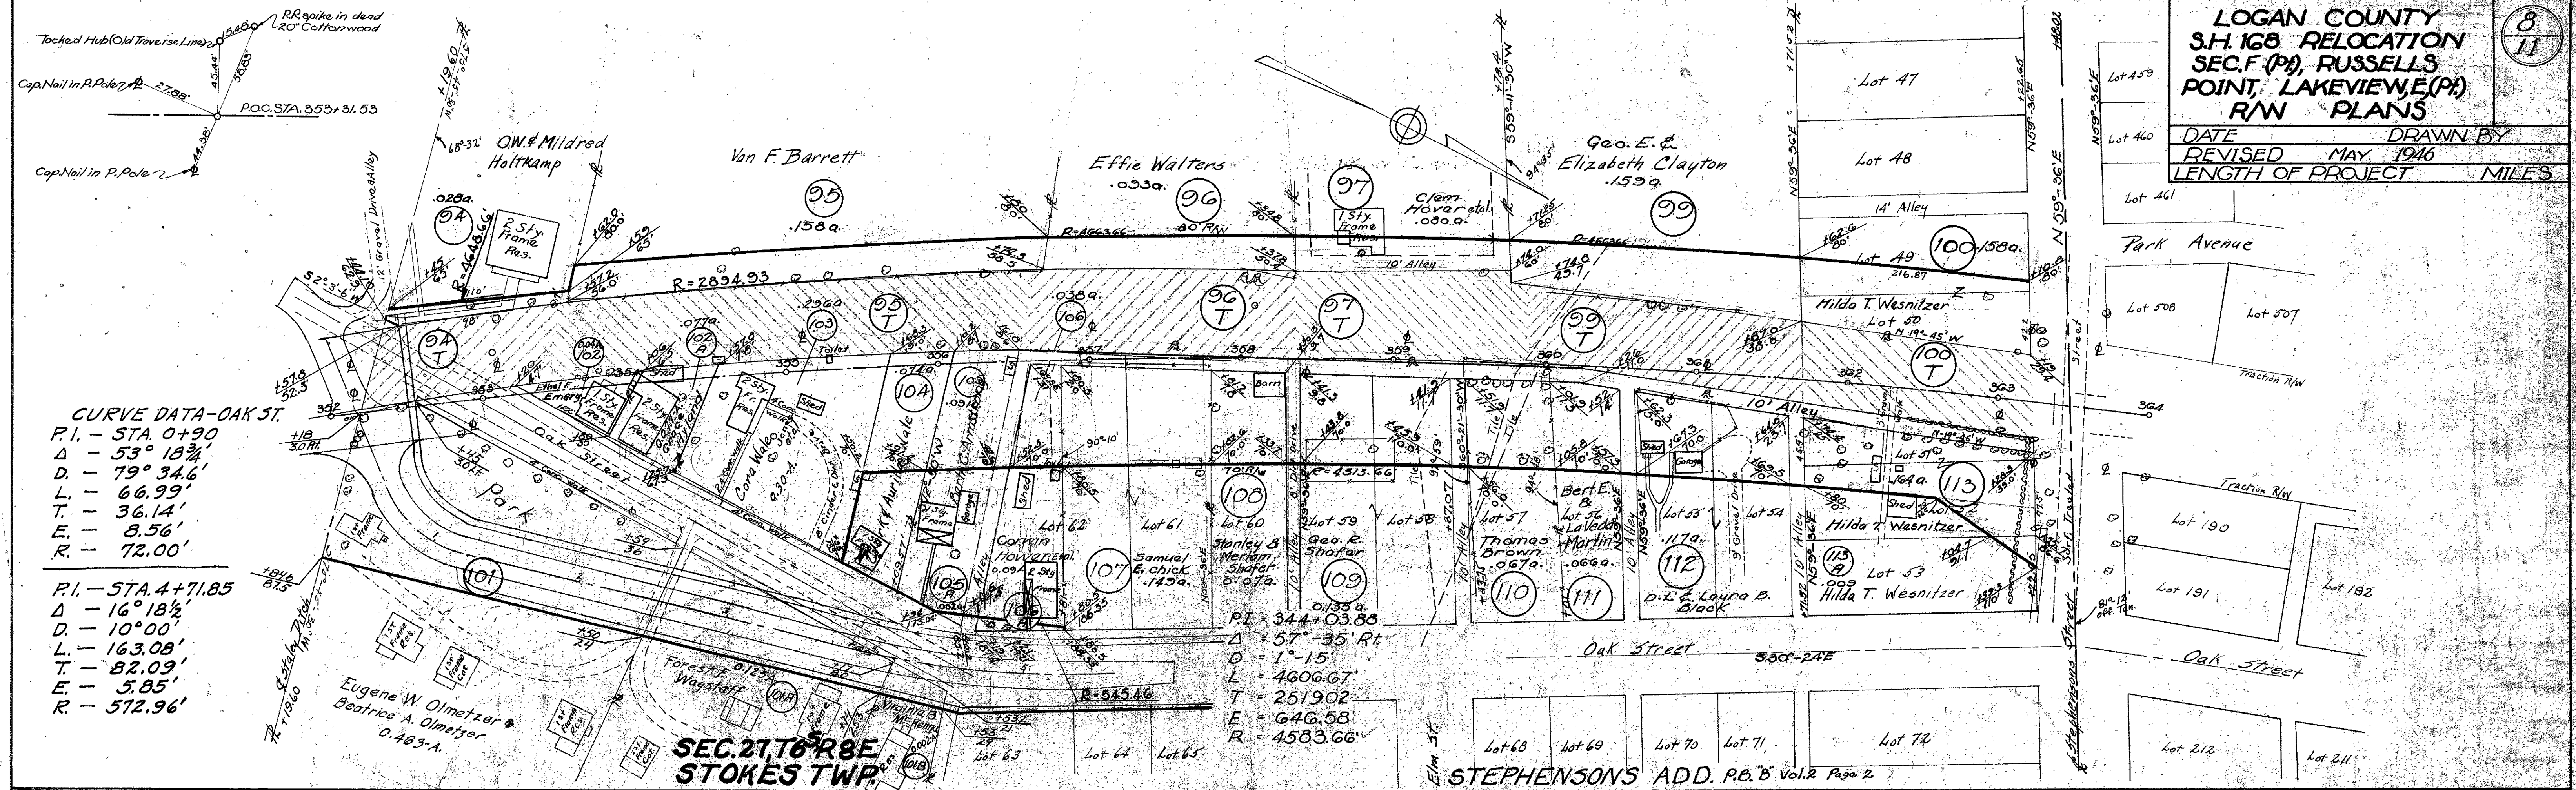




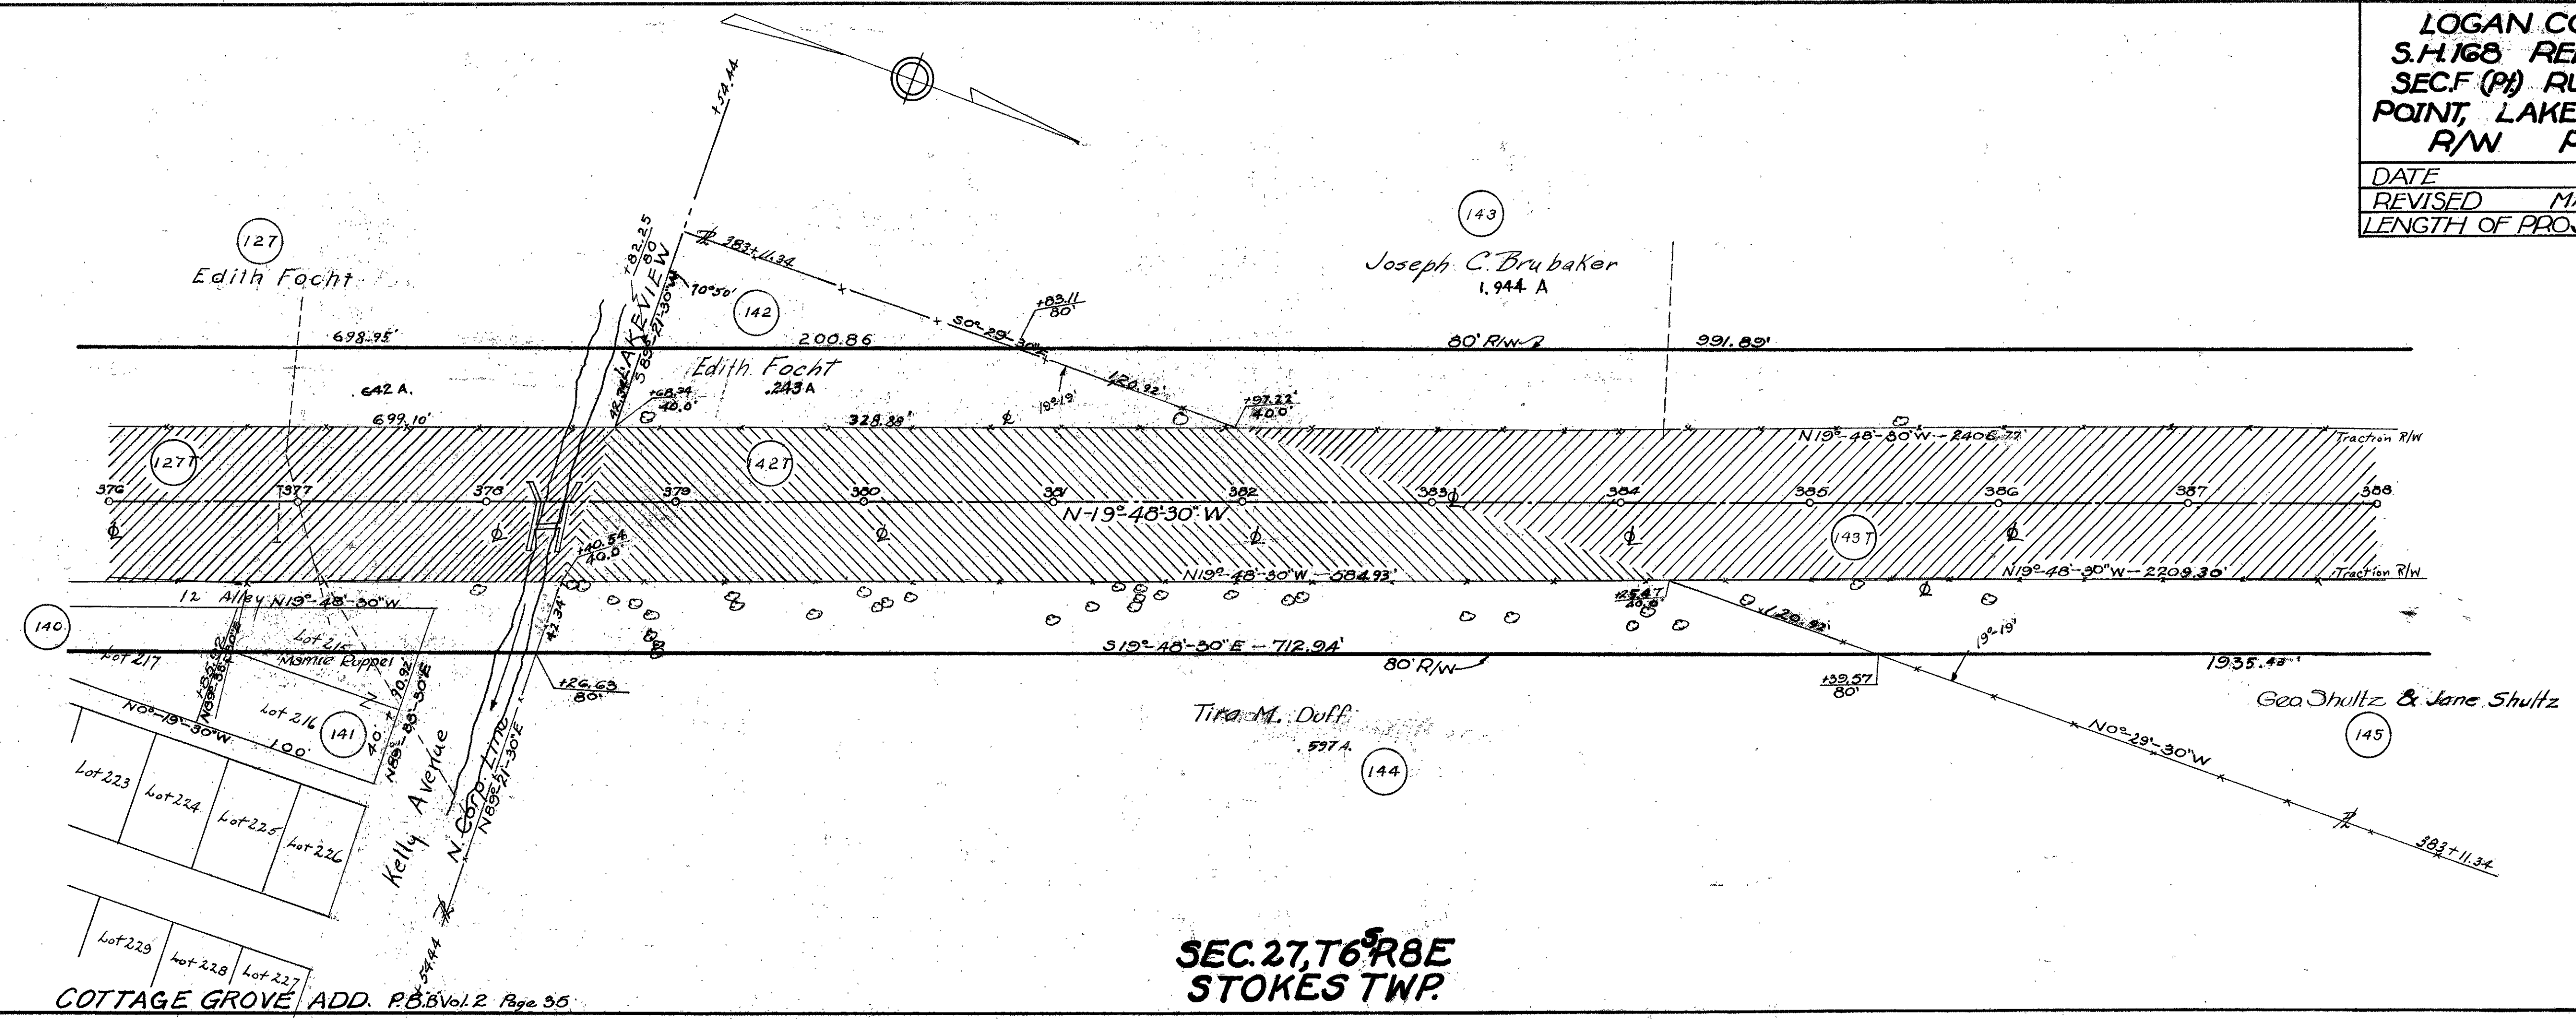

**SEC. 27, T6<sup>S</sup>R8E  
 STOKES TWP.**

COTTAGE GROVE ADD. P.B. Vol. 12 Page 35

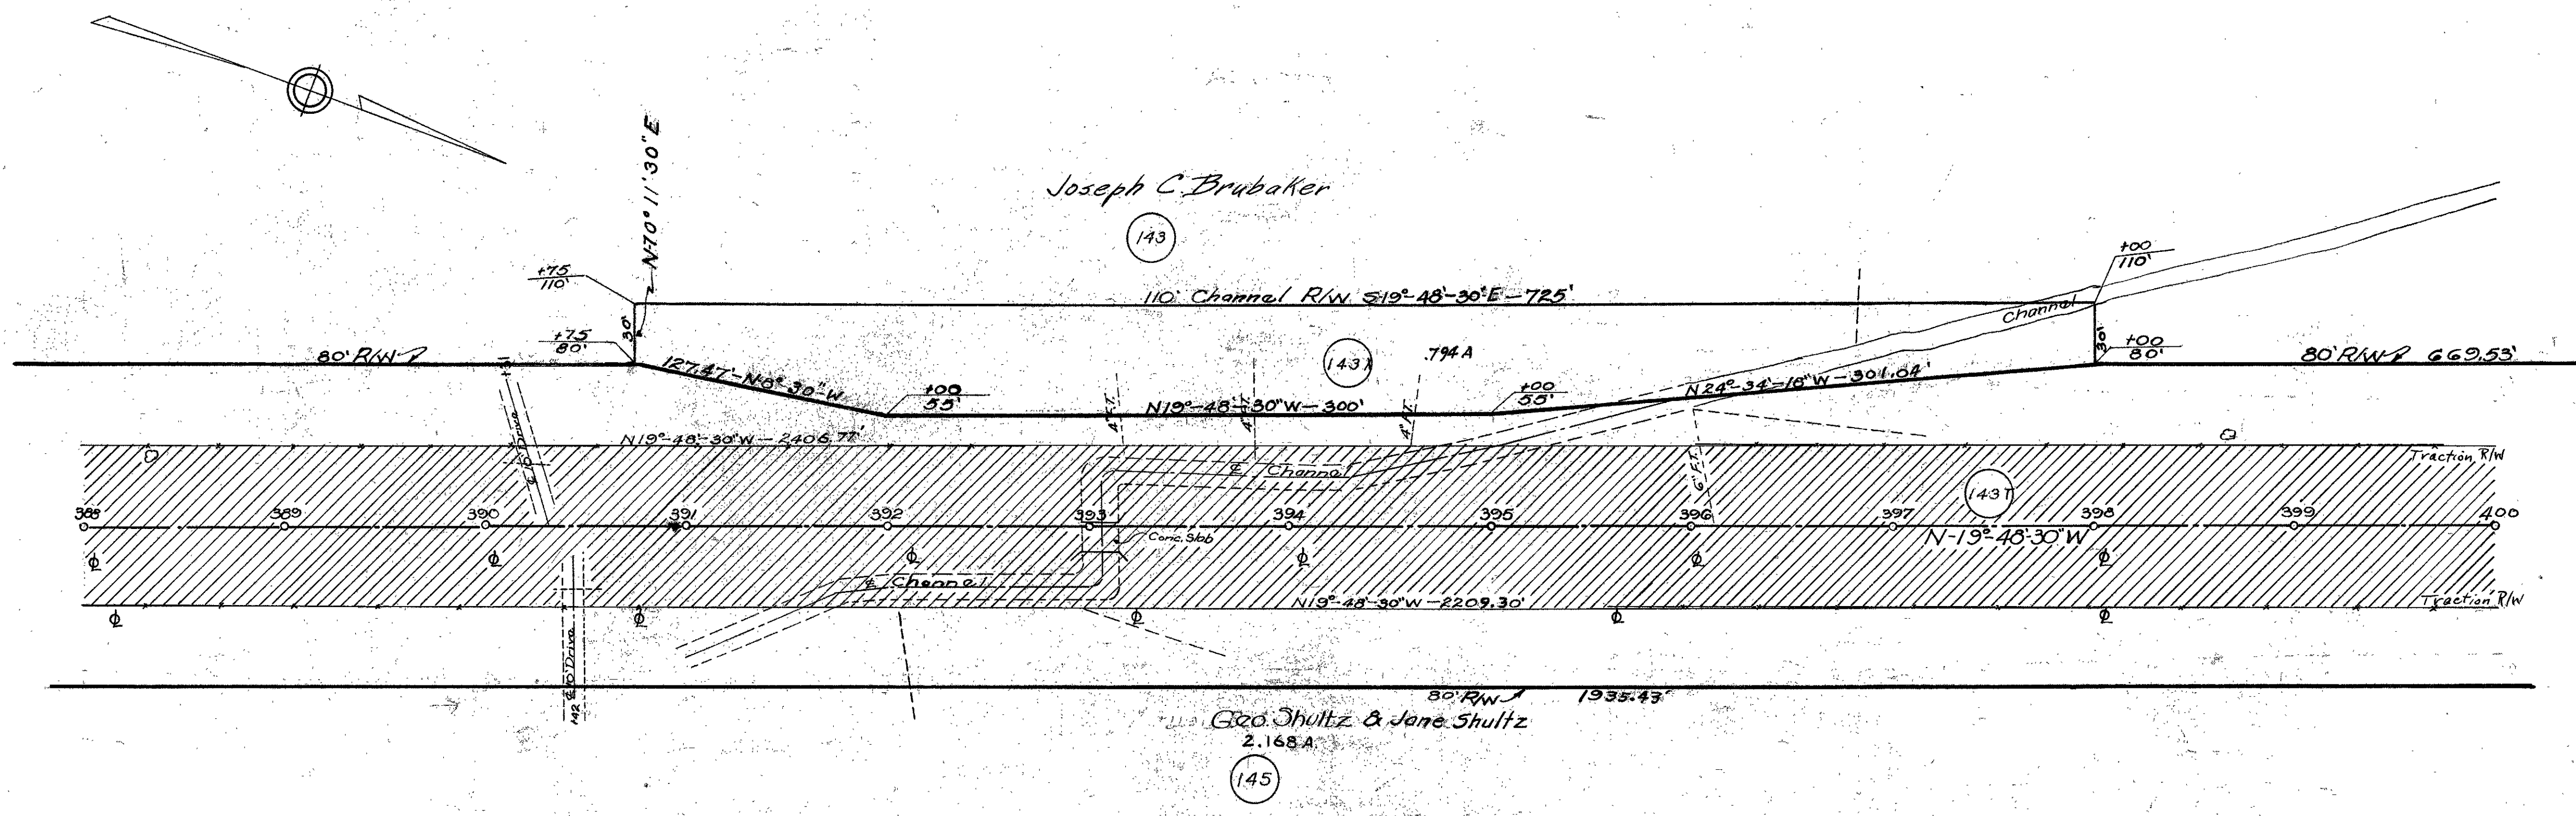

**SEC. 27, T6<sup>S</sup>R8E  
 STOKES TWP.**


Sta 376+00 To Sta 400+00



LOGAN COUNTY  
S.H. 168 RELOCATION  
SEC. F (P) RUSSELLS  
POINT, LAKEVIEW, E (P)  
R/W PLANS


10  
11

DATE \_\_\_\_\_ DRAWN BY \_\_\_\_\_  
REVISED MAY 1946  
LENGTH OF PROJECT \_\_\_\_\_ MILES

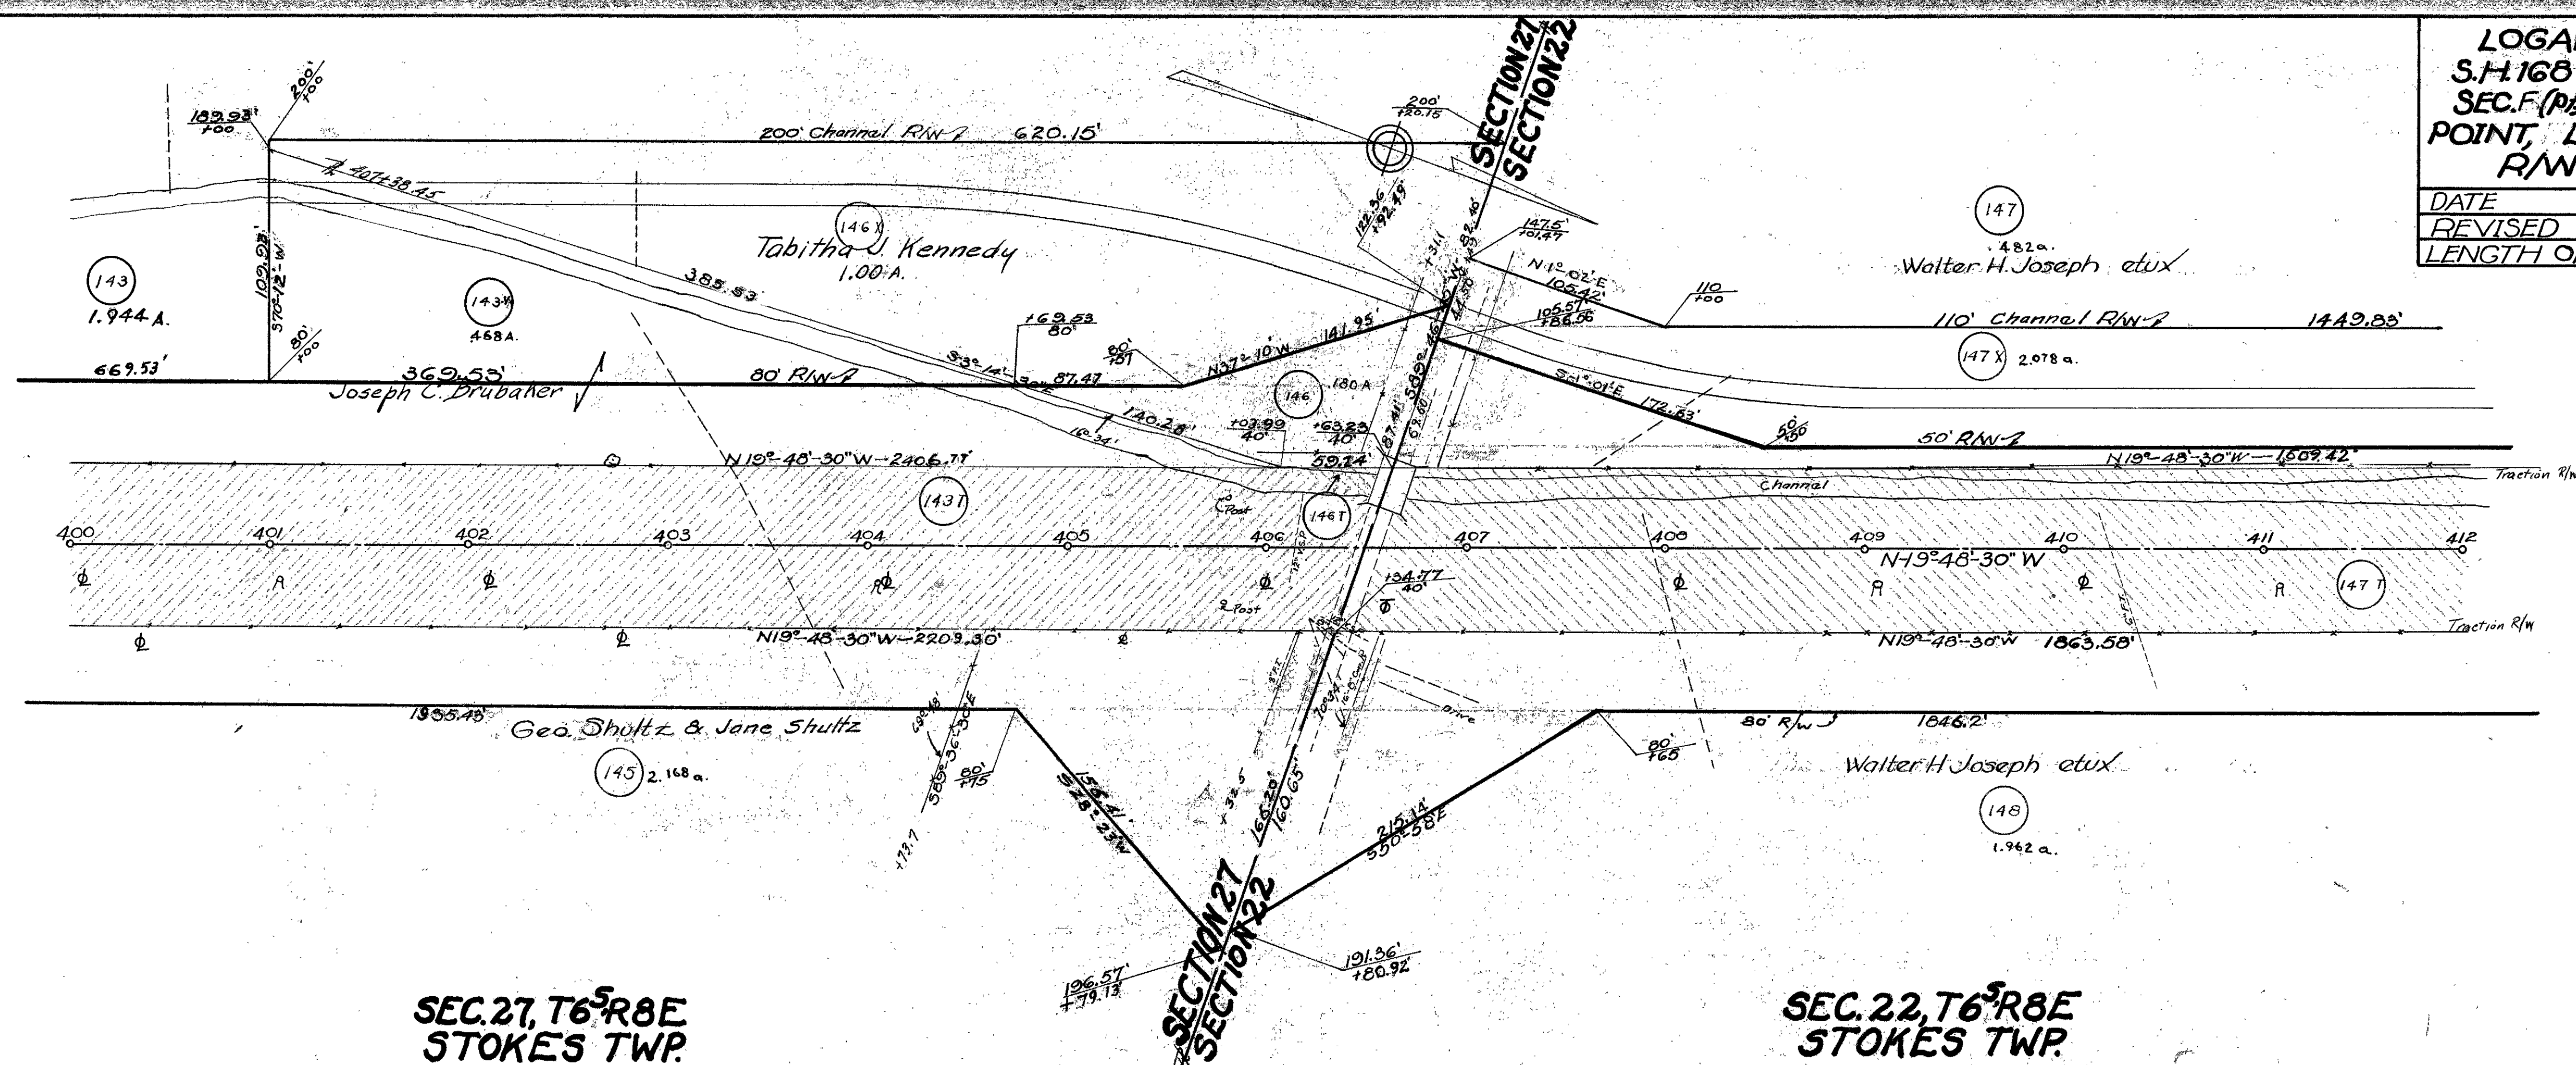

SEC. 27, T6<sup>S</sup> R8E  
STOKES TWP.

SEC. 22, T6<sup>S</sup> R8E  
STOKES TWP.

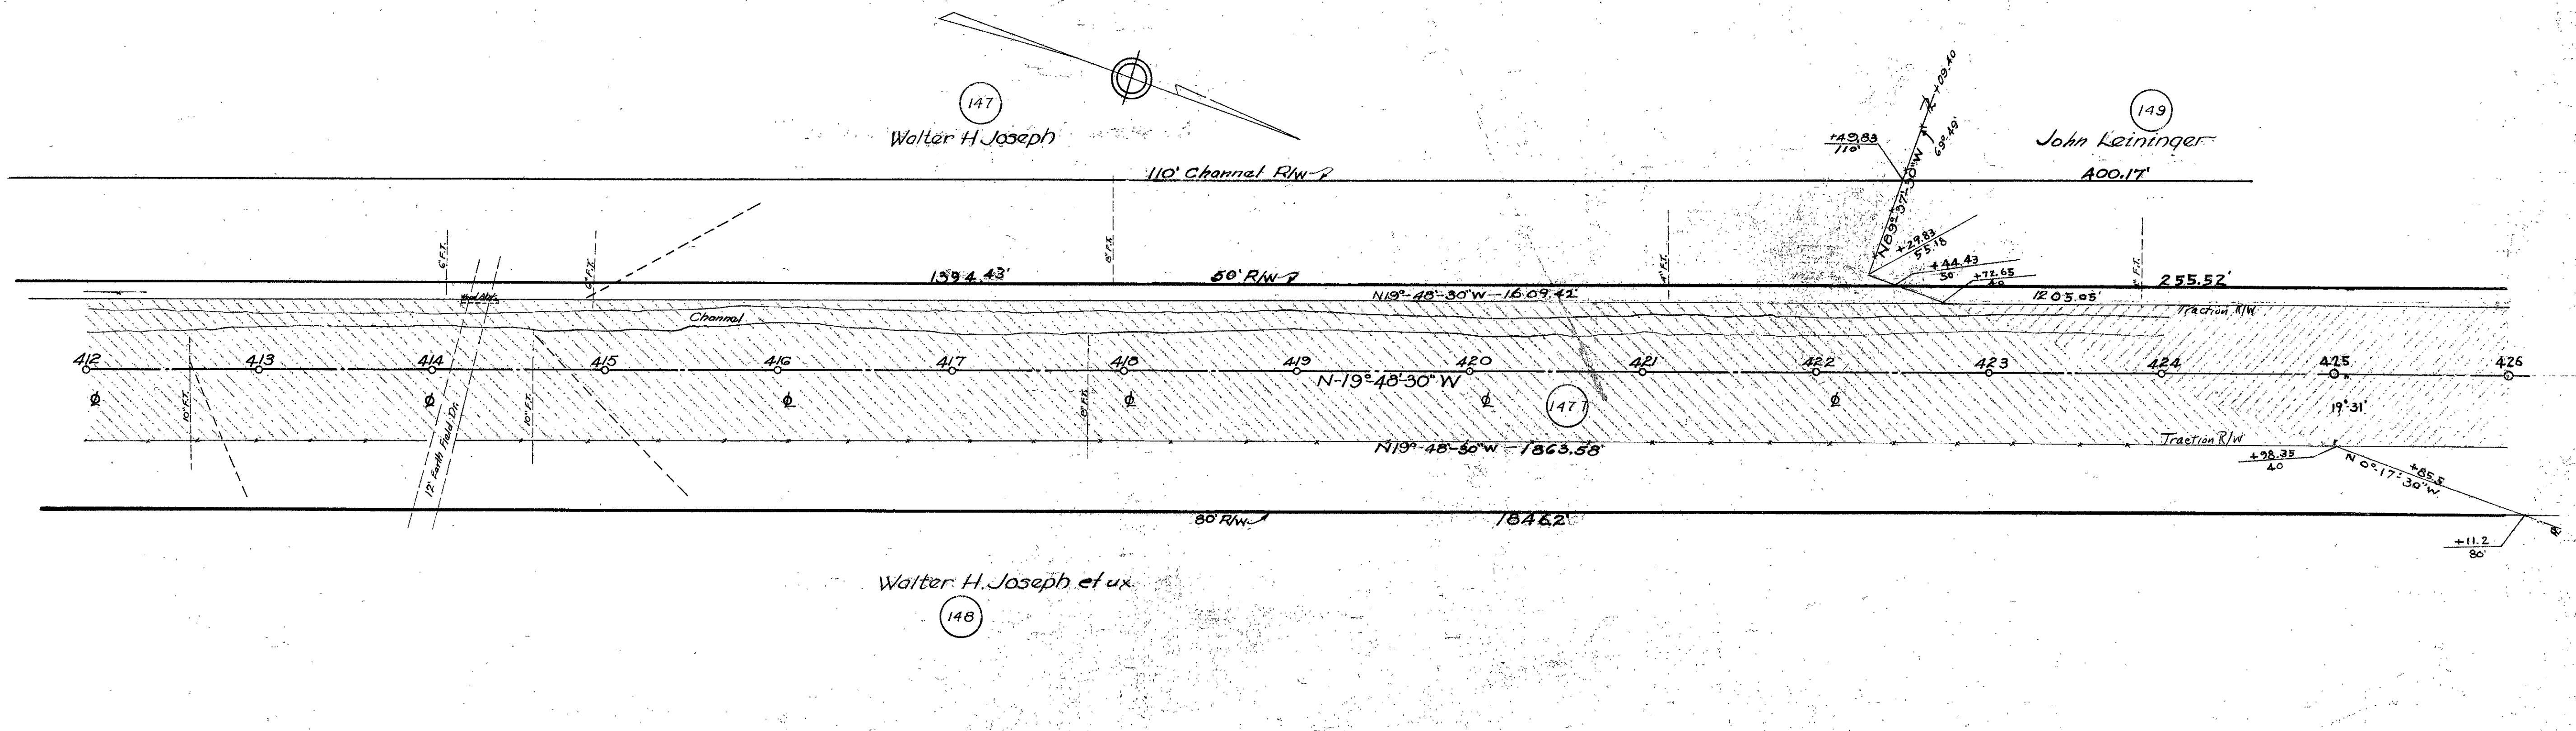


SEC. 22, T6<sup>S</sup> R8E  
STOKES TWP.


Sta 400+00 To Sta 424+00

10



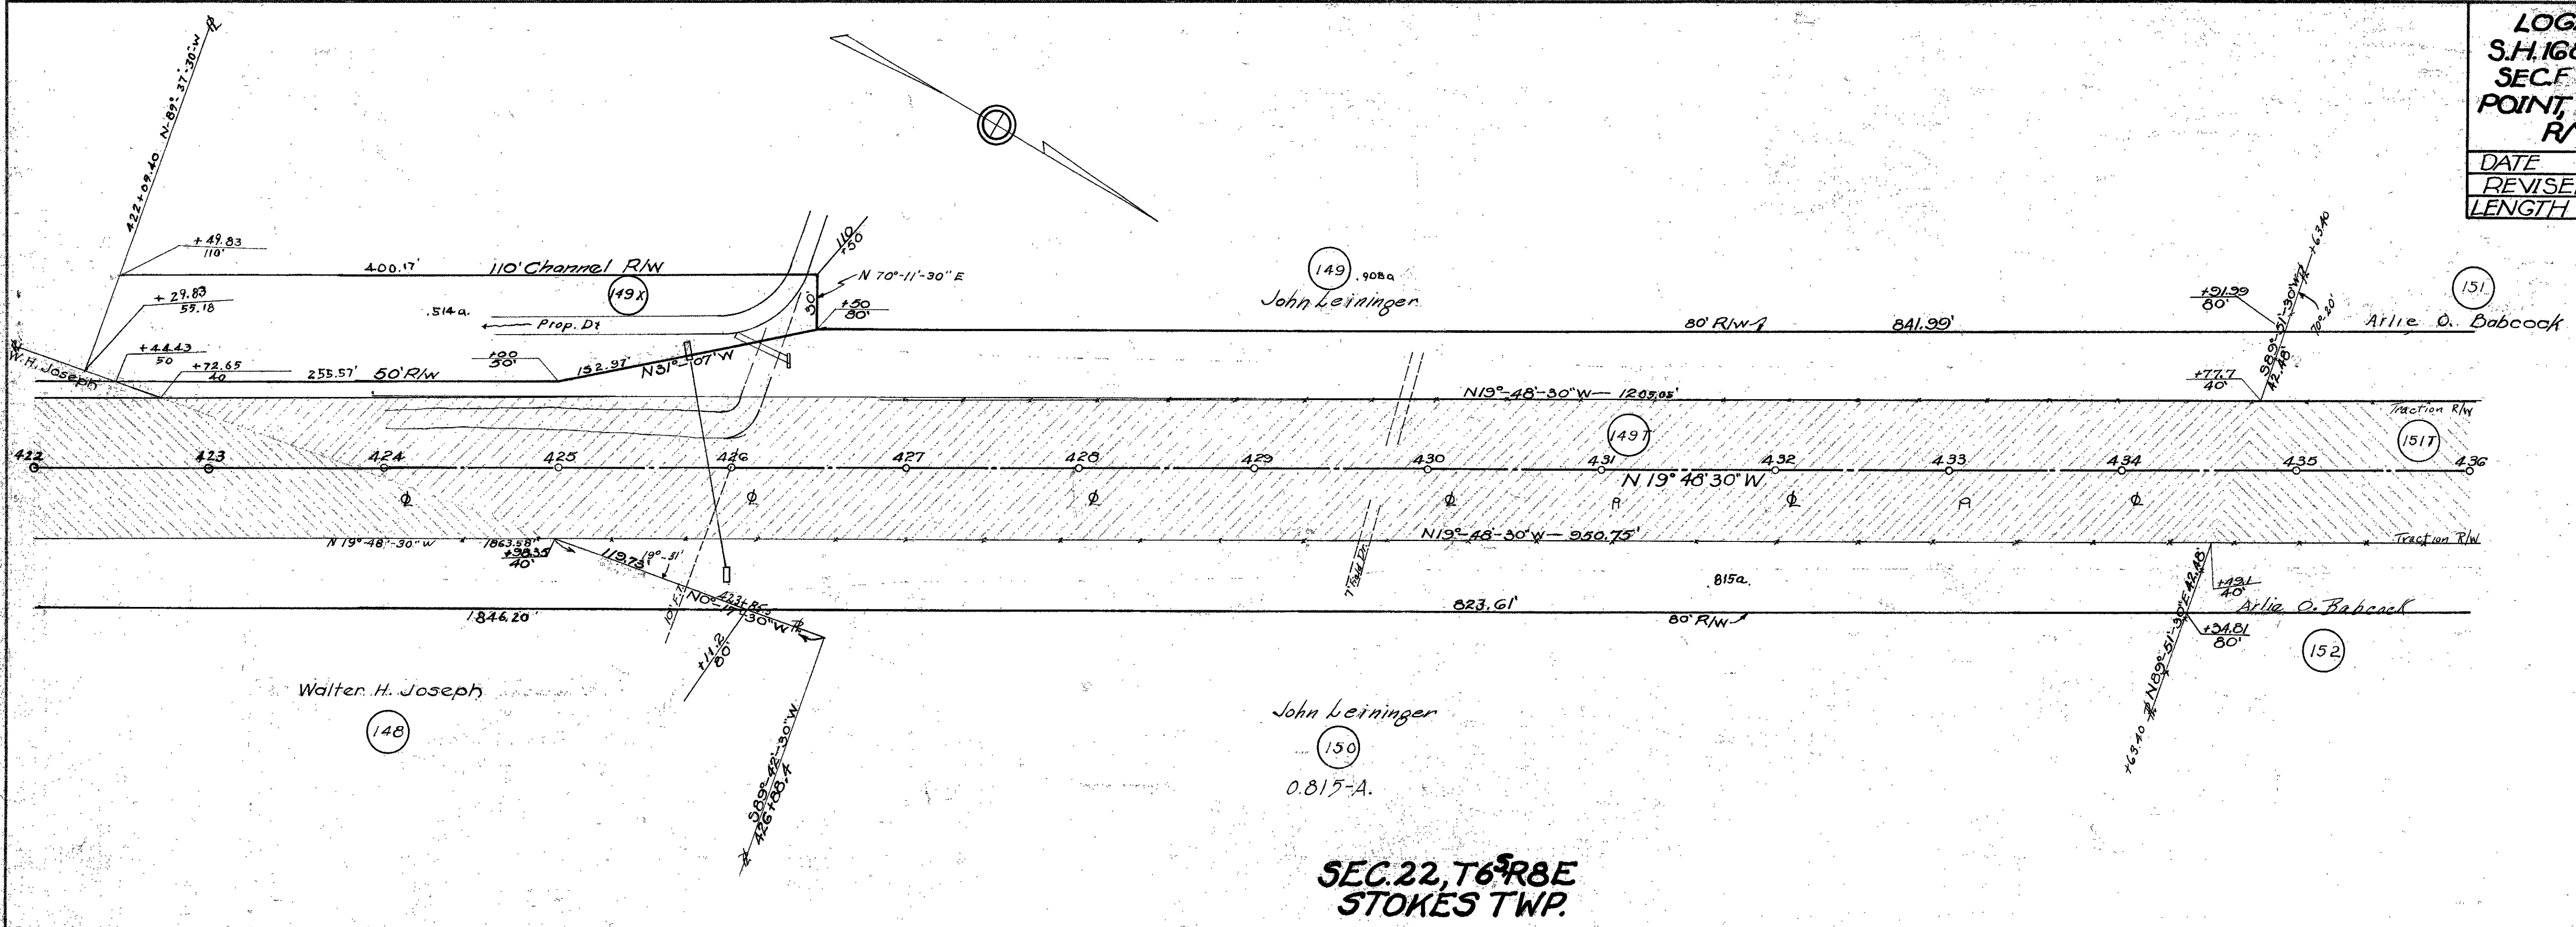

SEC. 22, T6S R8E  
 STOKES TWP.

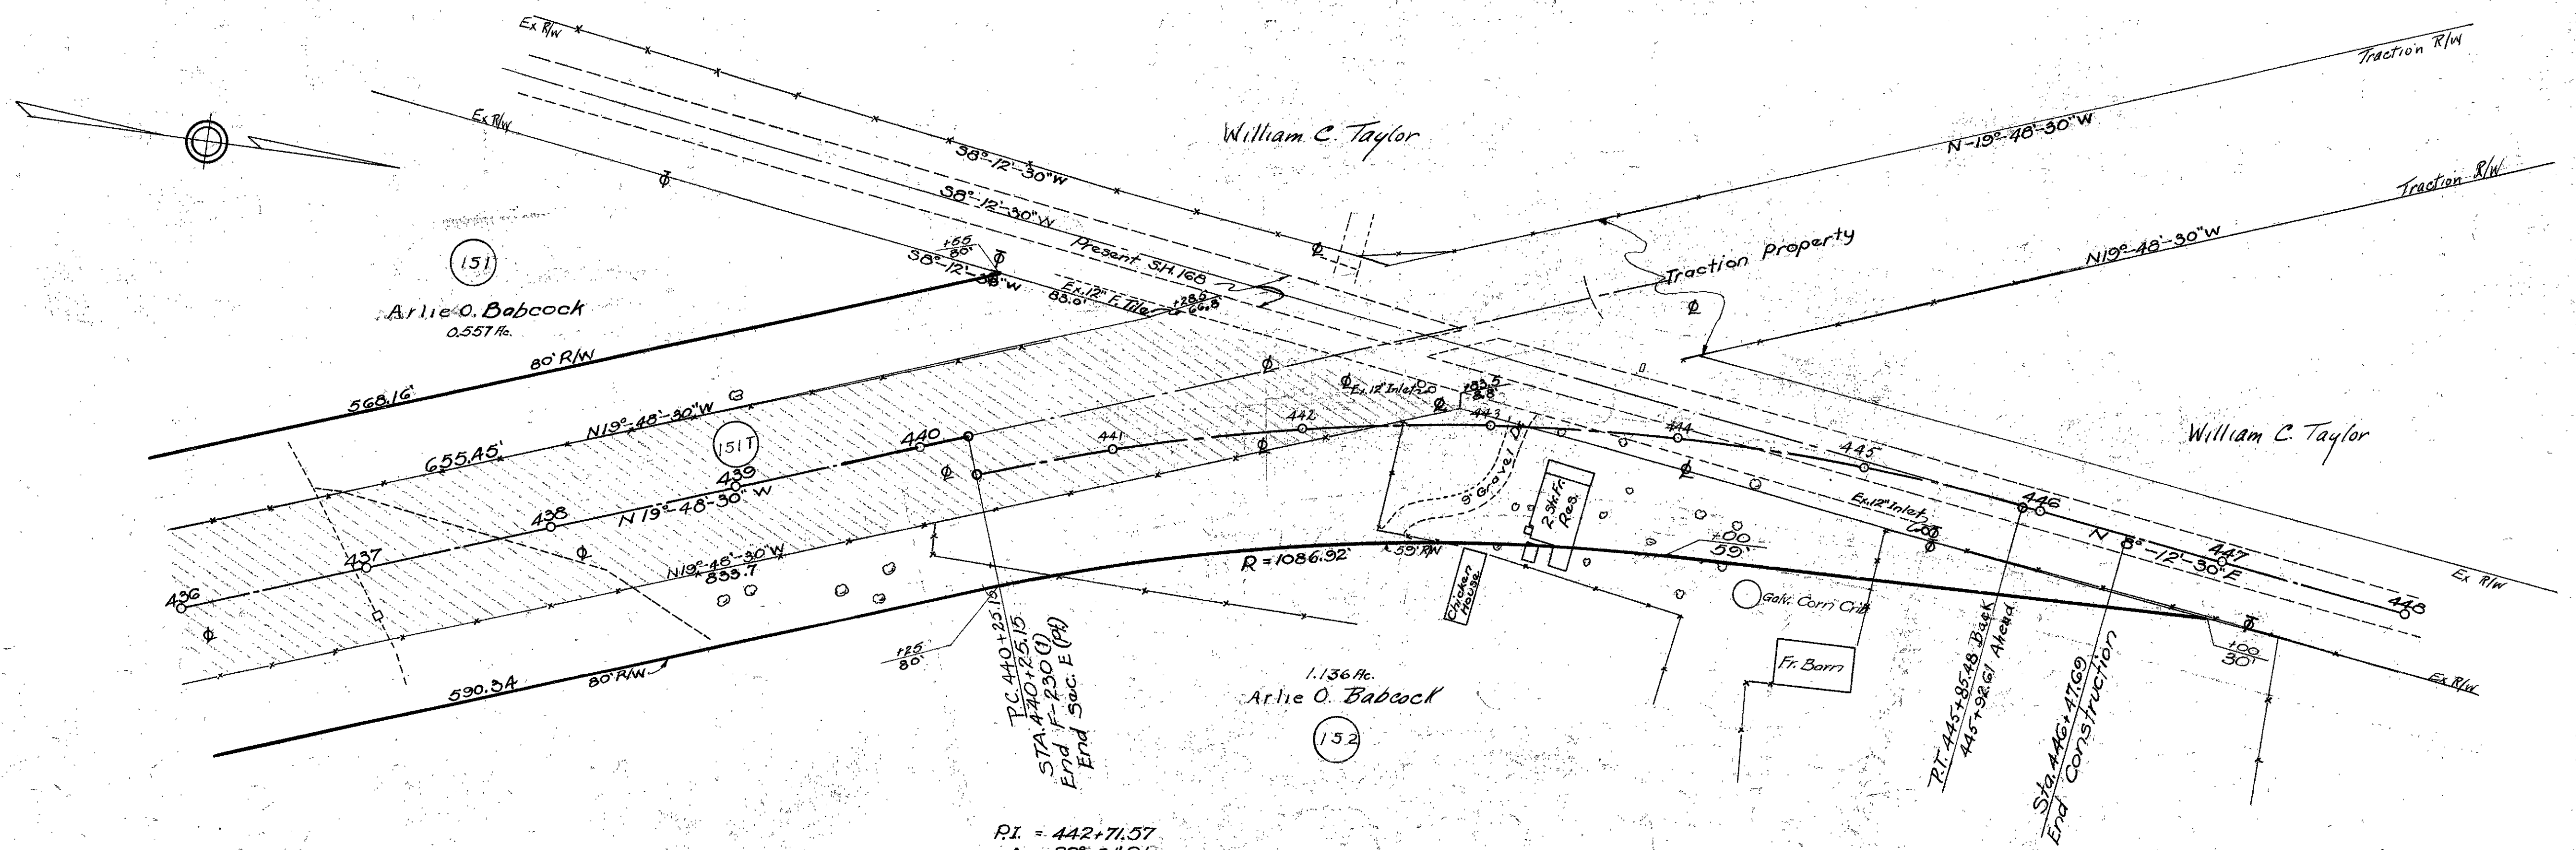

RI = 442+71.57  
 Δ = 28°-01'14"  
 D = 5°-00'  
 T = 285.89'  
 L = 360.33'  
 E = 35.12'  
 R = 1145.92'

SEC. 22, T6S R8E  
 STOKES TWP.

Sta 424+00 To Sta 448+00