

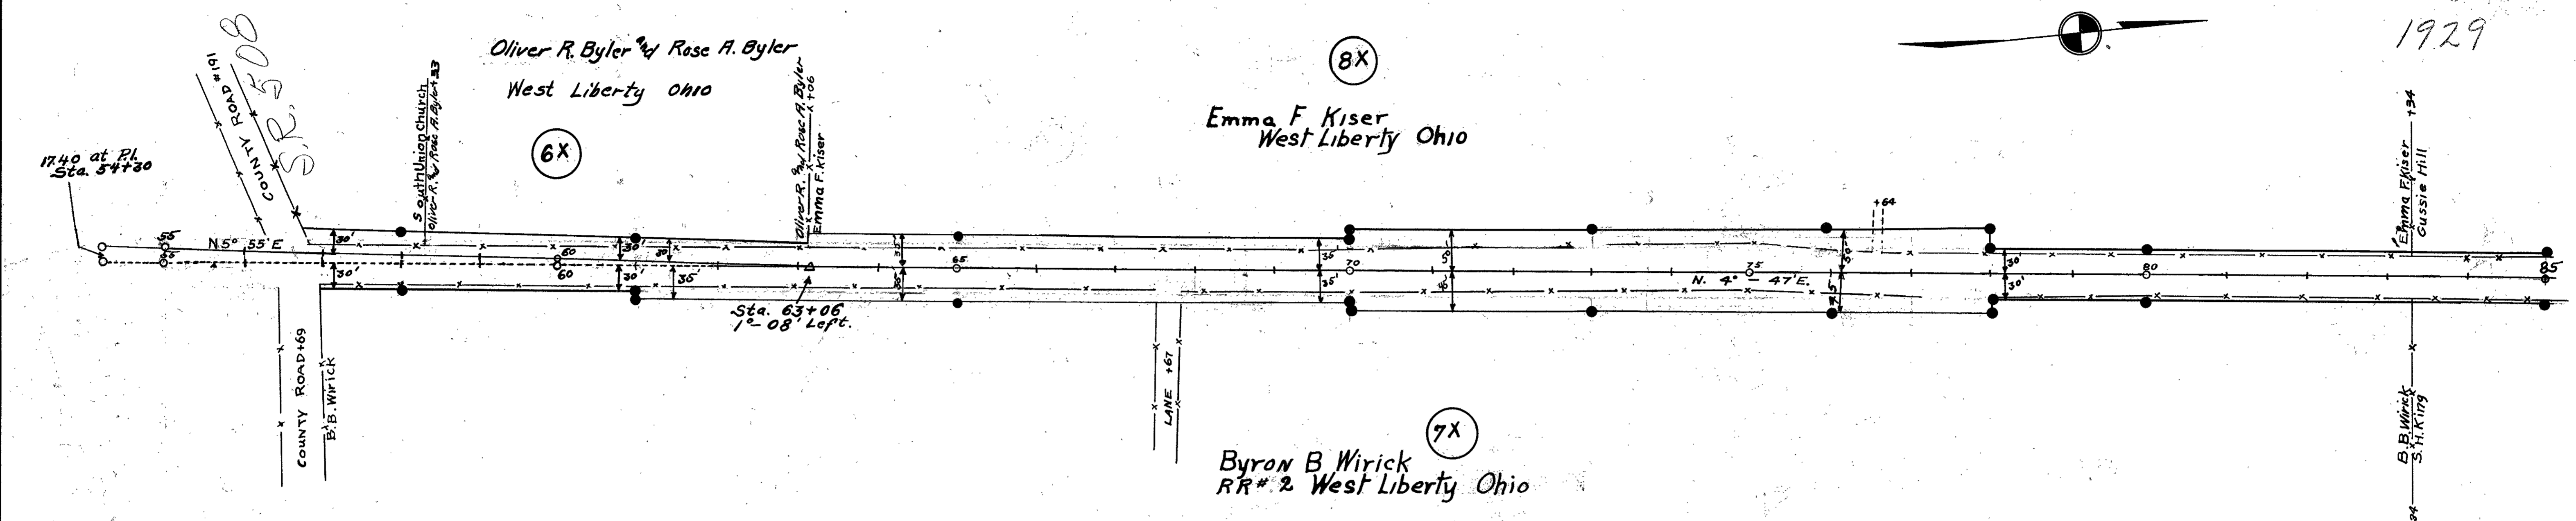
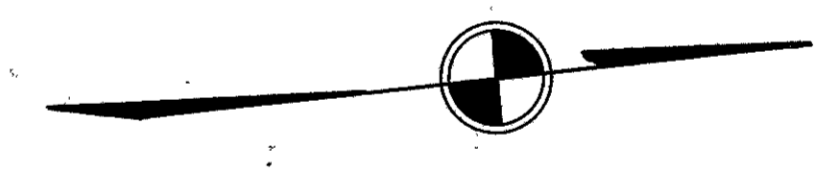


See D&A
 1929

• Indicates R/W Monuments

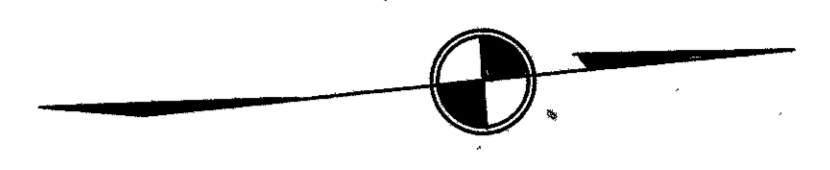


Survey Notes in Logan County
 Surveyor's Books No. 508

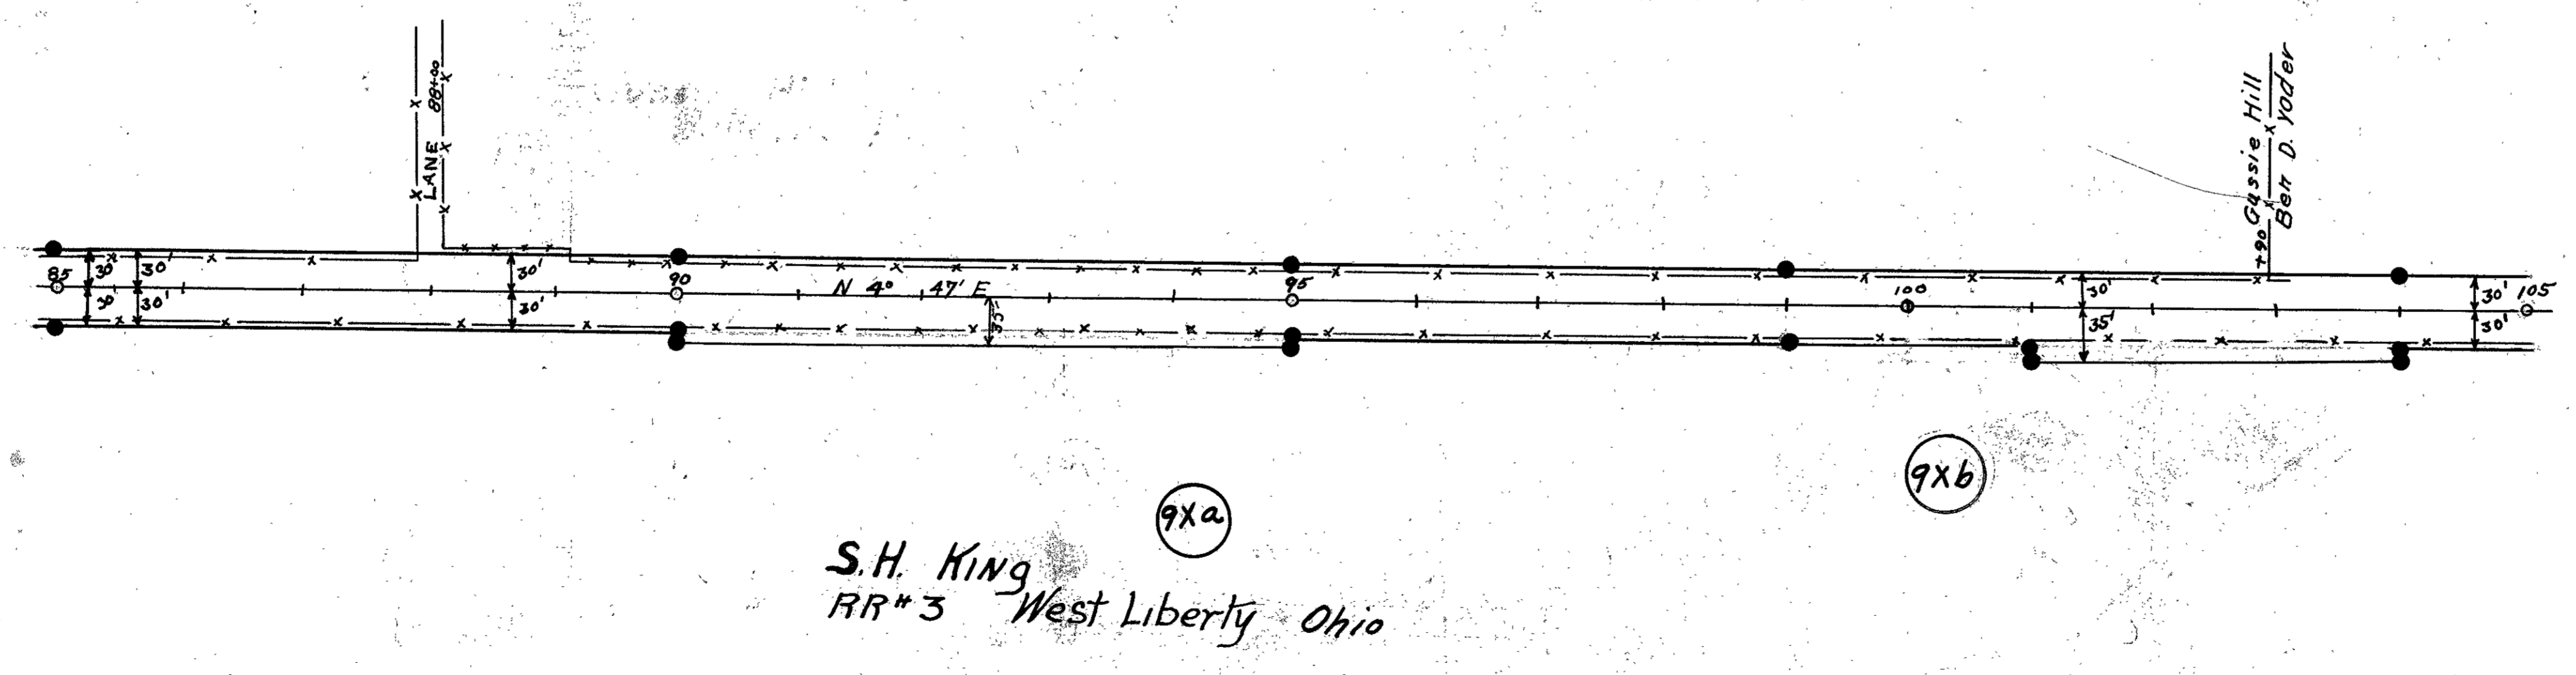


See D&A
1929

● Indicates R/W Monuments

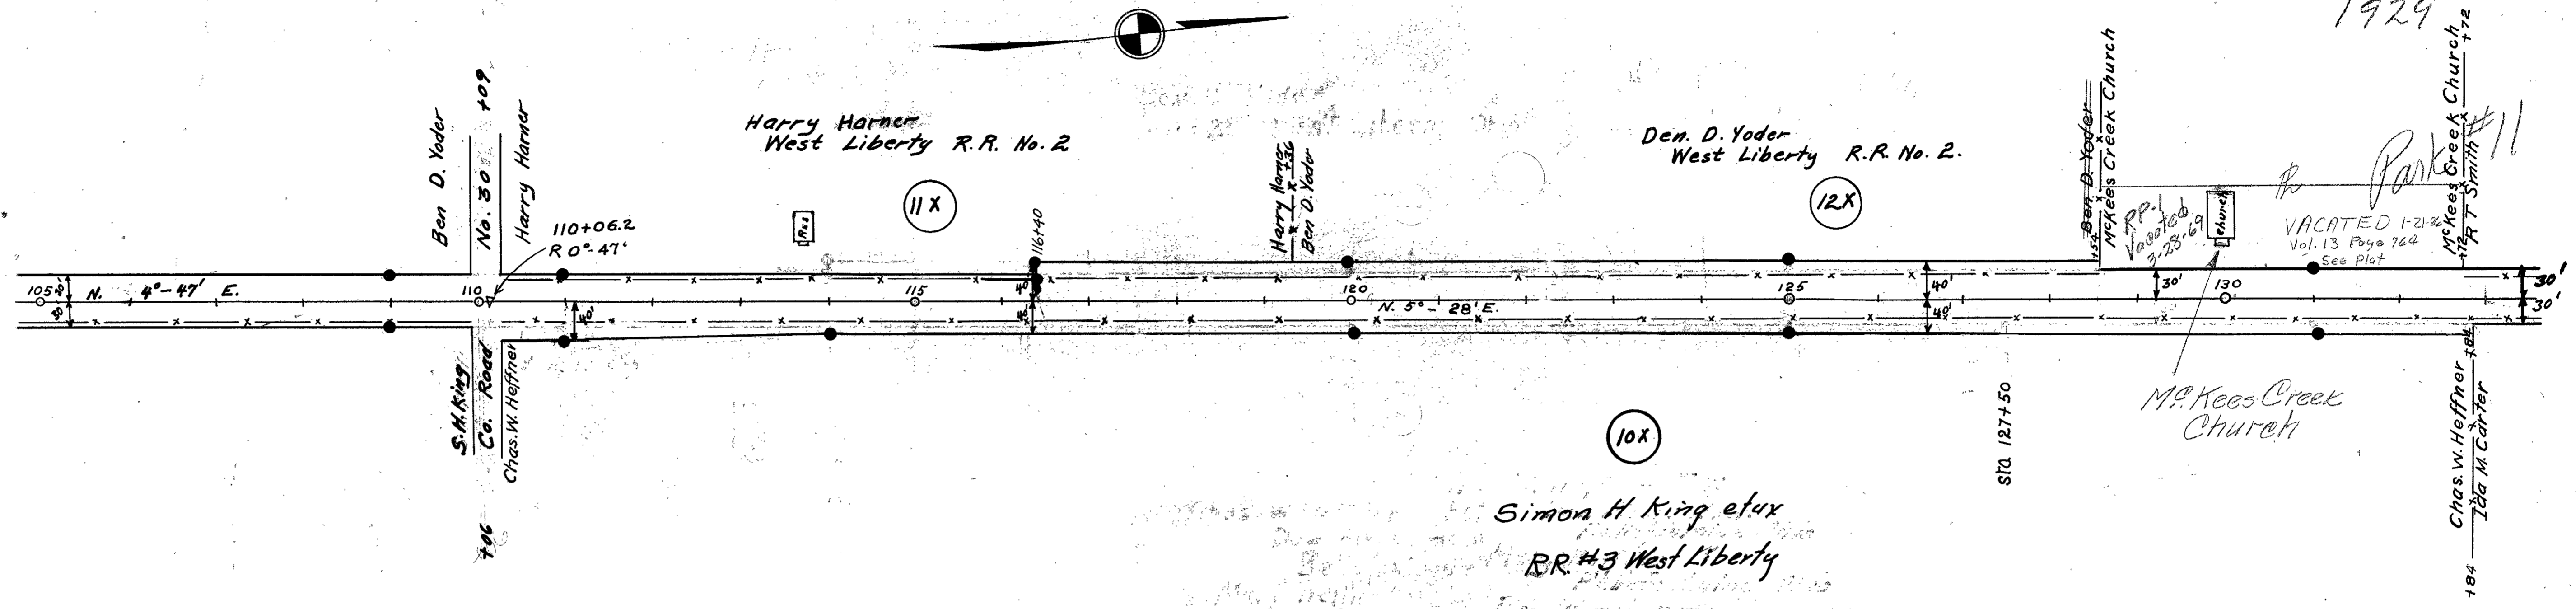

Field Notes in Logan County
Surveys Book No. 508

Park #11

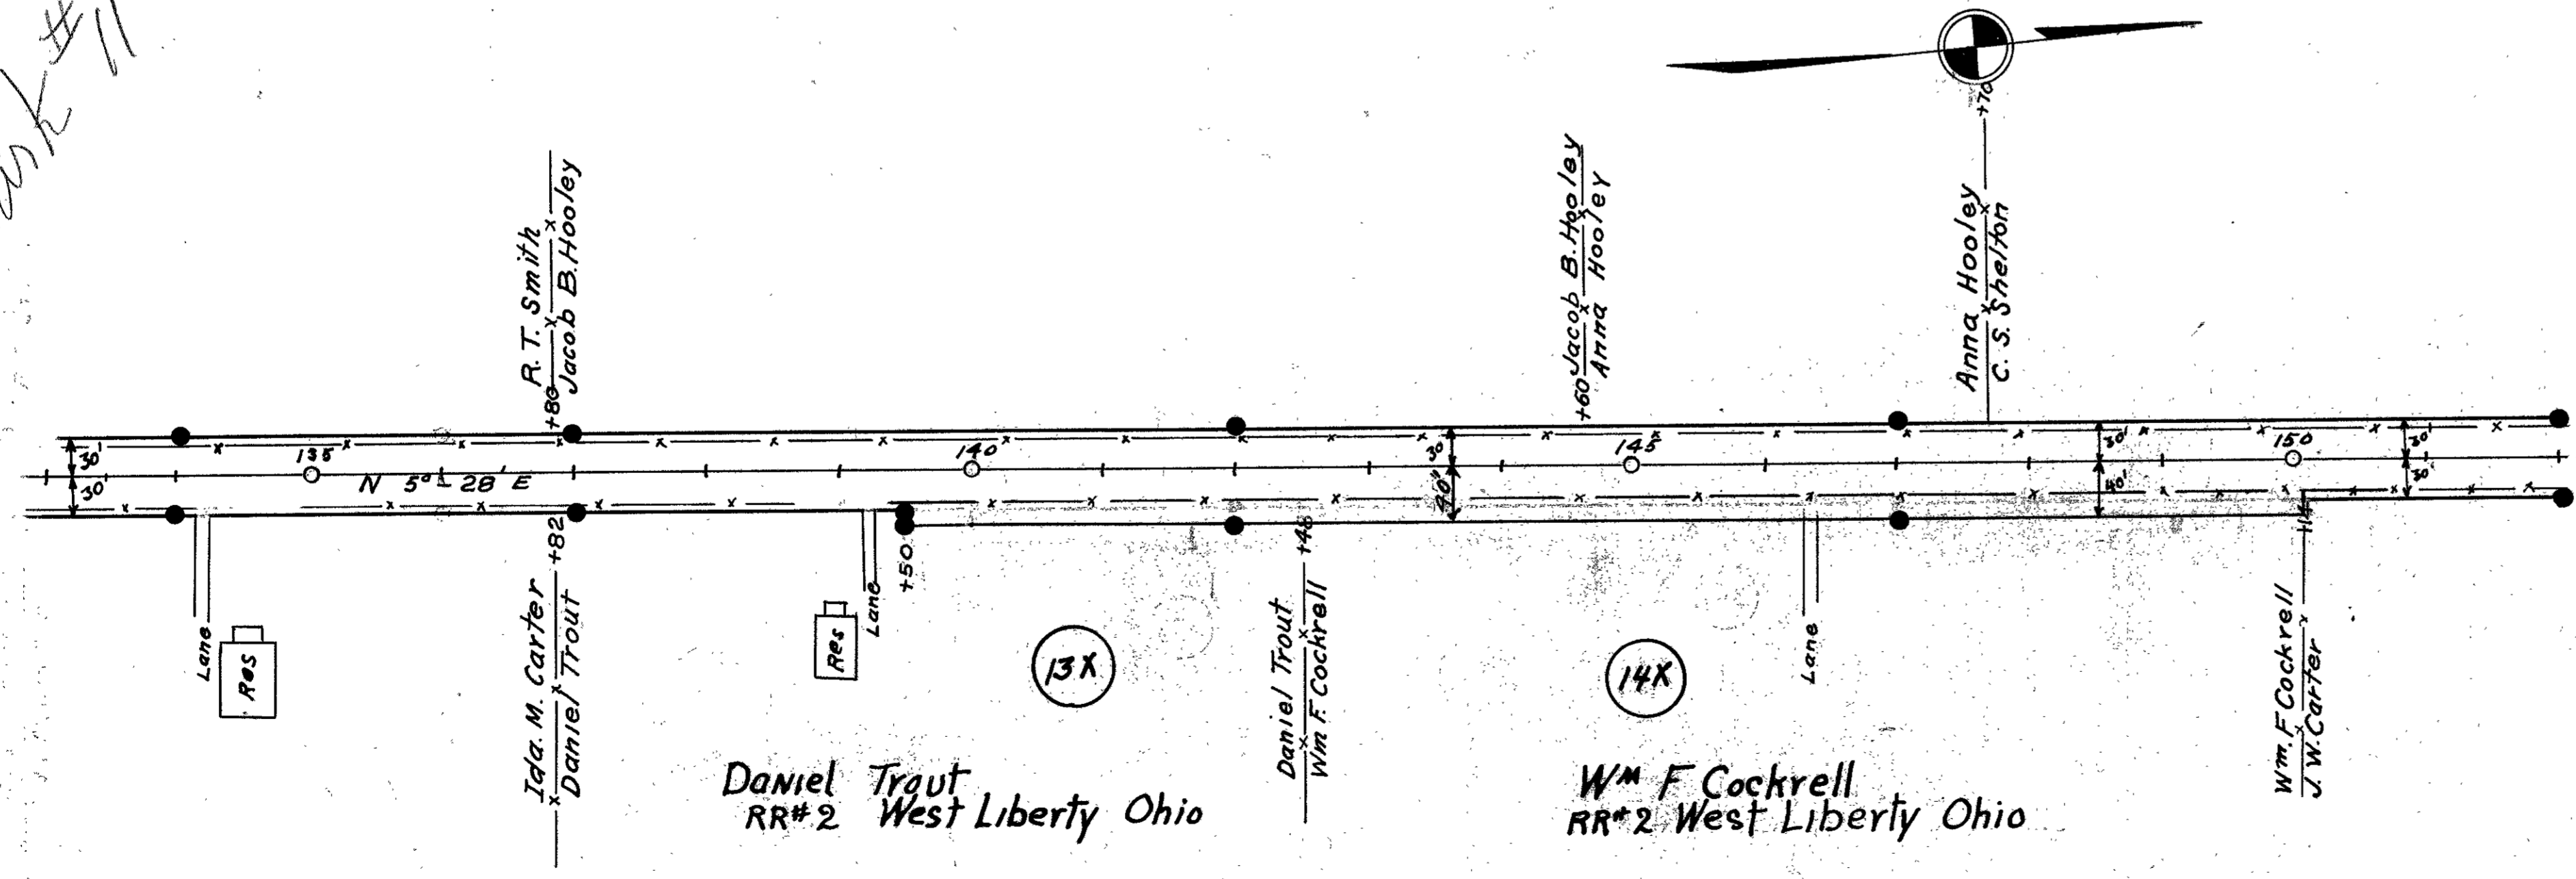


1929

• Indicates R/W Monuments.

Simon King
 R.R. 2 West Liberty Ohio

Elisha Ford Et. Ux.
 R.R. Bellefontaine Ohio.

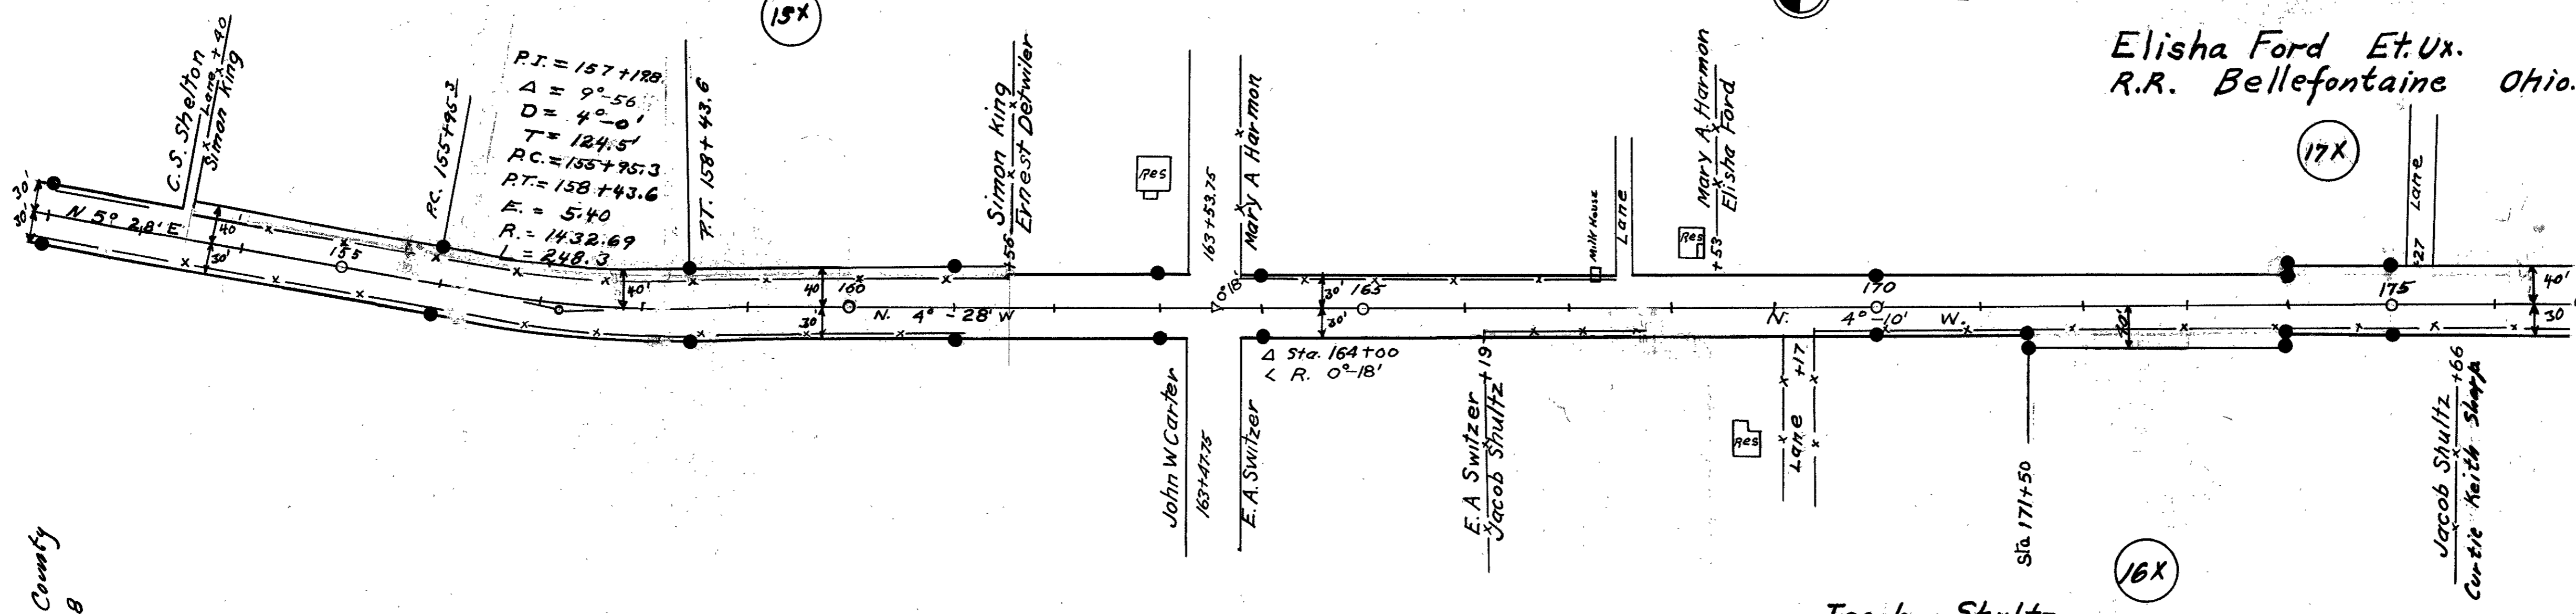

Jacob Shultz
 R.R. 3 Bellefontaine Ohio

John D. Bray et al
 West Mansfield Ohio R.R. No. 3


Joseph F. King
 R.R. 7 Bellefontaine Ohio

Curtis Keith Sharp
 1109 W. Columbus Ave Bellefontaine Ohio
 Samuel Barrett
 R.R. 7 Bellefontaine Ohio

Field Notes in Logan County
 Surveyor's Book 508


1929

● Indicates R/W Monuments.

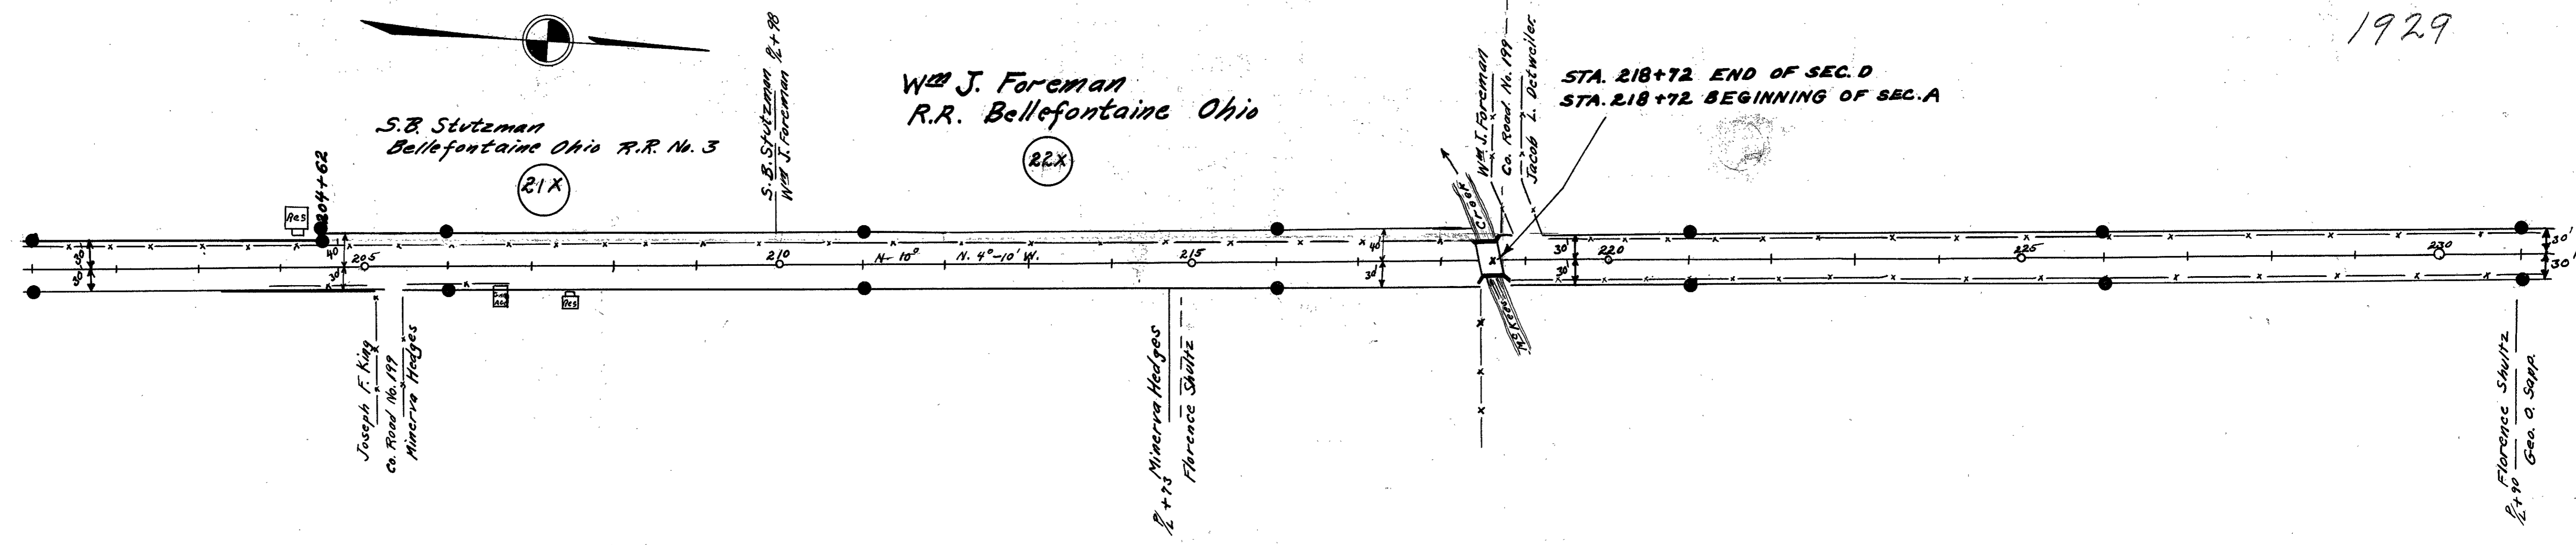

Field Notes in Logan County
Surveyor's Book No. 508


Jacob Detweiler
R.R. West Liberty Ohio

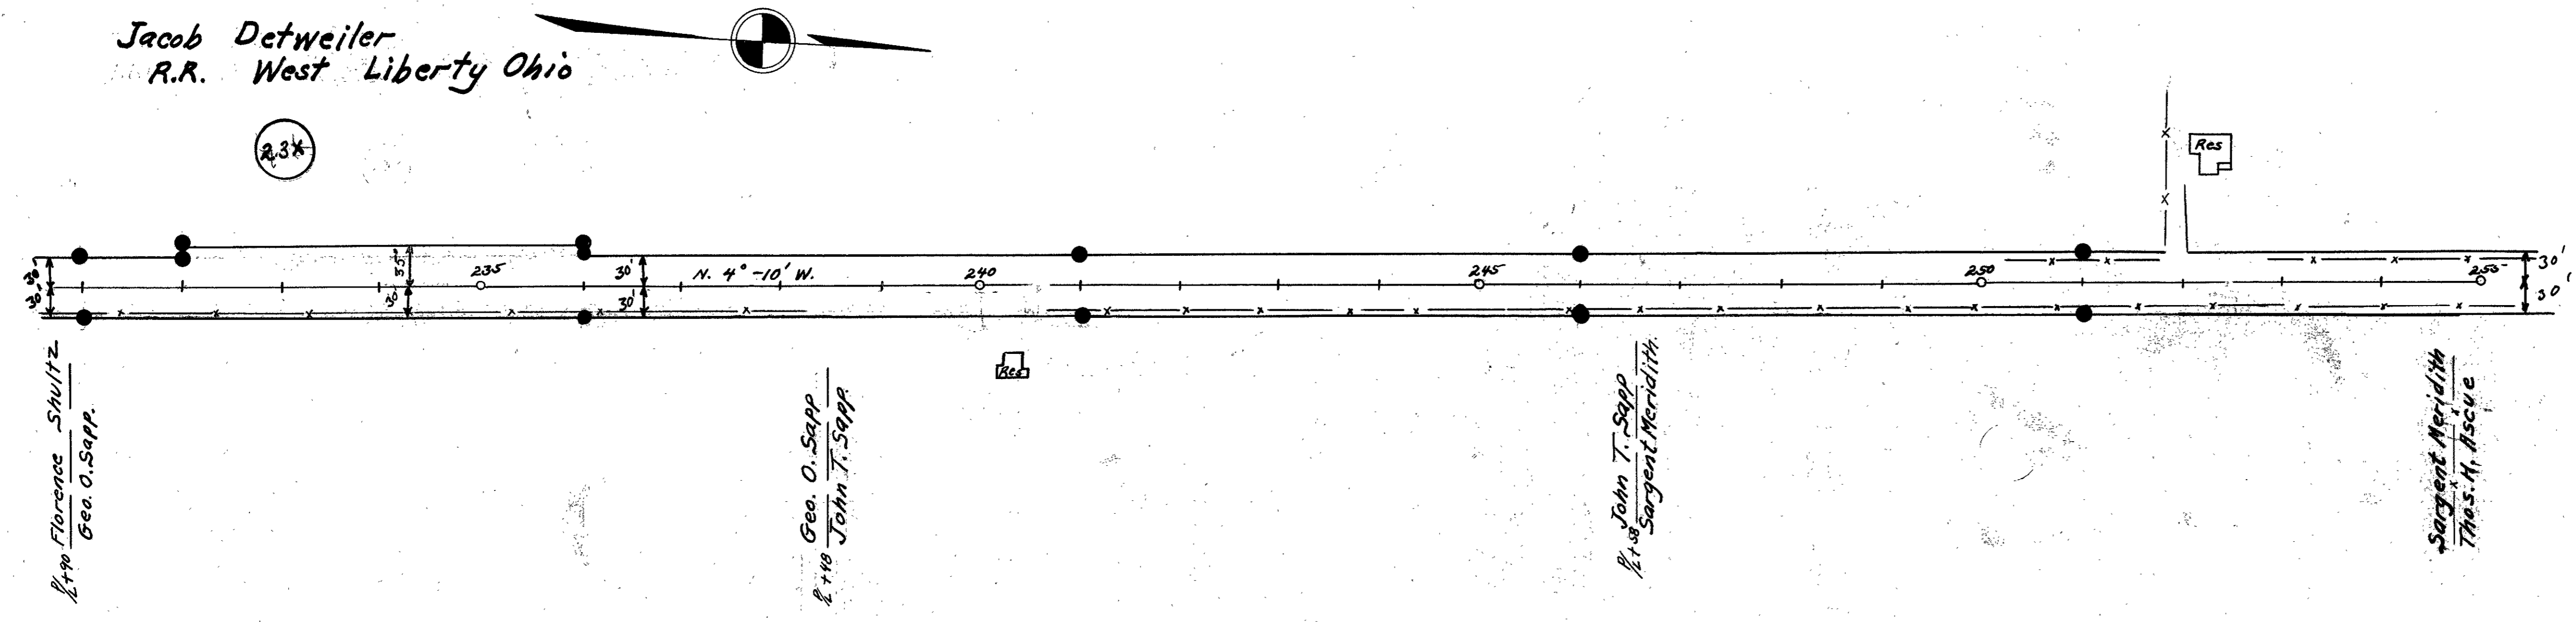

45R63

See plan
1929


● Indicates R/W Monuments

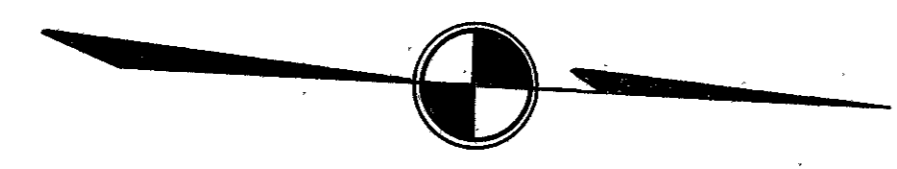

Field Notes in Logan County
Surveyor's Book No. 508

W.L. Bluck Et. ux
Wilmington Ohio.


24X

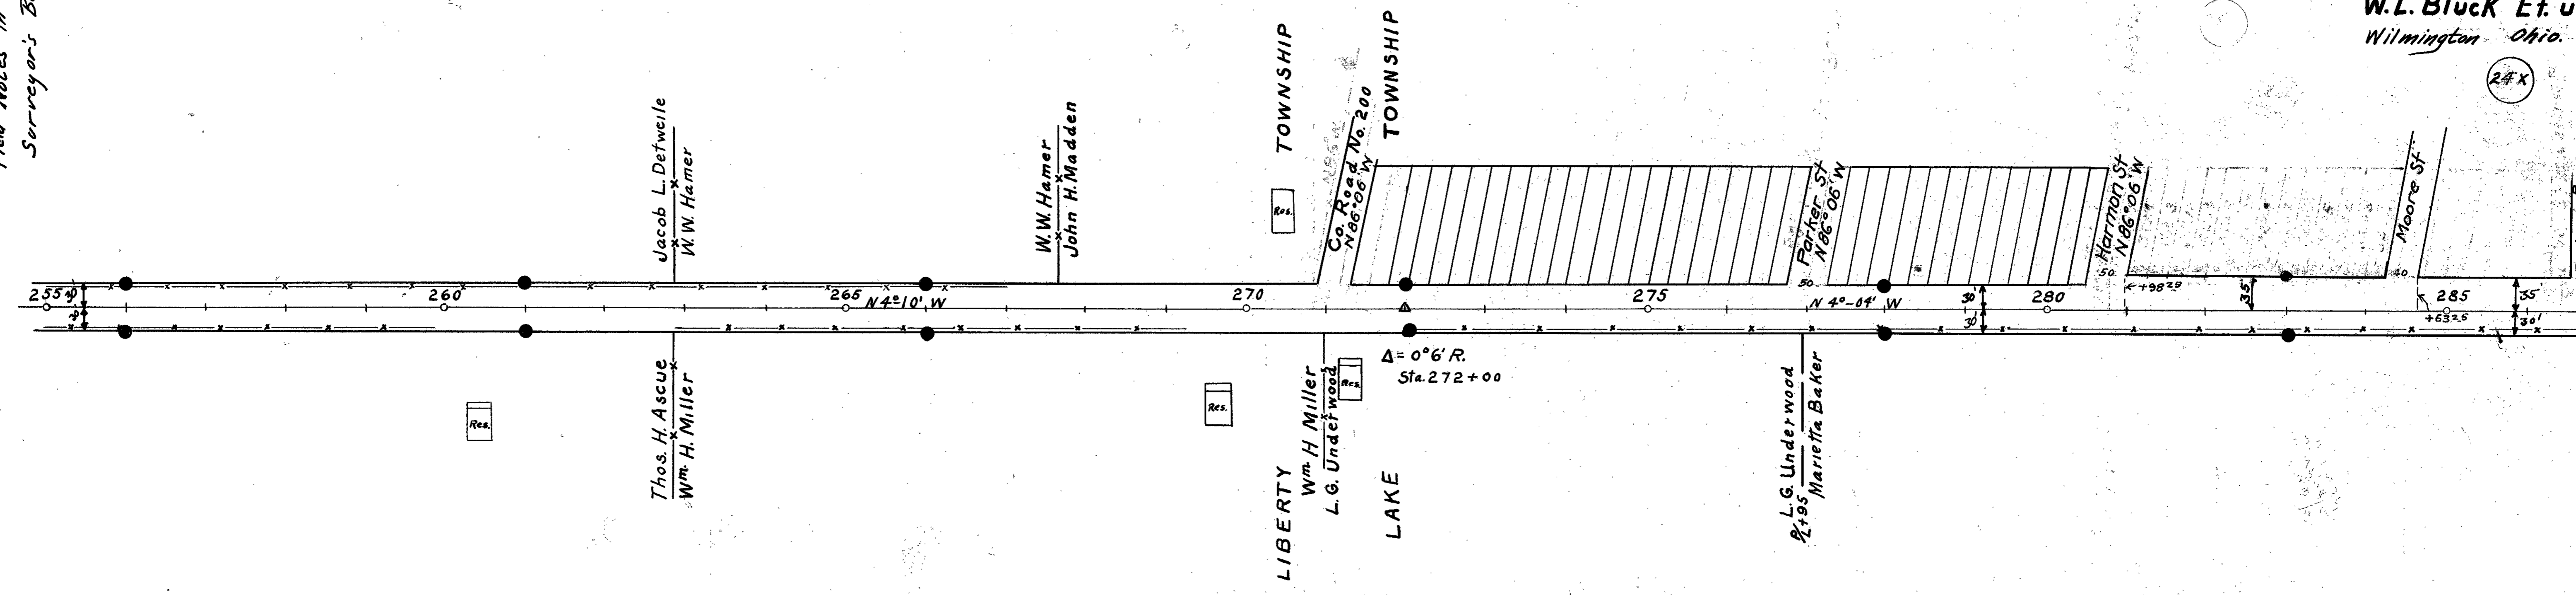

• indicates R/W Monuments

1929

Field Notes in Logan County
Surveys Book 308
1929

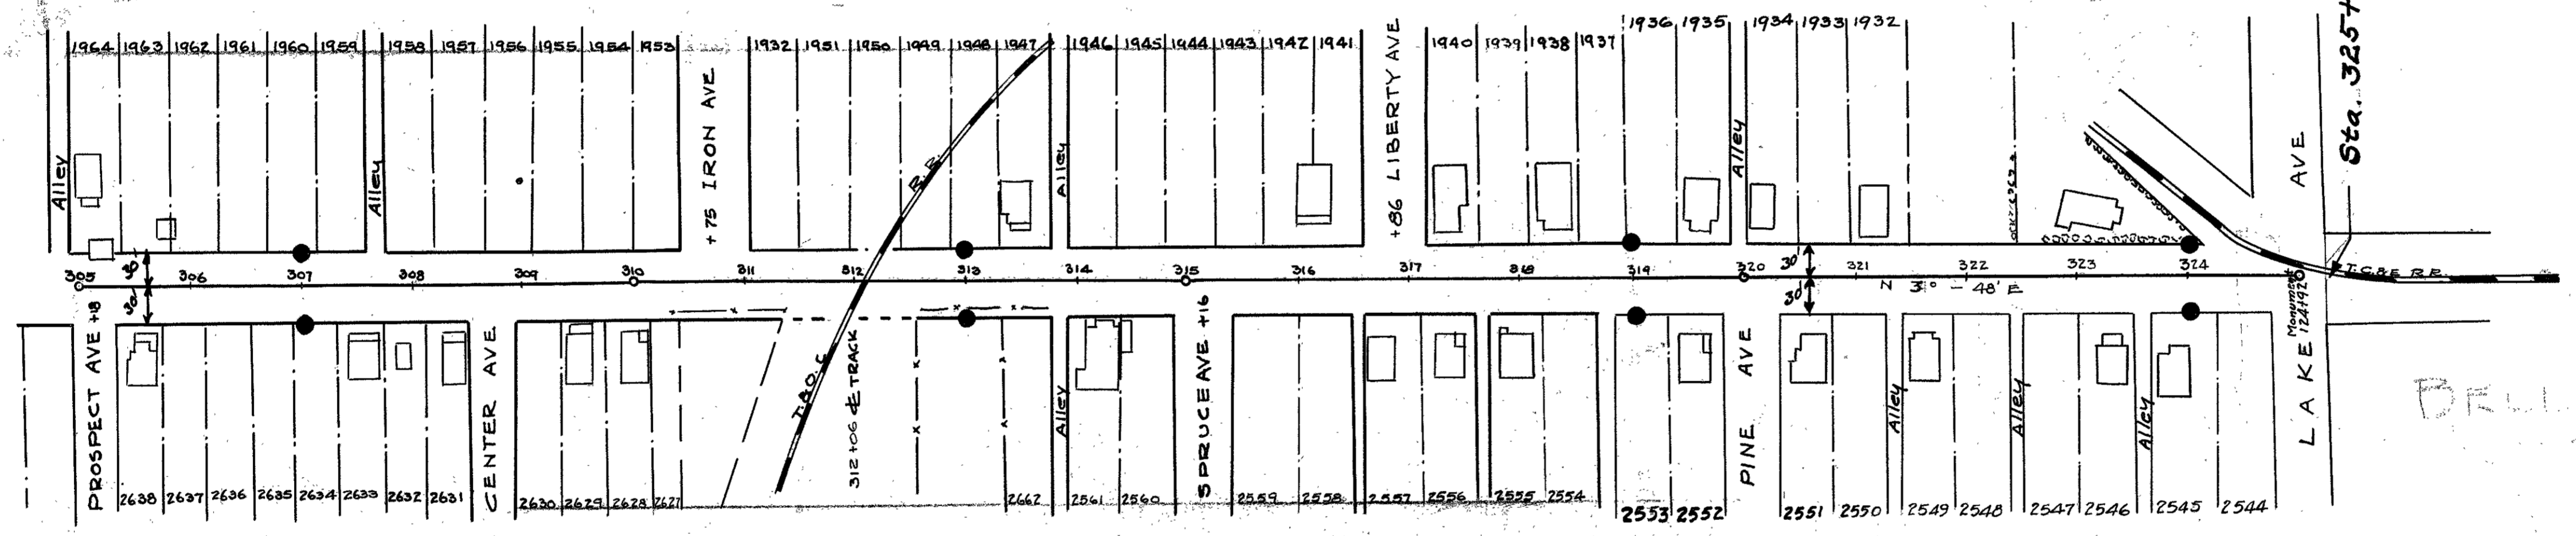

Sta. 325+16 End of Project

BELLEFONTAINE

IRON CITY