


PITTMAN SURVEY


BELLEFONTAINE, OHIO

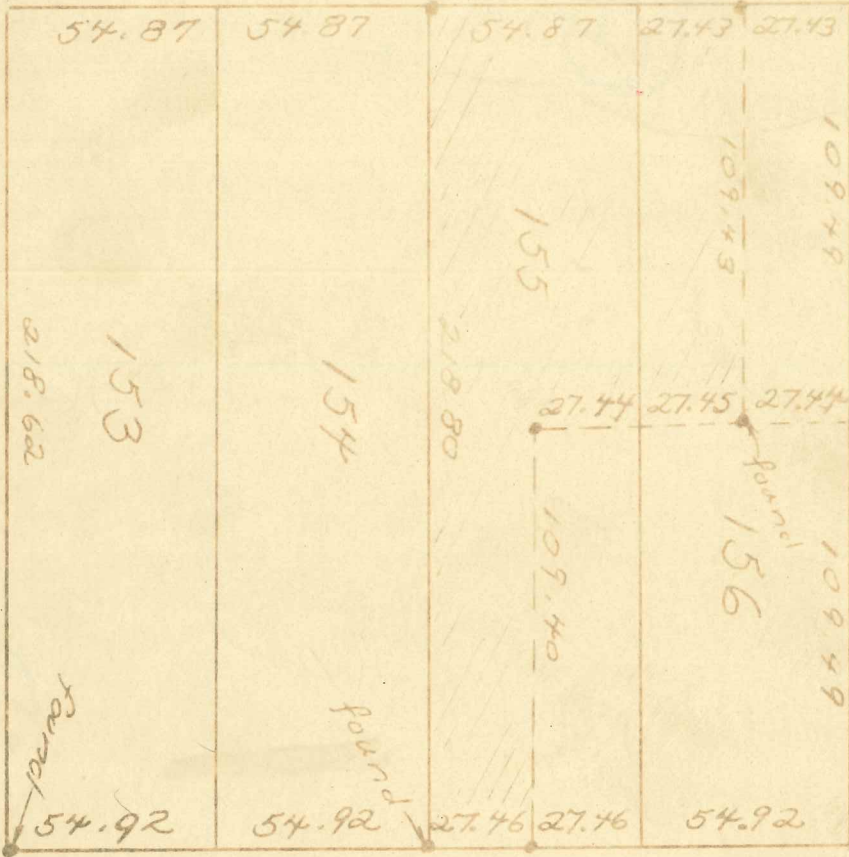

MAD RIVER

AUBURN

Charles K. Shirk
Surveyor 4271

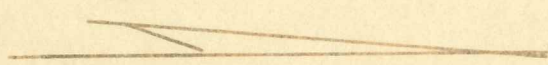

6093 IP

INDEXED ON MAP