


Survey of Maudel. Wharton Land
for Standard Oil Co. in Belle Center
2/15, 1917

Main St

James Crane, Assis't

786

INDEXED ON MAP

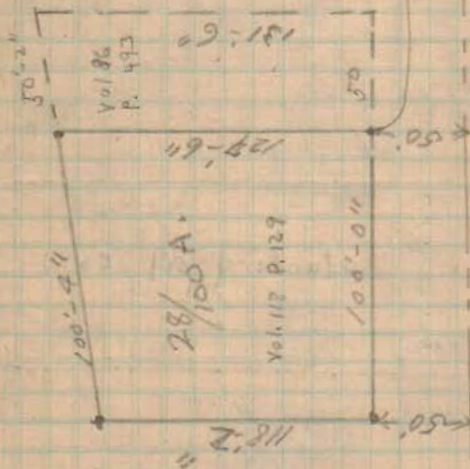

Set iron pins at corners

C.S. & C.R.R.

$$\begin{array}{r} 127.50 \\ 50.00 \\ \hline 177.50 \end{array}$$

$$\begin{array}{r} 25.7 \\ 28.3 \\ 20.0 \\ \hline 174.0 \end{array}$$

$$\begin{array}{r} 116.50 \\ 65.00 \\ \hline 181.50 \end{array}$$