


ELIZABETH ST. (60')

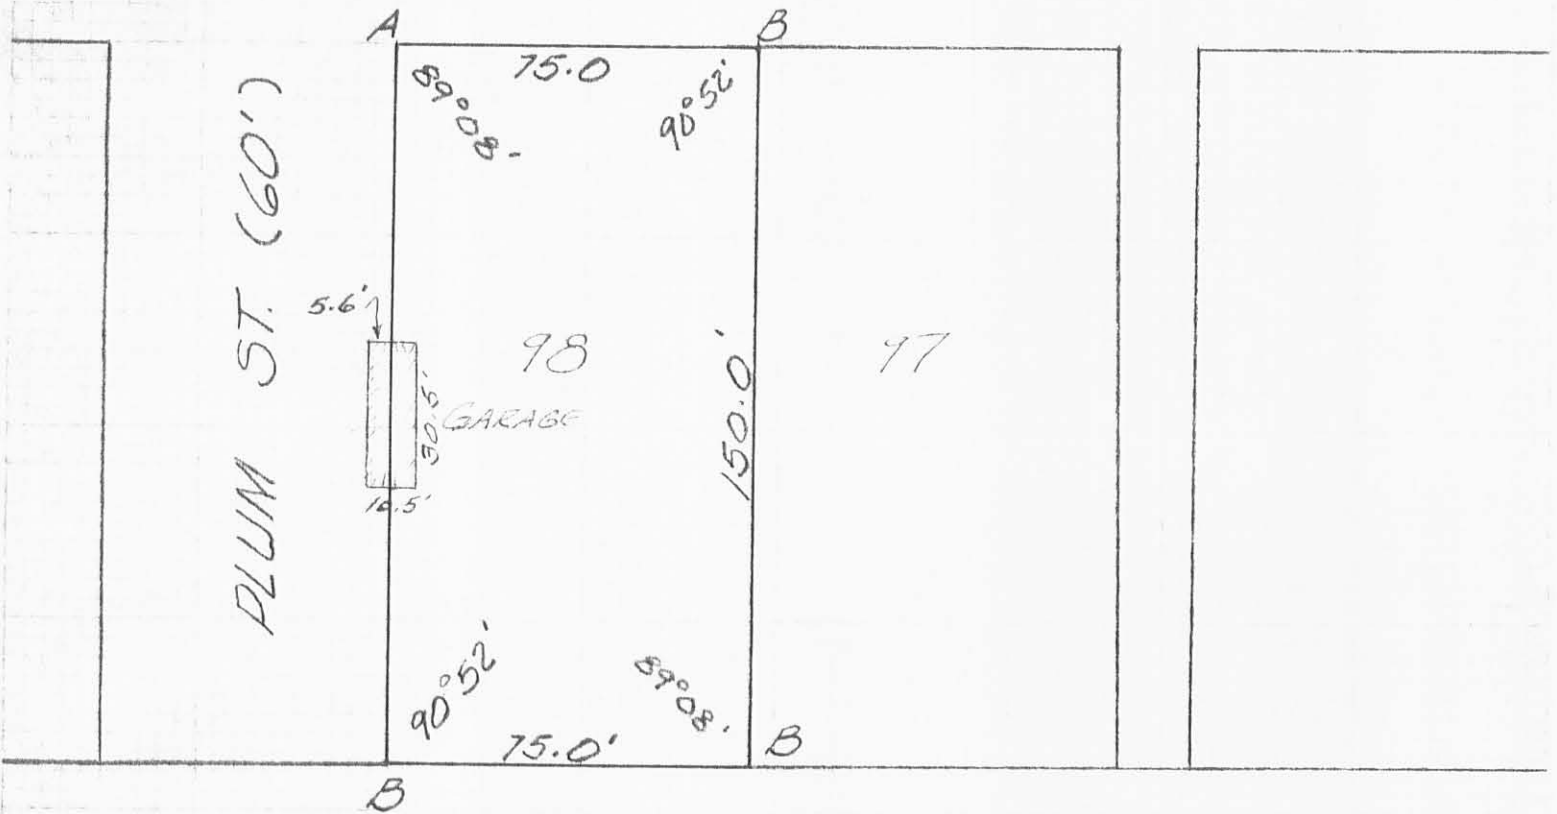

C.C.C. & ST. L. R.R.

A = 1/2" PIPE FD
B = 7/8" IRON BAR SET

SURVEY OF LOT 98
IN
WILLIAM RAMSEY ADDITION
BELLE CENTER, OHIO

SCALE 1" = 40'

REF: PLAT BOOK A VOL. 1 / PG 113

5416 1P

LESLIE H. GEESLIN
REG. SURVEYOR 5248

INDEXED ON MAP