


WITTENBERG SURVEY
 LOTS 268 & 269 - BELLE CENTER, OHIO
 1" = 50' • DENOTES IRONS

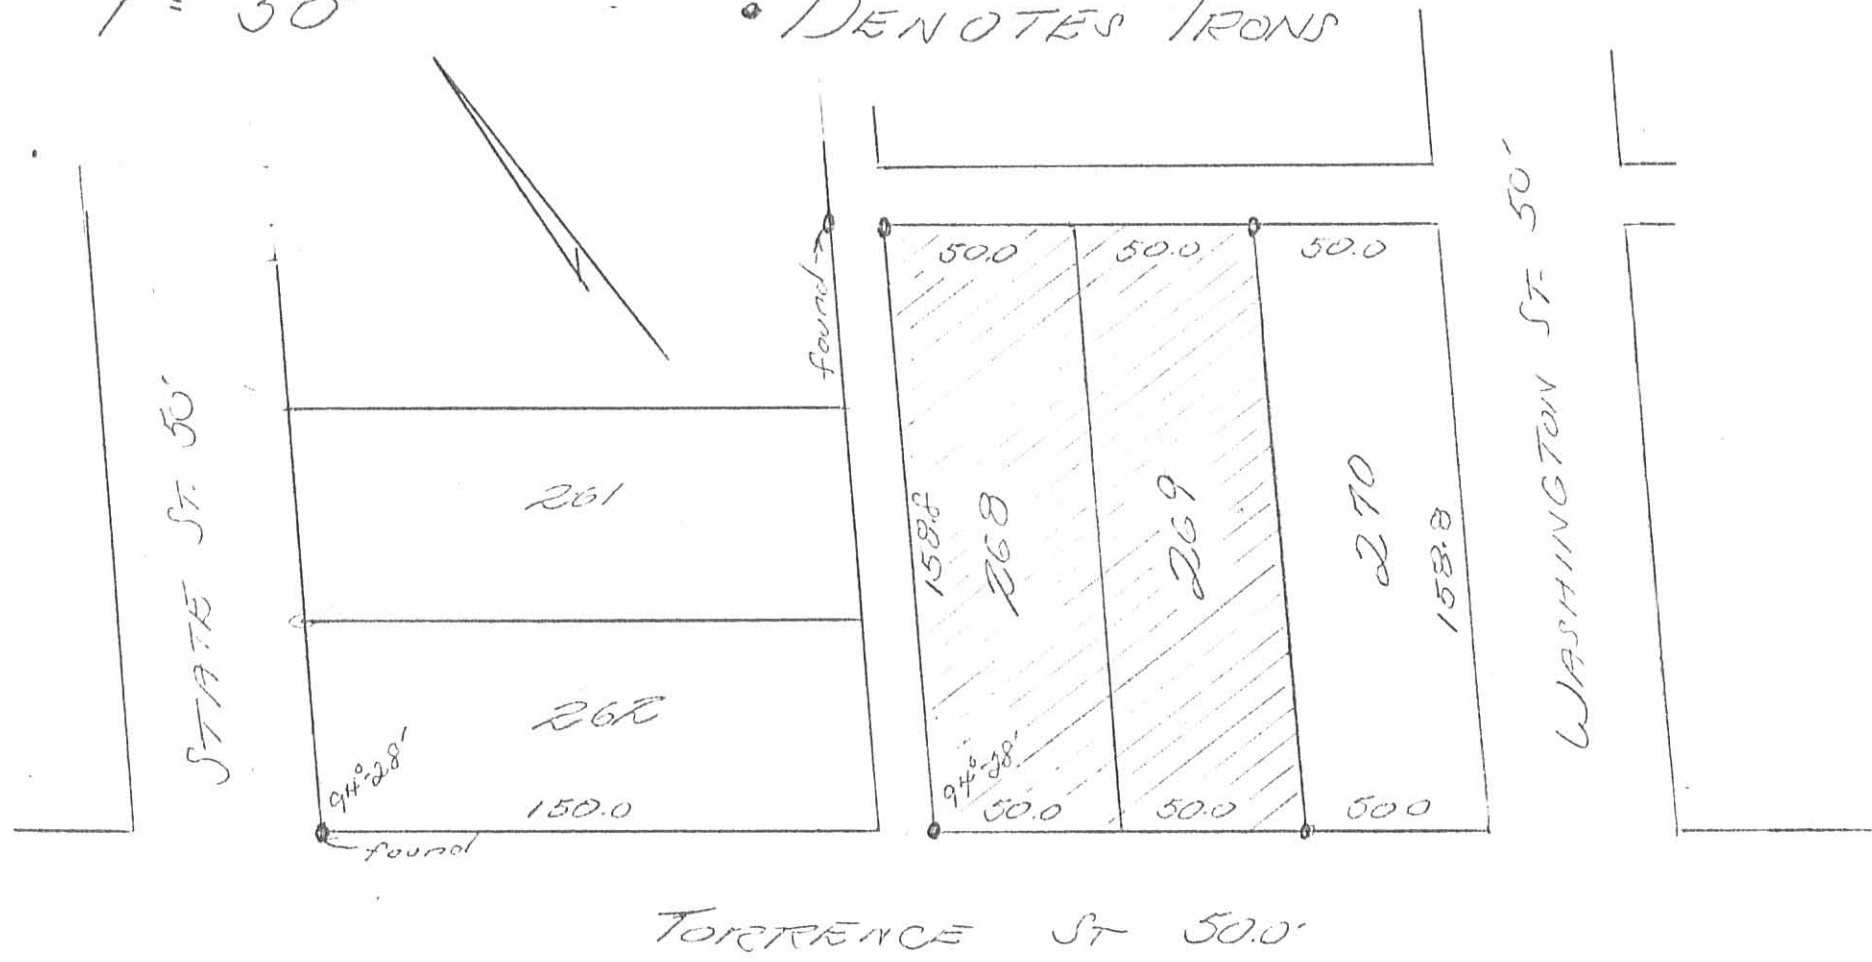

Owen K. Stirk
 Surveyor #271
 Nov. 2, 1976

5958 IP

INDEXED ON MAP