

566

INDEXED ON MAP

Magoon Surrey Lot # 283

W. Patterson Ave. Bellefontaine

- A = Monument with corner
- B = " " "
- C = " " "
- D = " " "
- E = " " "

AB Measured by Wright 527.3

AB Plat Book 526.5

Excess 0.8

DE Measured by Wright 526.0

DE Plat Book 526.5

Short 0.5

AD Measured by Wright 736.5

AD Plat Book 736.5

This makes the North and South measurements O.K.

The East and West measurements would be only about as short for the E of Patterson Ave. for the entire block

(see Next Page)


Date 17, 1925

cloudy

Wright

E. Smucker

5

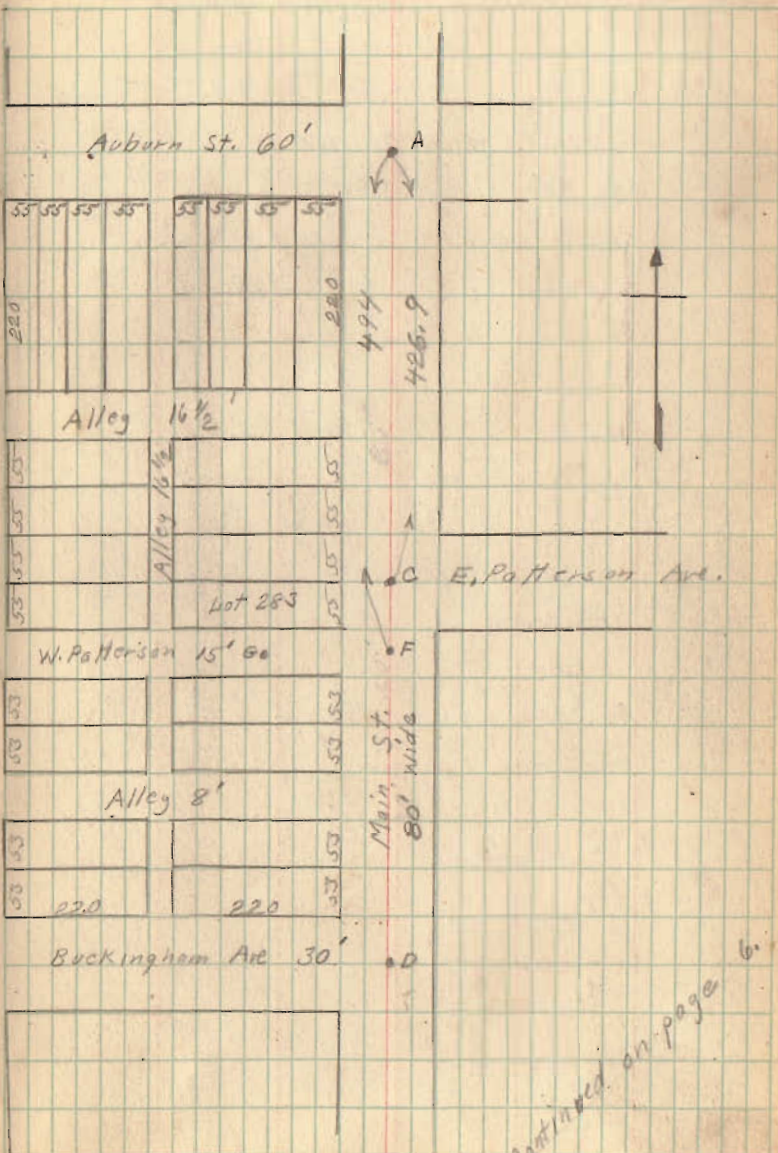

Continued on page 6.



