


October - 11-1926  
cloudy - Warm  
Wright  
Smucker  
Mr. Campbell

Campbell Survey  
lot 2465 Palmer Ave.

- A. Monument with cover
- B. " (See Book 385 Page 60)
- C. Staked Placed By Wright 52' from D.
- D. Old Hub Found
- E. " " "
- F. " " "
- G. " " "
- H. " " "
- I. " " "
- J. " " "
- K. " " "
- L. " " "
- M. " " "
- N. " " "

10' Alley Back of lots.  
Lots O.K. for width.  
Lots Short on depth. Distances  
DM<sup>9</sup> & LE were measured by  
Wright as shown.

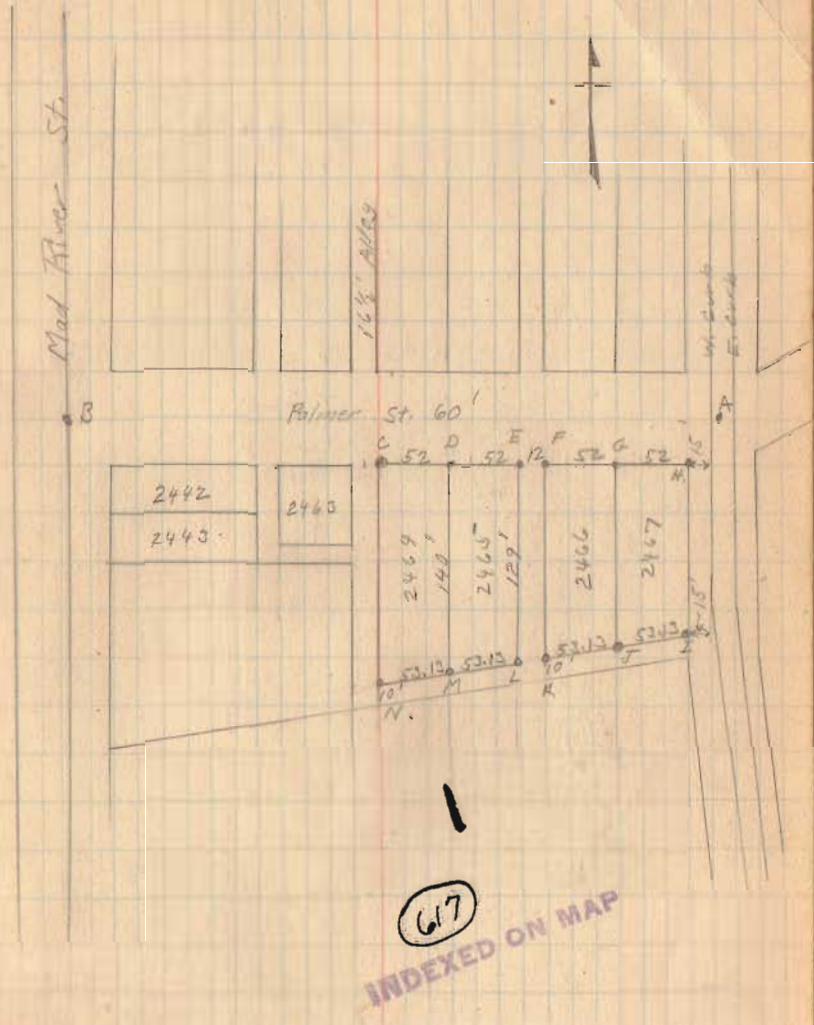

(See Next Page for witnesses)

Campbell Surrey

C	(	See	Page	34)
D	"	"	"	"
E	"	"	"	"
F	"	"	"	"
K	"	"	"	"
L	"	"	"	"
M	"	"	"	"
N	"	"	"	"

10-11-26

35

April-10-1936  
Cool-Cloudy  
F. Wright  
E. K. Cole

Lot 2464 Restafal.  
old stakes found  
O.K.

