

Survey for Dr Sniffin
Eastern Ave, by E. end
Brocery.


Start meas. at SE \angle of Skem
Meas. E. 119' set stake -
which stake is in line with
old fence at E side of
Sniffin lot. (Dad calls
for old garden fence.)

Meas. W. from line of
fence produced N. to
E. line Jamesfield Ave 143.7
It to NE \angle Skem. (old
fence line)

Meas E. from NE \angle Skem -
5 ft. set stake

Meas E. 40' more set
stake.

Meas E. 40' from SE \angle Skem
set stake.

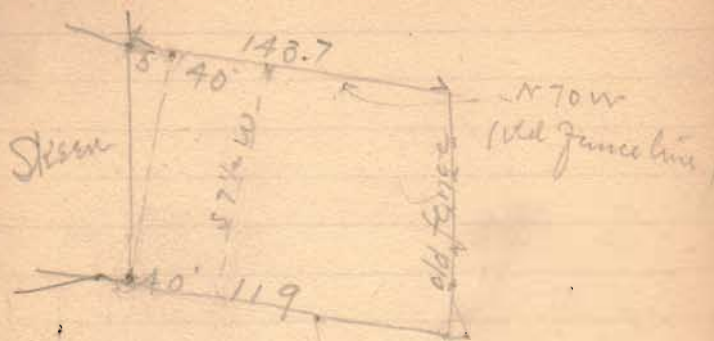

767
INDEXED ON MAP