


AB 15' FROM CENTER OF BROWN ST.
 BC 9'-3" FROM CENTER OF ALLEY
 LOT 50 & 110
 A 1" IRON
 B MARK ON CURB
 C 1" IRON
 D 3/4" IRON BOLT.
 FIELD NOTES IN LOGAN COUNTY SURVEYORS
 BOOK 193. SURVEYED JAN. 1929
 DEED RECORDED VOL. 134 PAGE 626

SCALE 1" = 100'

THE FOREGOING SURVEY IS HEREBY CERTIFIED TO
 THE NEW YORK TITLE AND MORTGAGE COMPANY FOR
 USE BY IT IN CONNECTION WITH ITS EXIMINATION
 AND INSURANCE OF TITLE UNDER ITS TILLE NUMBER-----
 DATED ----- SIGNED *F. F. Wright*
 CIVIL ENGINEER


925

MOORES & ROSS SURVEY
 BELLEFONTAINE OHIO

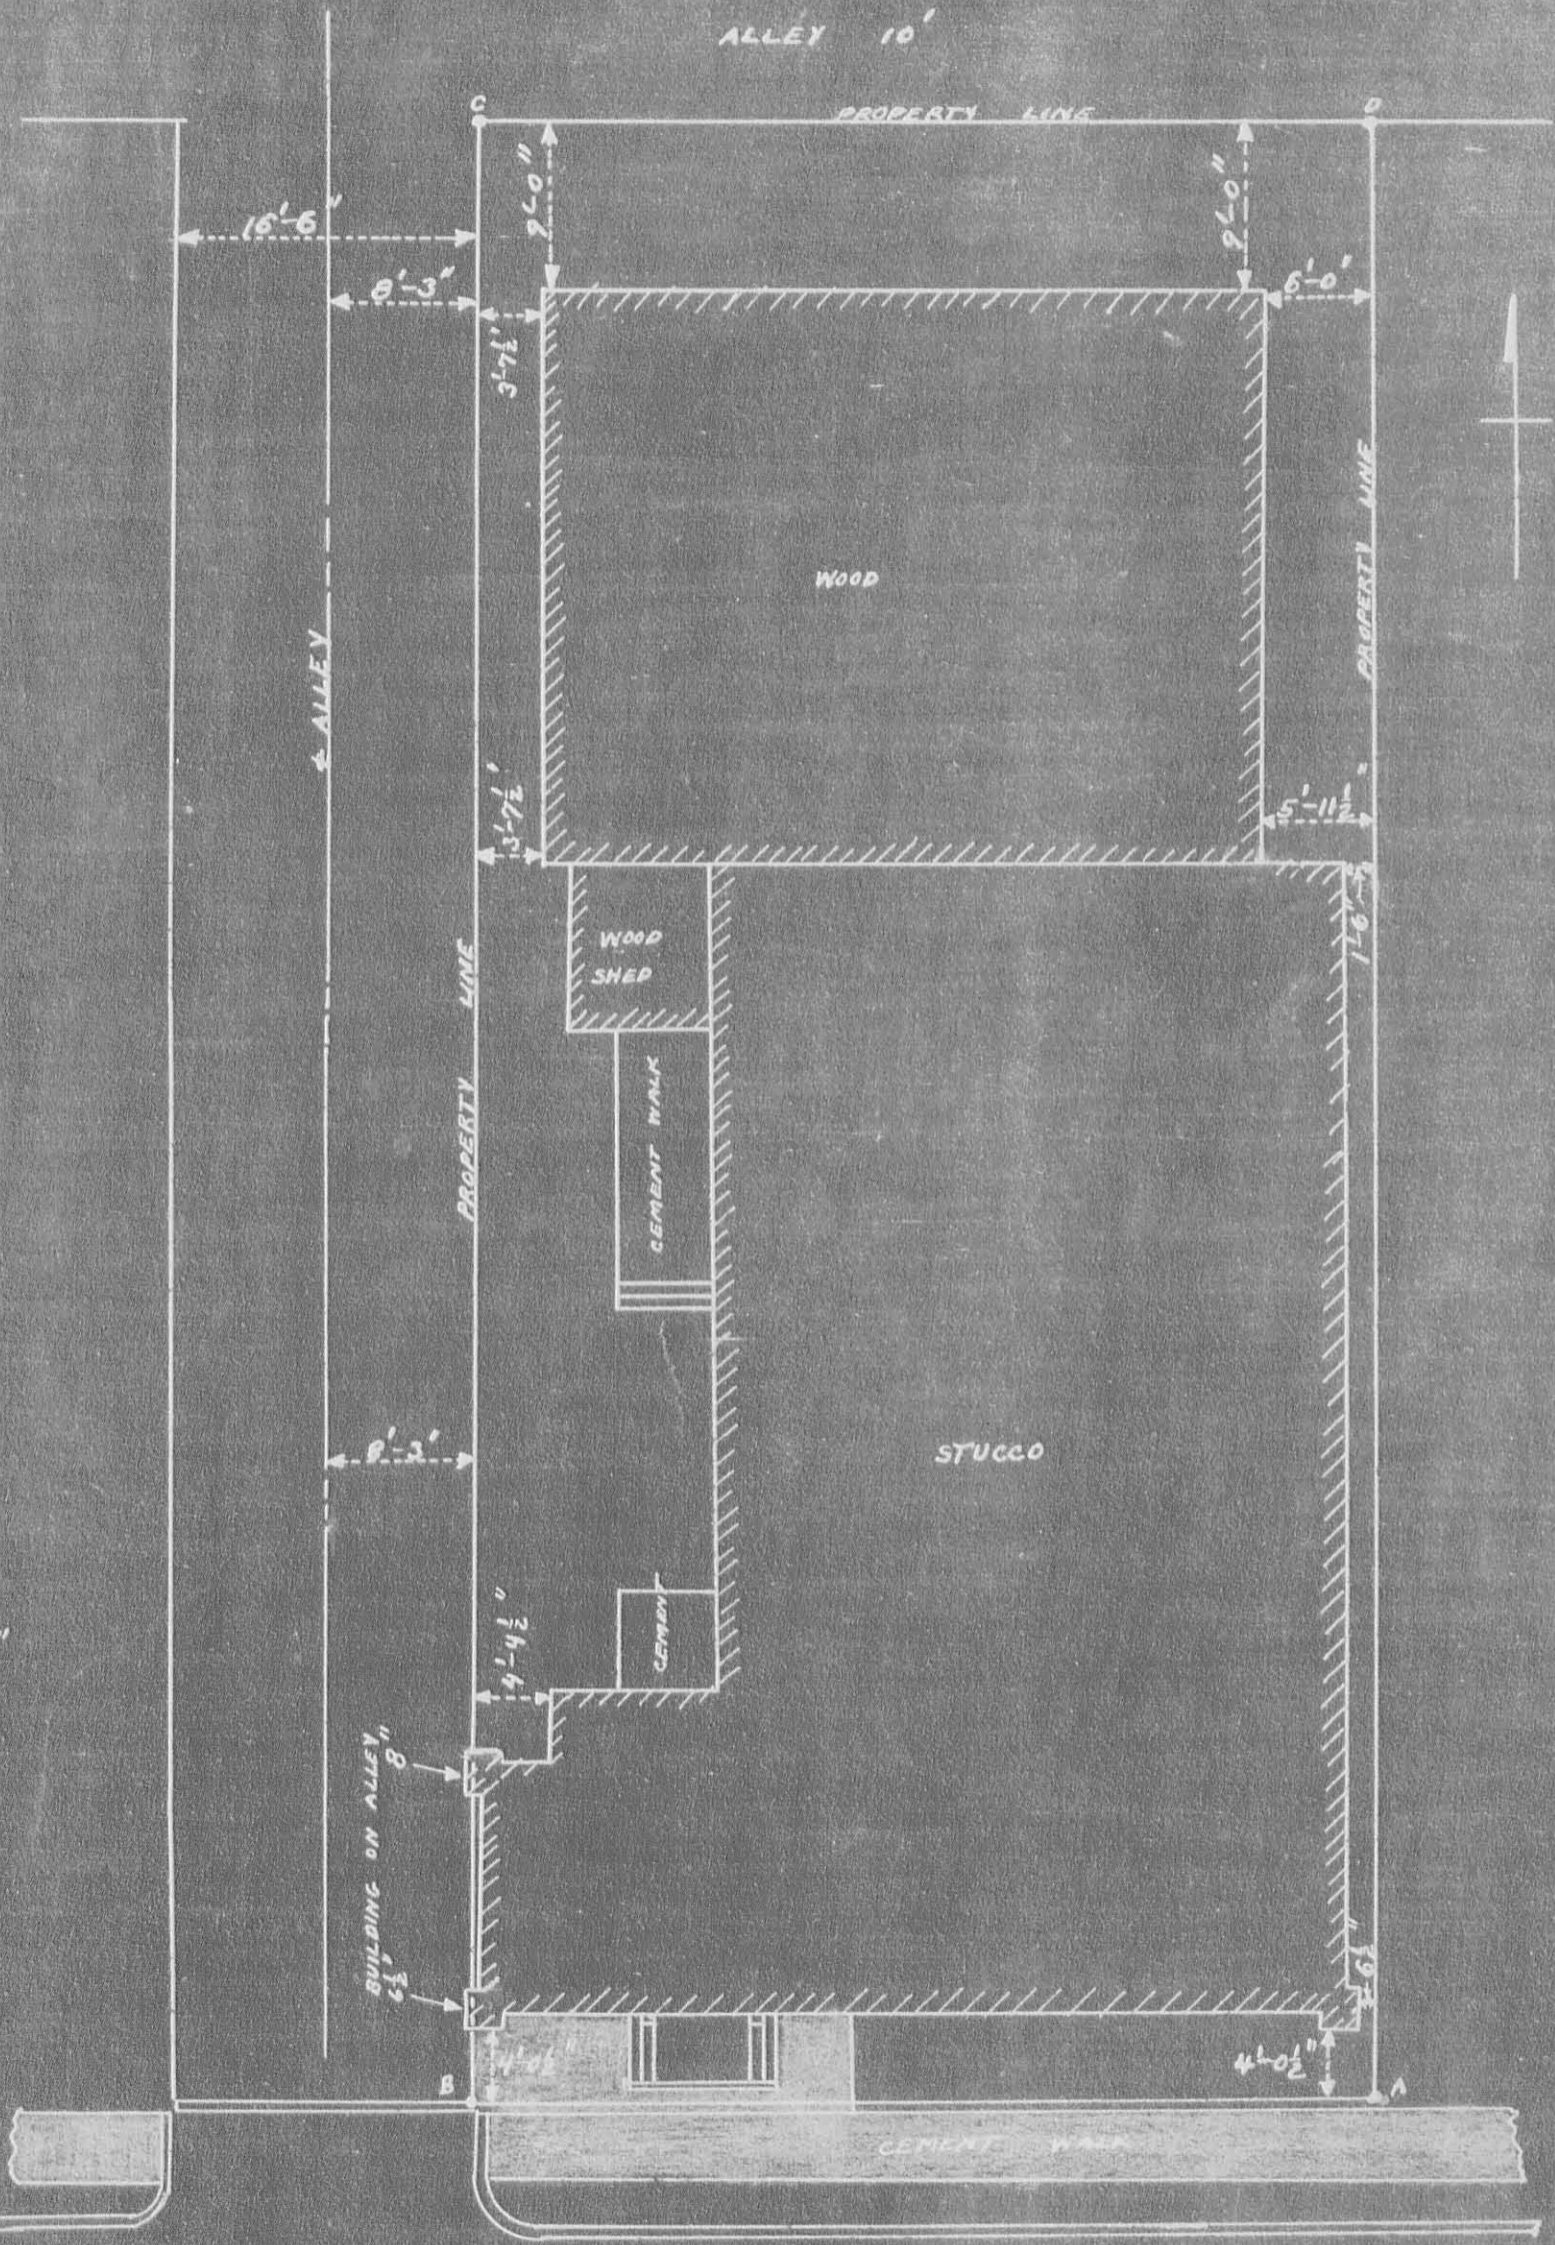

RECORDED
 925

STANTON'S 1ST ADDITION

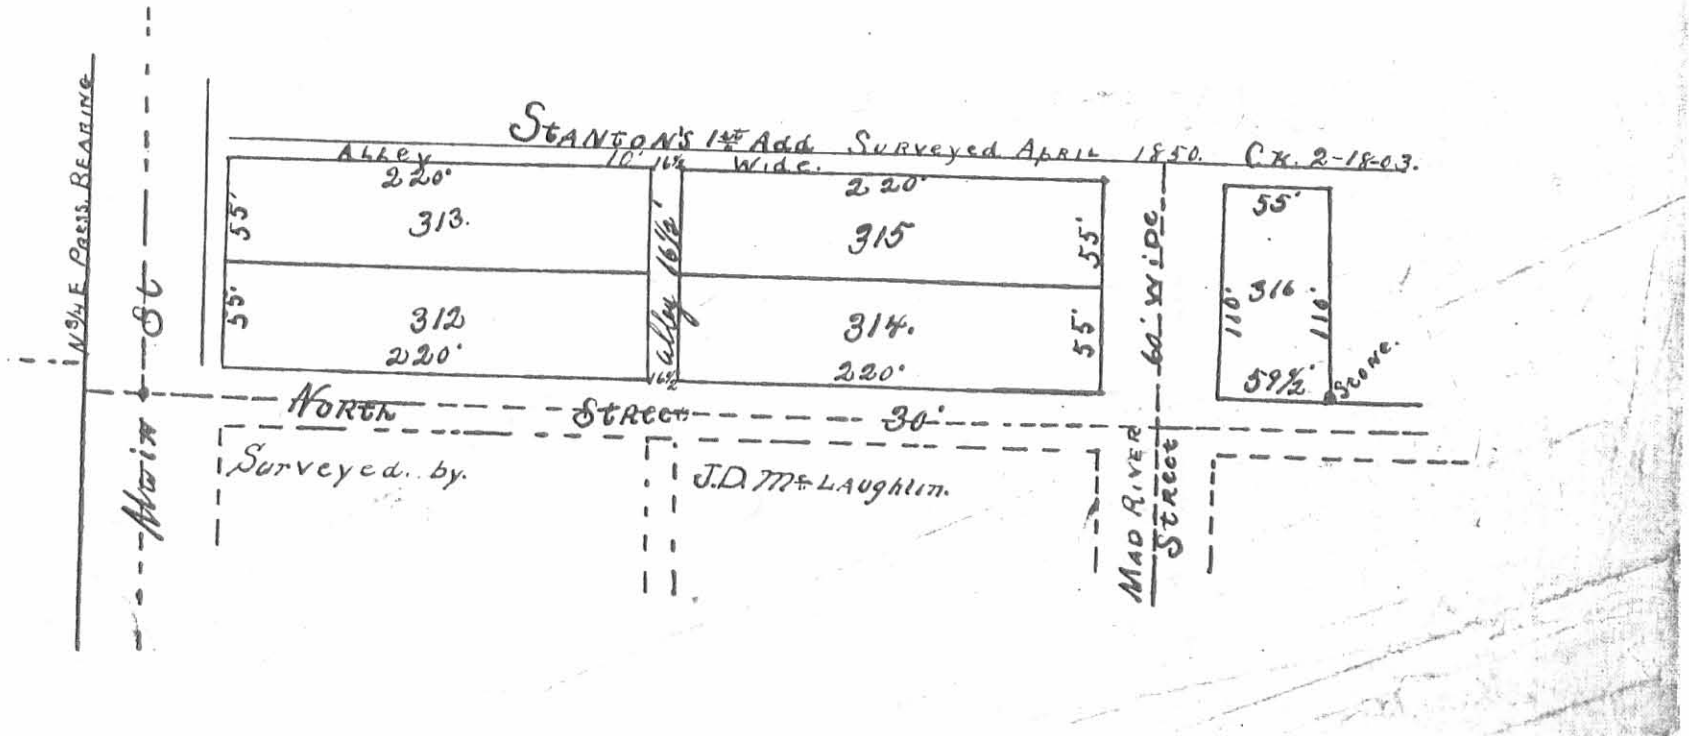

INDEXED ON MAP
925 2P