

Survey for Hamilton

427 1.70
132 .85



(1069)

INDEXED ON MAP

(See Page 55)


443 2.80 20.26 3
364
160
063
220
126
126
185

BELLEFONTAINE

W A Montgomery 12/29/23
Wm Smucker

1.38

2.50
1.12
1.38

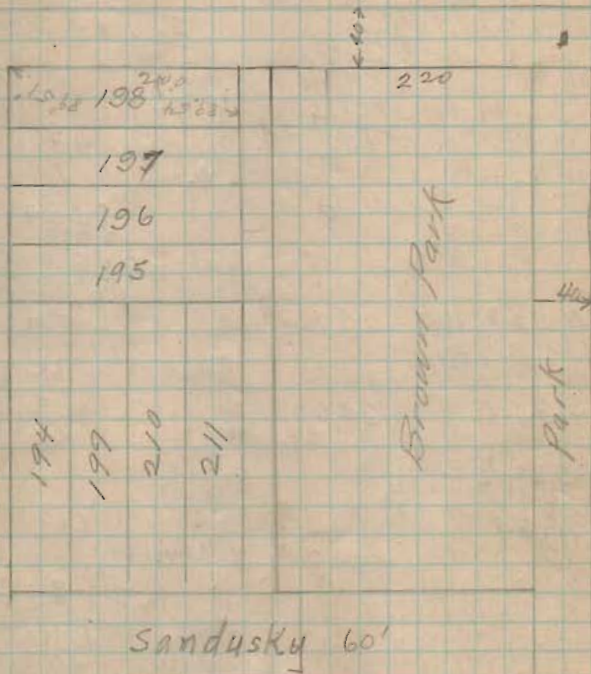

Brown: 504.80 506.5 - 1.7
Sandusky 498.70 501.5 - 2.8
for further notes see page 55