

Parcel of Alburgh Addition

Hub with tack at all
lot corners except where
Irons are shown

Lane 11 To Alburgh
Vol. 142 Page 304
calls for 180 X 338,
Note the 338' does not
hold out.


Plot. Drawer. J-42

See Drawer R

INDEXED ON MAP

1127

Concrete Bridge at
Blue Jacket
20' span.

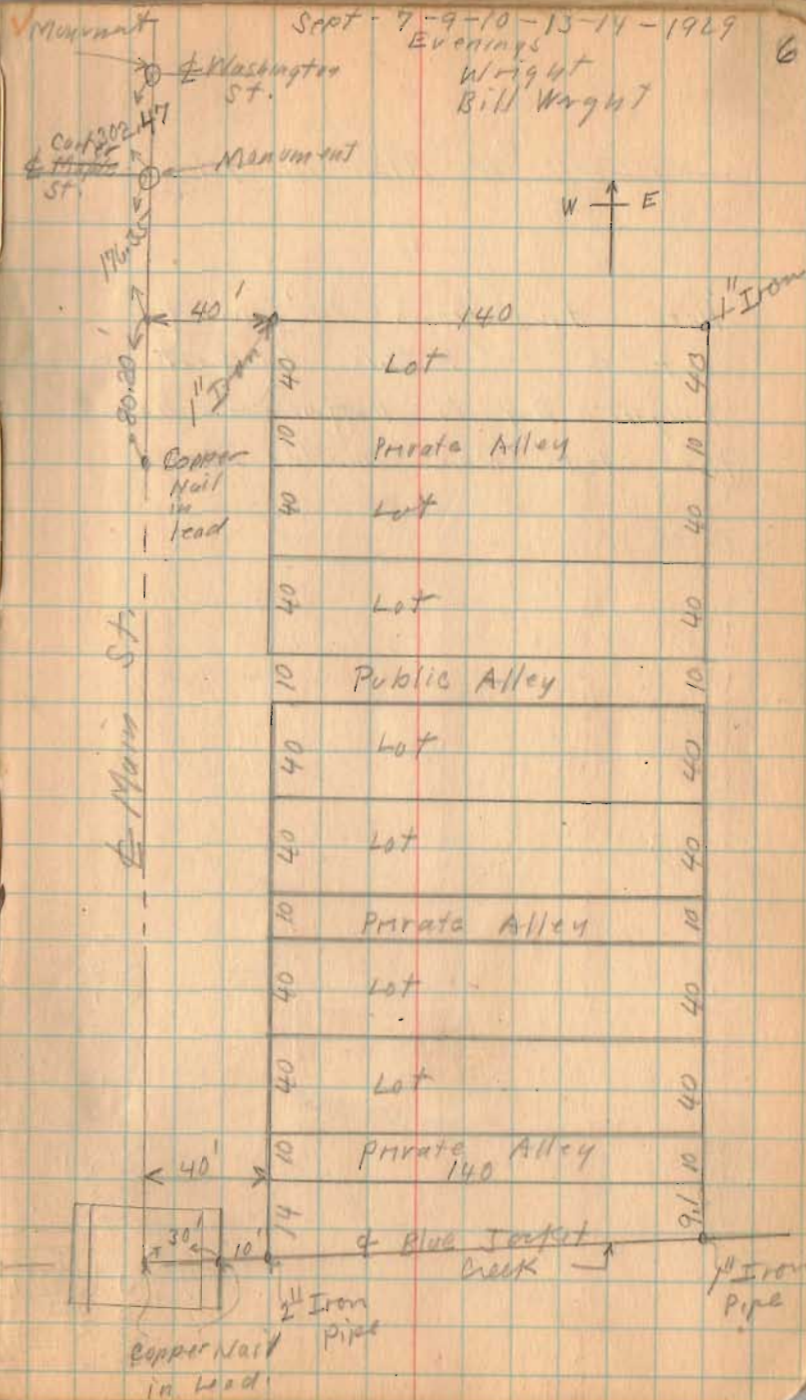


+

Perrell and Albaugh Addition.

Note two irons 10' N of Lot # . This 10 foot was bought by Mr. Huffmire before the lots were made.

INDEXED ON MAP

Made chisel line on top of curb at S. Line of Lot. This is 6" S. of Joint in curb.

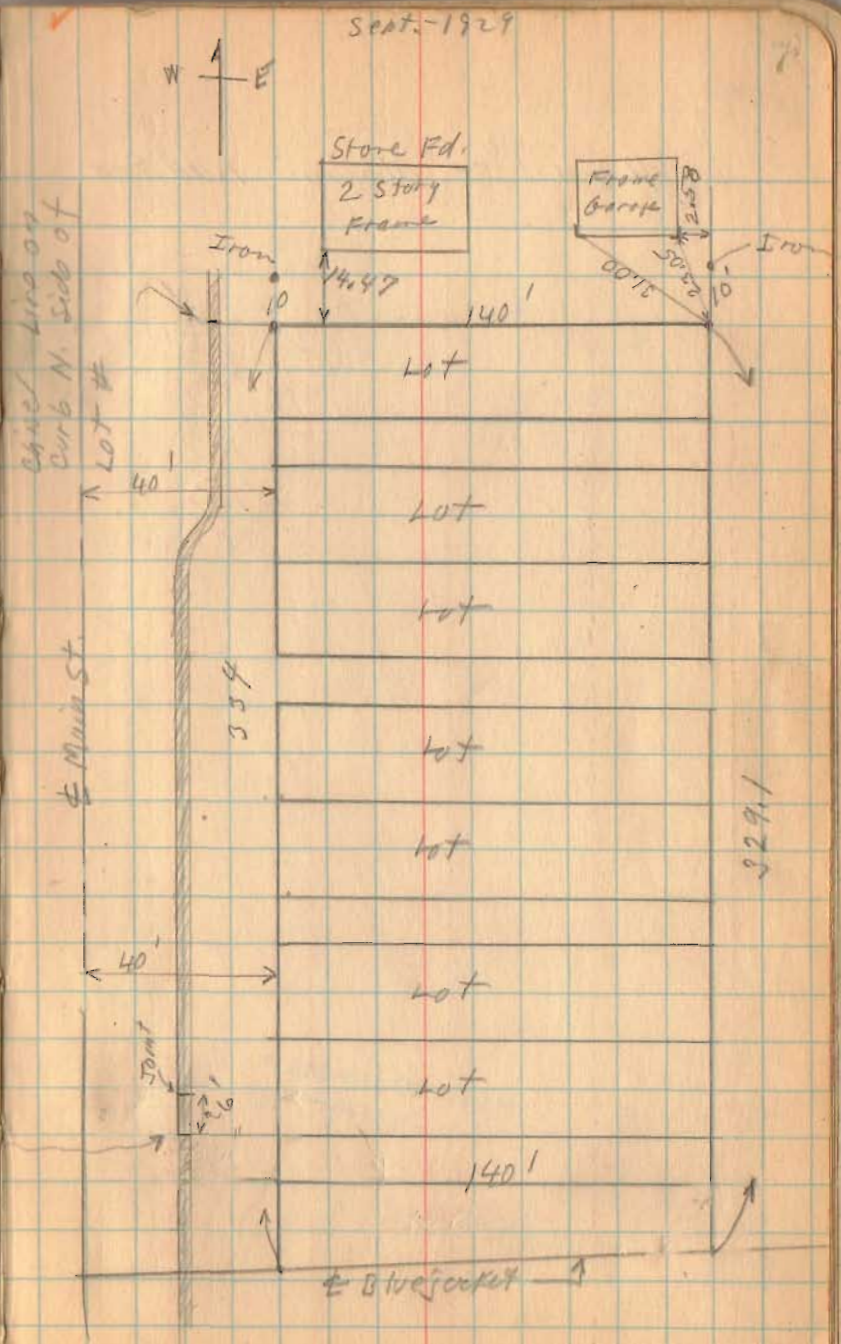

Sept. - 1929

Store Bldg
2 Story
Frame

Frame
Garage

Iron

Lot

Lot

140'

Blue Jacket

329.1

Parcel 94 Albany Addition

INDEXED ON MAP

Sept. 1929

