



Block Survey  
Lake Tap  
Clark's Addition

108 E R.R.  
511.9

INDEXED ON MAP  
1144

Plat of part of  
Clark's Addition

- Hubs found Oct. 6-1930
- ⊙ Irons found Oct. 6-1930

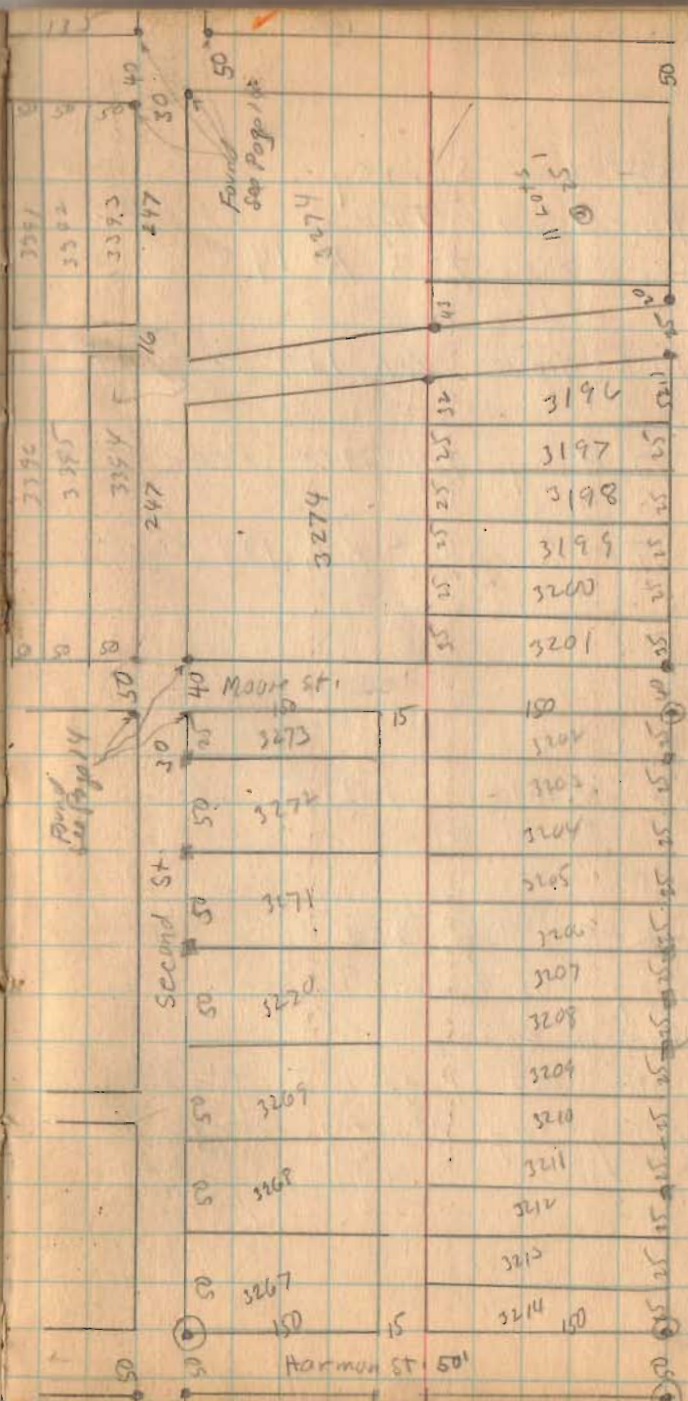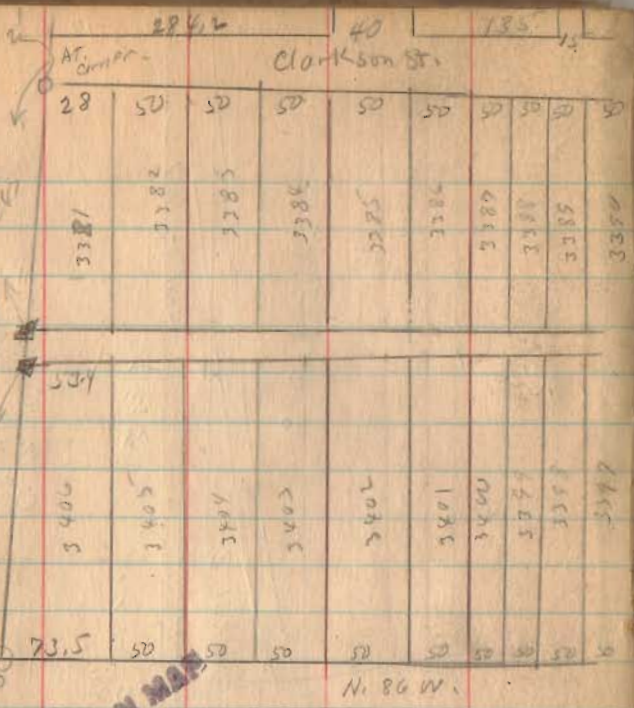

To Ball's Station  
N. 5-58 W.  
11.2.11.189  
To N. Liberty







INDEXED ON MAP  
 11/11/11

1.C.4.E.R.12

2842

N. 3-58 W

Harmon St. 50'

Second St

N. 80 W  
 Clark St 50'

3200	3265
3201	3266
3202	3267
3203	3268
3204	3269
3205	3270
3206	3271
3207	3272
3208	3273
3209	3274
3210	3275
3211	
3212	
3213	
3214	

3395	3396	3397	3398	3399	3400	3401	3402	3403	3404	3405	3406
3382	3383	3384	3385	3386	3387	3388	3389	3390	3391	3392	3393

Bluck Survey

The following described land being in Sec. 33, Town 4, Range 14, of M.R.S. Lake Township, Logan County, Ohio, and also being in an allotment known as Clarks Addition which is a recorded plat in Recorder's office of Logan County.

Beginning at an iron pin at the North side of Moore St. and the West side of Bellefontaine-West Liberty pike (also known as I.C.H. 189) thence North with the West side of said pike 200.0 ft. to the center of a lane, thence West with the center of said lane 374.5 ft. to a point which is 20.0 ft. West of the West side of Second Street, thence North parallel with Second Street and at a distance of 20.0 ft. West of the West side of said Second St., 371.8 ft. to a point on the South side of Clarkson Street, thence with the South side of Clarkson Street, West 608.0 ft. to the East Right-of-way line of the C. & L.E. R.R., thence with the said Right-of-way line in a Southernly direction 511.9 ft. to the North side of Moore Street, thence with the North side of Moore St. East 673.5 ft. to the West side of Second Street, thence East 30.0 ft. to an iron pin, said pin being on the North side of Moore Street and the East side of Second Street, thence with the North side of Moore St. East 315.0 ft. to the place of beginning, said tract containing 8.84 acres, more or less, being the same survey as shown in Logan County Surveyor's Book 512, Page 27.

Survey  
INDEXED ON MAP  
1144  
2D



