


July - 8 - 1934
 Clear - 5 A.M.
 F. Wright
 H. Wright

48

Lot. 145 Bellefontaine
 Chillicothe Ave.
 Plat Book all Lots 220'x55'

- A - Copper Point in Brck.
- B - Small Iron Placed.
- C - Mont. with corr.
- D - Nail on line C.E.
- E - Iron (Level with Tar.)
- F - Point on ManHole
- G - Mt with corr.
- H. Cross in Brck.
- I small Iron Placed.

	Plot	Wright	
AC	526.50	525.2	+ 1.30
AB	268.25	267.6	- 0.65
BC	258.25	257.6	- 0.65
CE	516.50	515.9	- 0.60
CD	258.25	257.95	- 0.30
DE	258.25	257.95	- 0.30
EG	526.50	523.60	- 2.90
EF	258.25	256.8	- 1.45
FG	268.25	266.8	- 1.45
GH	516.50	516.1	- 0.40
GH	258.25	258.05	- 0.20
HH	258.25	258.05	- 0.20

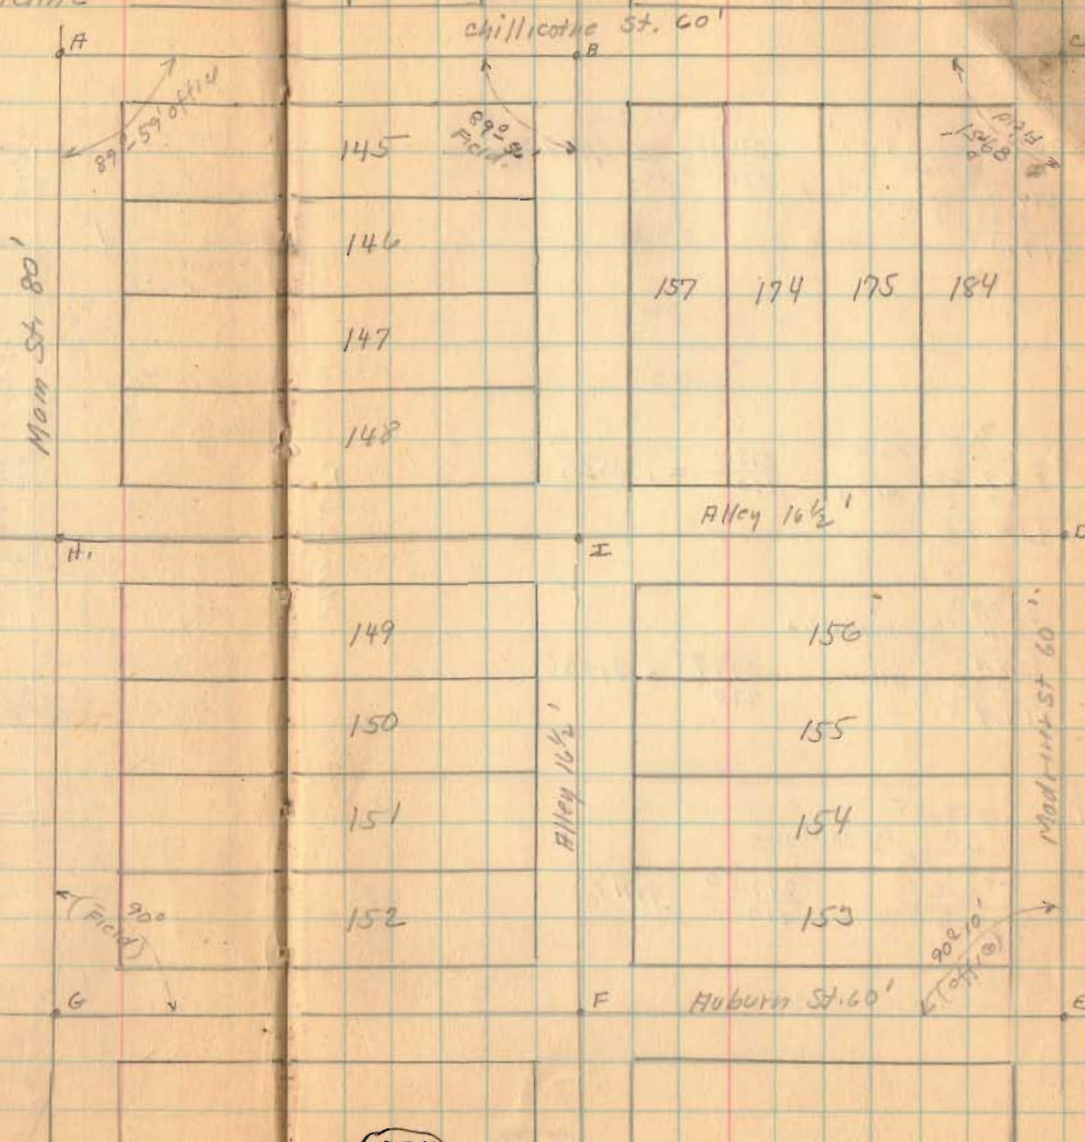

(1724)

INDEXED ON MAP

(over)

Lot, 145

$$\begin{array}{r}
 HB \quad 267.6 \\
 \quad 40 \quad \frac{1}{2} \text{ Main} \\
 \hline
 227.6 \\
 \quad 8.25 \quad \frac{1}{2} \text{ Alley} \\
 \hline
 219.35
 \end{array}$$

$$\frac{219.35}{220.00} = .99704\%$$

$$\begin{array}{r}
 HI = \quad 267.2 \\
 \quad 40 \quad \frac{1}{2} \text{ Main} \\
 \hline
 227.20 \\
 \quad 8.25 \quad \frac{1}{2} \text{ Alley} \\
 \hline
 218.95
 \end{array}$$

$$\frac{218.95}{220} = .9952\%$$

$$\begin{array}{r}
 BI = \quad 258.00 \\
 \quad 30 \quad \frac{1}{2} \text{ Chillatree} \\
 \hline
 228.00 \\
 \quad 8.25 \quad \frac{1}{2} \text{ Alley} \\
 \hline
 219.75
 \end{array}$$

$$\frac{219.75}{220} = .9993\%$$

$$\begin{array}{r}
 HA = \quad 258.05 \\
 \quad 30 \quad \frac{1}{2} \text{ Chillatree} \\
 \hline
 228.05 \\
 \quad 8.25 \\
 \hline
 219.80
 \end{array}$$

$$\frac{219.80}{220} = .9991\%$$




7-8-30

49

Chillatree
267.6

B

F

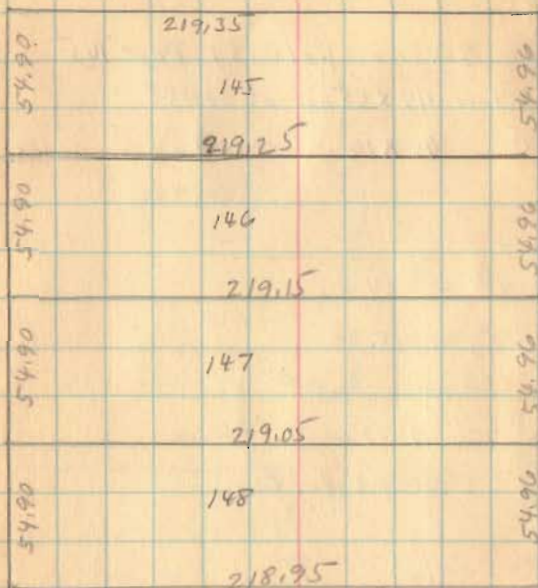

Main St.

258.05

207.2

Alley

I

I

Distances shown after Adjustments
have been made

Lot 145

Gray To Austin Val. 151 Pay 145

Mrs Austin 45 X 55 out of 145

" " 45 X 16 " " 146

$$55 \times 99.7\% = 54.96$$

$$16' \times 99.93\% = 15.99$$

Miller To Austin


$8\frac{1}{2}$ of $8\frac{1}{2}$ of Lot 146

(1724)



INDEXED ON MAP

7-8-36



50

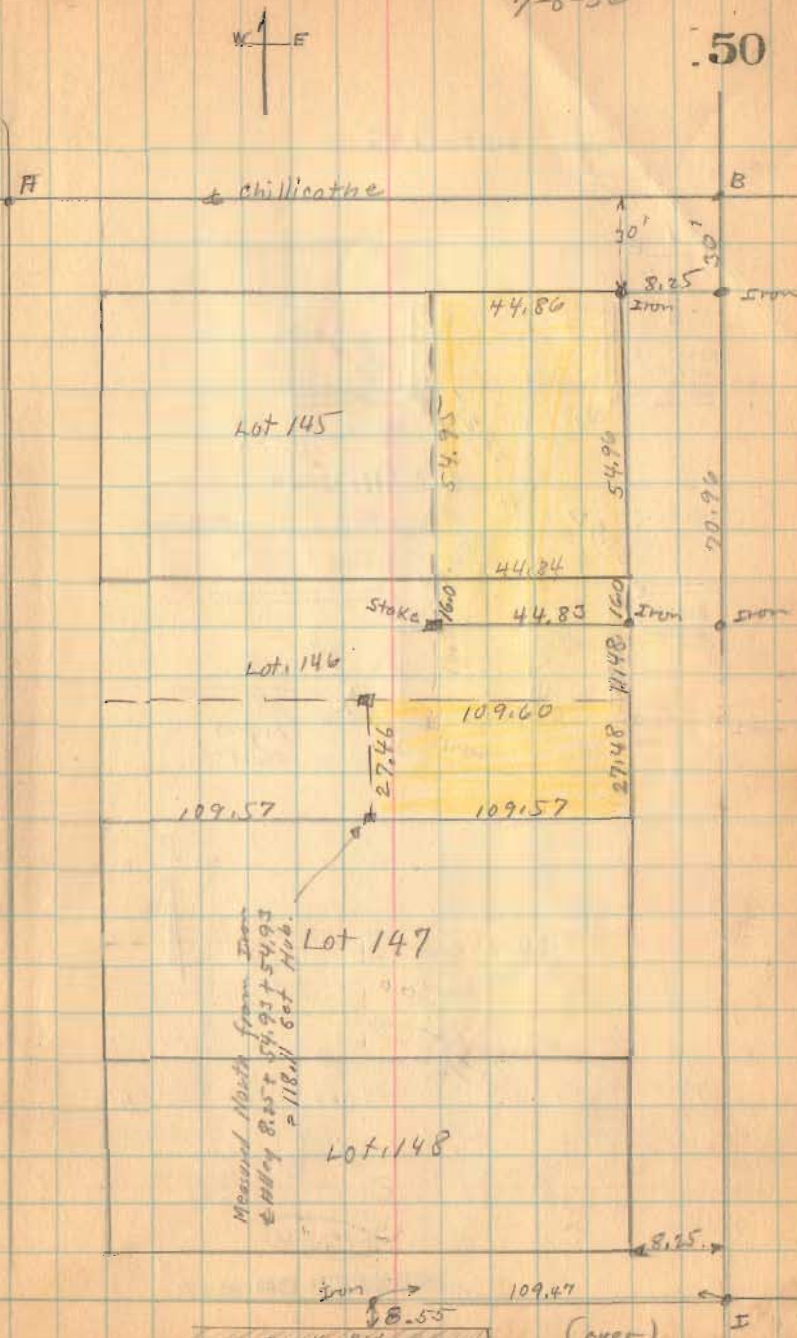


Lot 145

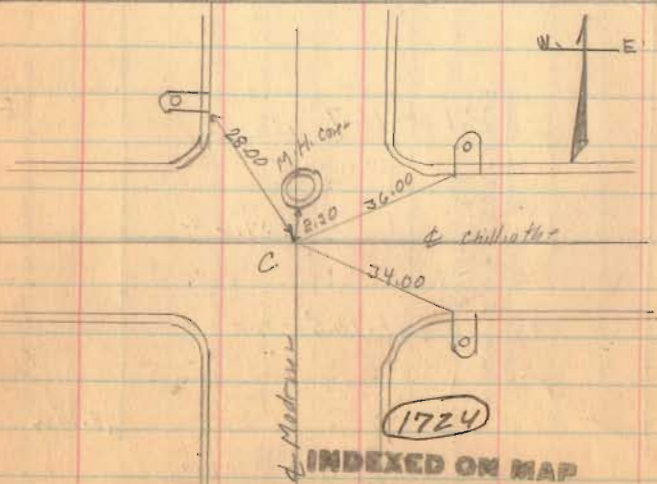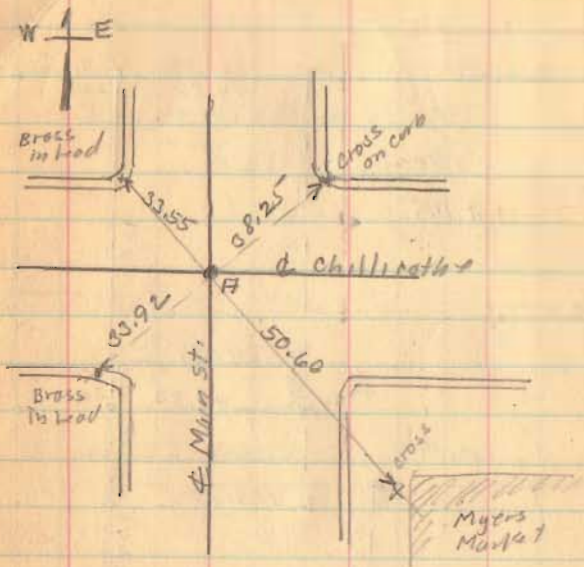

July - 10 - 36

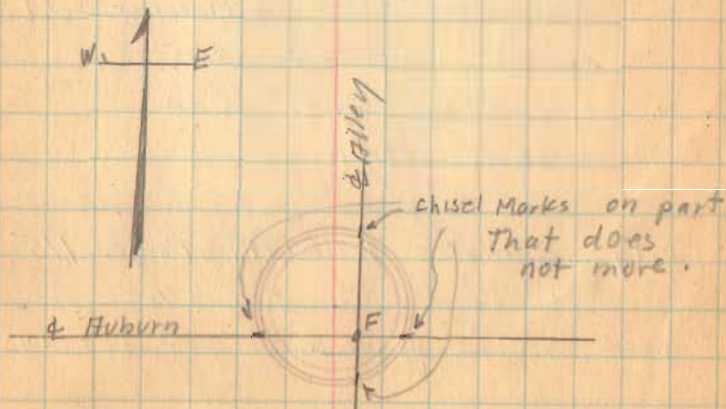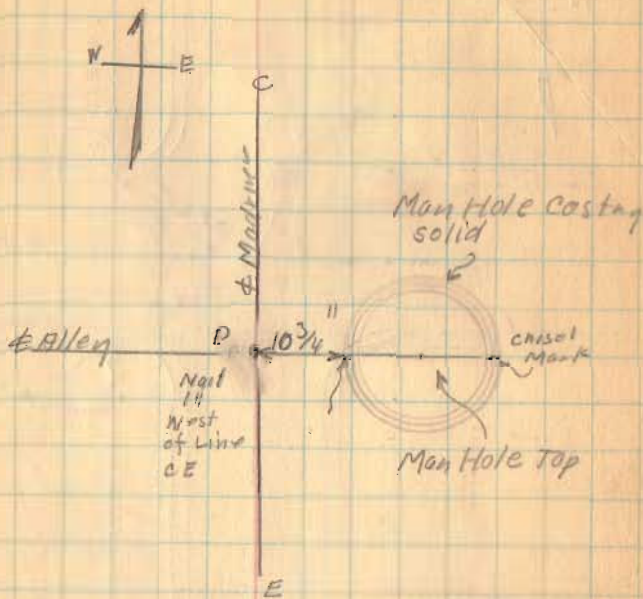

(over)

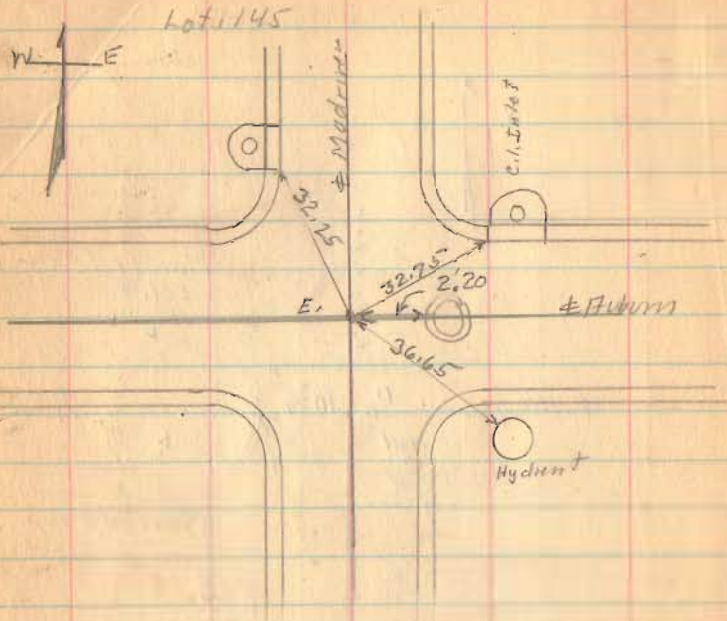



C - Mon. with curb & Madison and & Chillum
 (City Records) Hyd. S.E. 28.85
 W. end. Iron Inlet N.E. 36.00 (see Page 51)
 Maple N.W. 28.00

City Records Book 181 Page 115

Book 502 Page 140

Book C Page 256

7-10-36

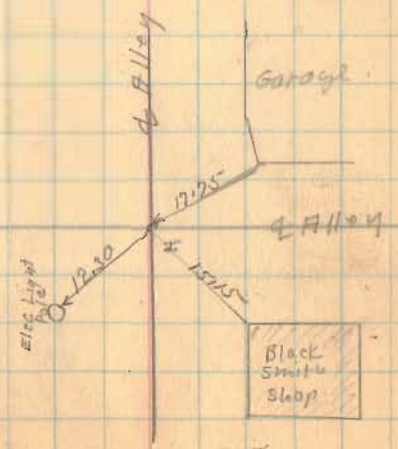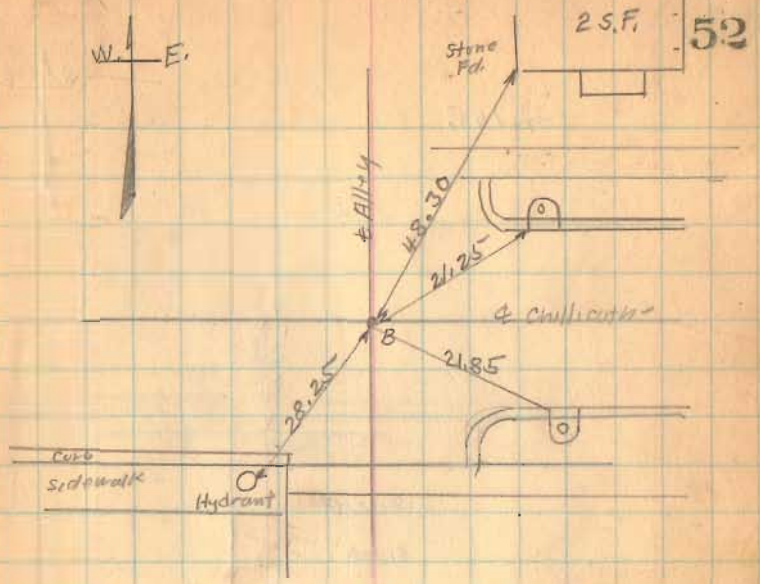


1724
 INDEXED ON MAP

(over)

7-10-36

53

Lot 145

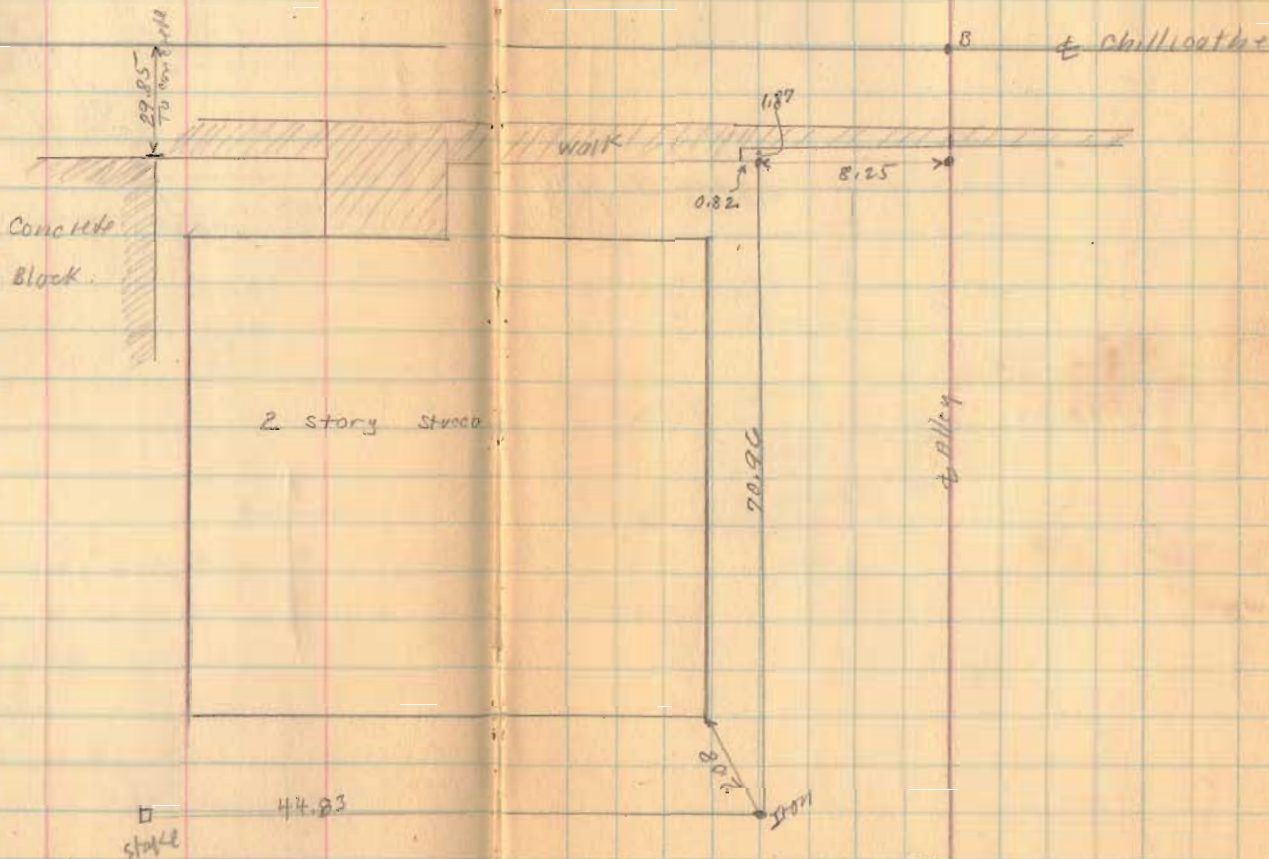

(1724)


INDEXED ON MAP

(over)

7-10-36

54

Lot 145

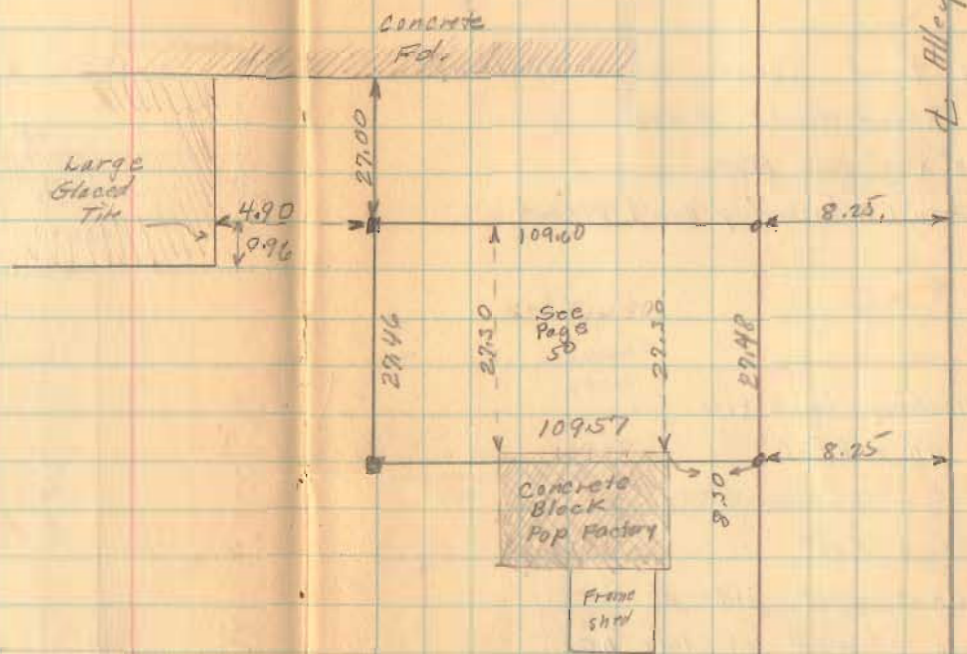

1724

INDEXED ON MAP