

Oct. 3-1936
 F. Wright
 W. Wright
 G. Posey


stang.
 Lot 2478 and 2479
 Rush Ave. Bellefontaine
 V.M.S. 5245

Lot Numbers and sides as
 shown in Logan County
 Recorder's office Book Page

A Found old Iron
 C " " "
 G " " "
 Dist C To G O.K.

Sta. 12+36
 R/W Posts
 plan L-5
 Page 3

R/W Posts
 Sta. 5+00
 plan L-5
 Page 3

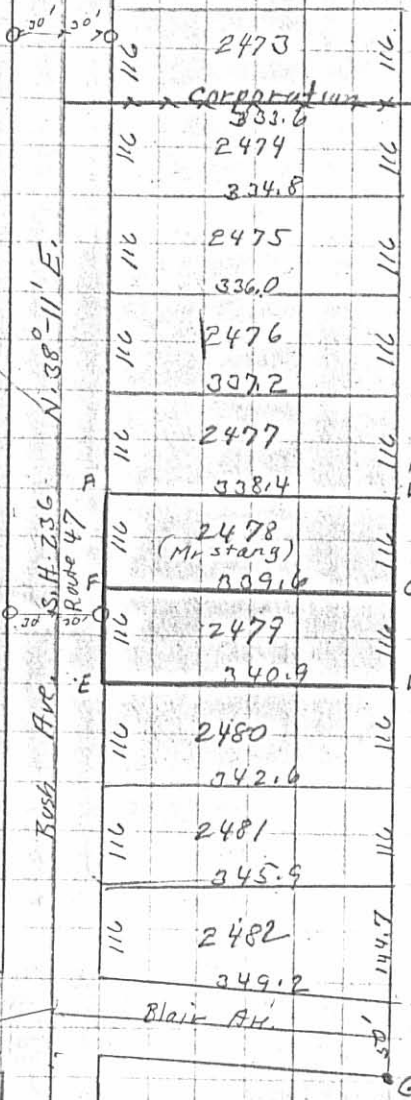

INDEXED ON MAP
 1750

1750 10

INDEXED ON MAP

(over)