


Street Centers Bellefontaine Ohio

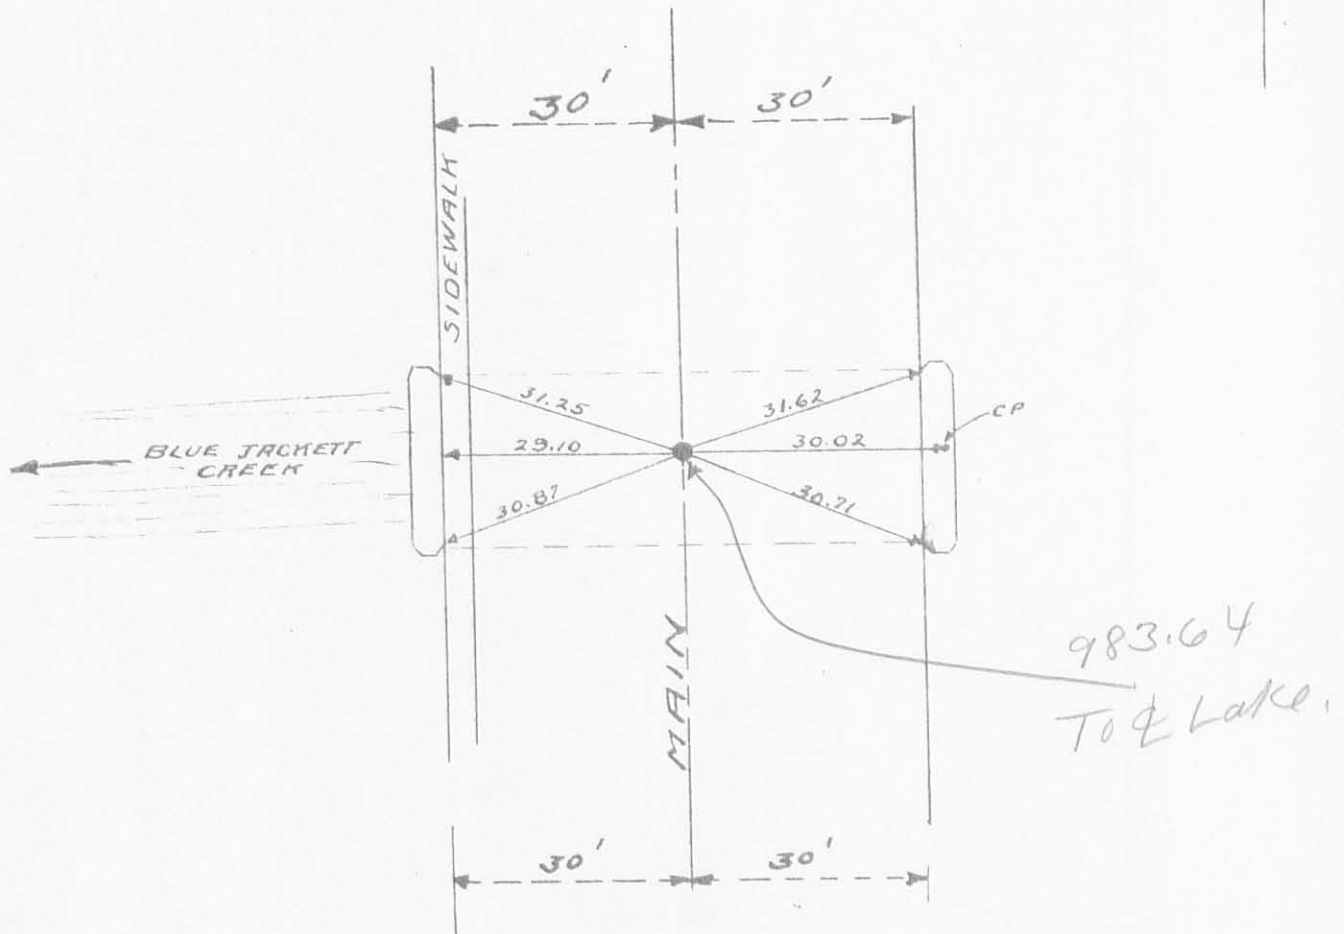

Date Witnessed. *May 22 - 1940.*

Material... *Copper in Lead*

Scale..... *None*

Monument Cover... *None*

Book..... Page.....

.....

..... **MAIN**

At

.. **BLUE JACKETT BRIDGE** ..