


Not To scale
808.50'

PLAT OF PRESENT RESEVOIR LOT

Scale 1"=100' March 14 1916
Office of City Engineer
Bellefontaine Ohio

Not To scale
1283.70

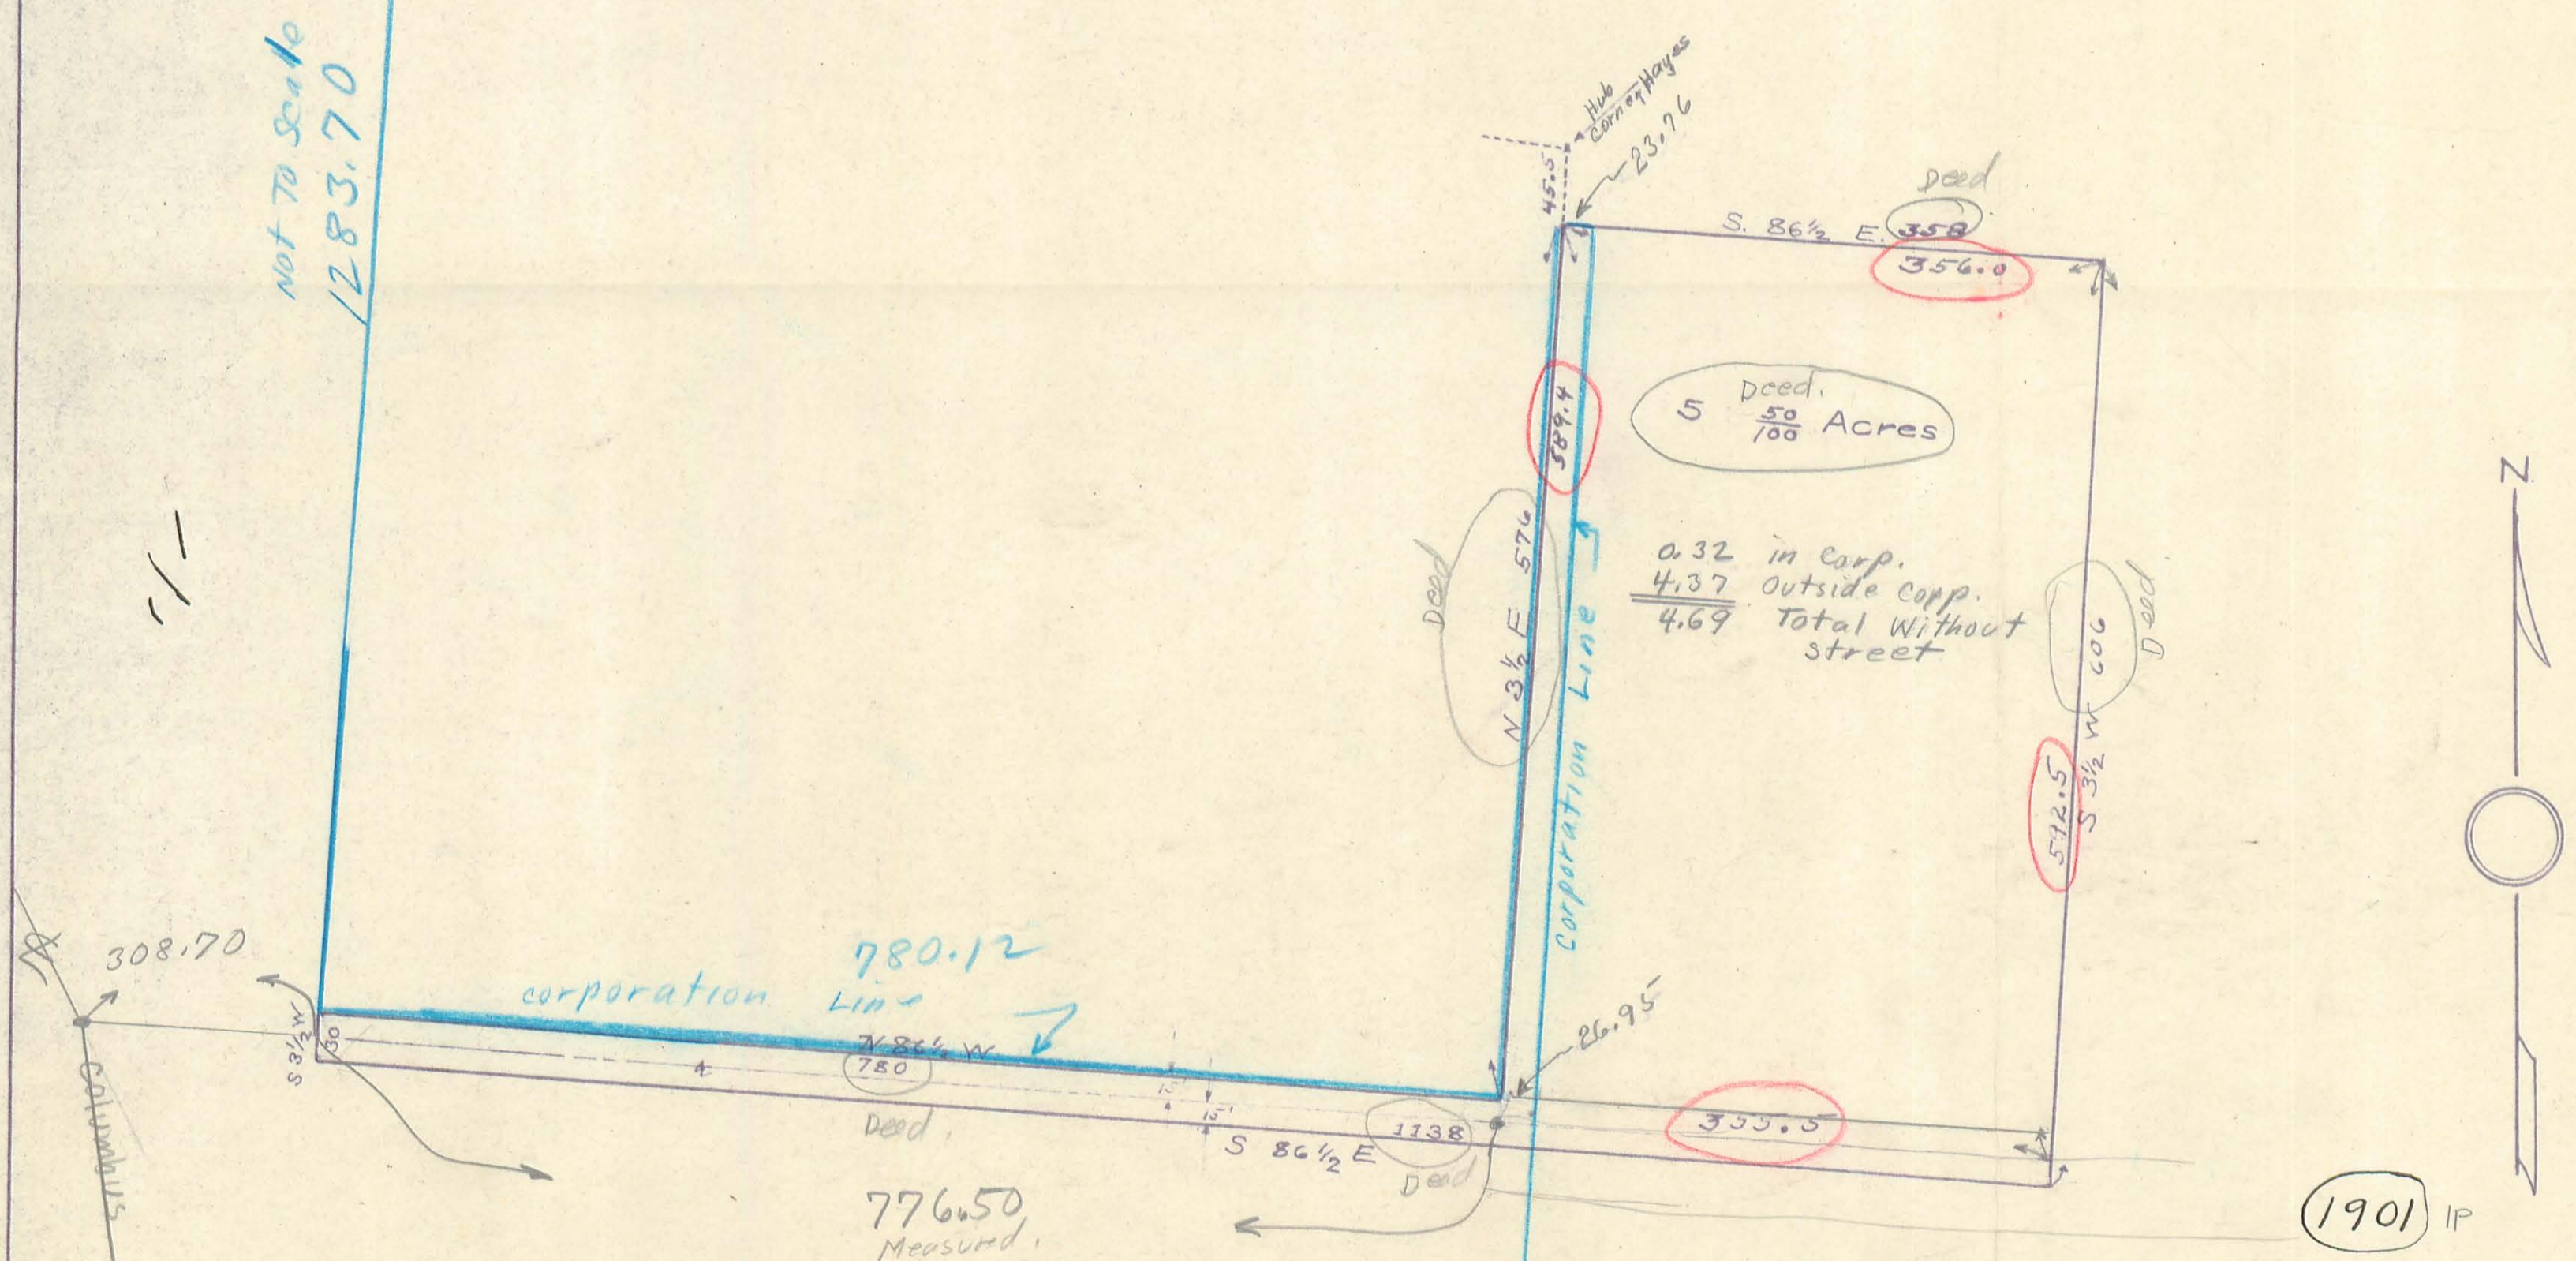

Survey 4399 & 4478
Logan County Deed Record Vol.66 Page 16

Measured Jan. 24, 1942
C.R. Fulton