


OFFICE OF THE CITY ENGINEER
BELLEFONTAINE, OHIO

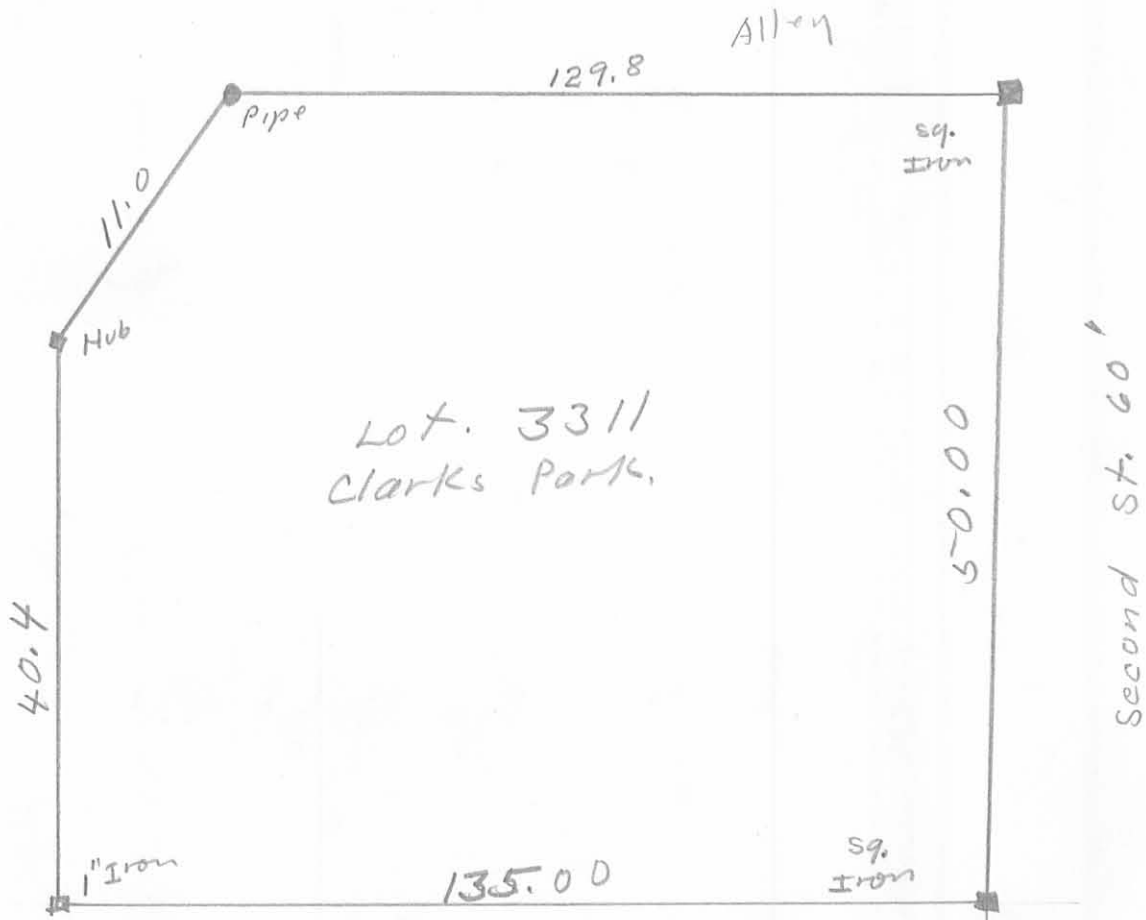

Lot. 3311
Clarks Park.

Hervey Survey
8-22-43
F. F. Wright.

(Not To scale)

INDEXED ON MAP



1921 IP