


Survey for Shirley Gill and  
 Earl Jamison  
 Survey No. 3137 Jefferson  
 Twp. Zanesfield, O.

5 June 1946  
 C.A. Inskip 25  
 J.H. Inskip  
 C. Miller  
 J.G. Wheeler

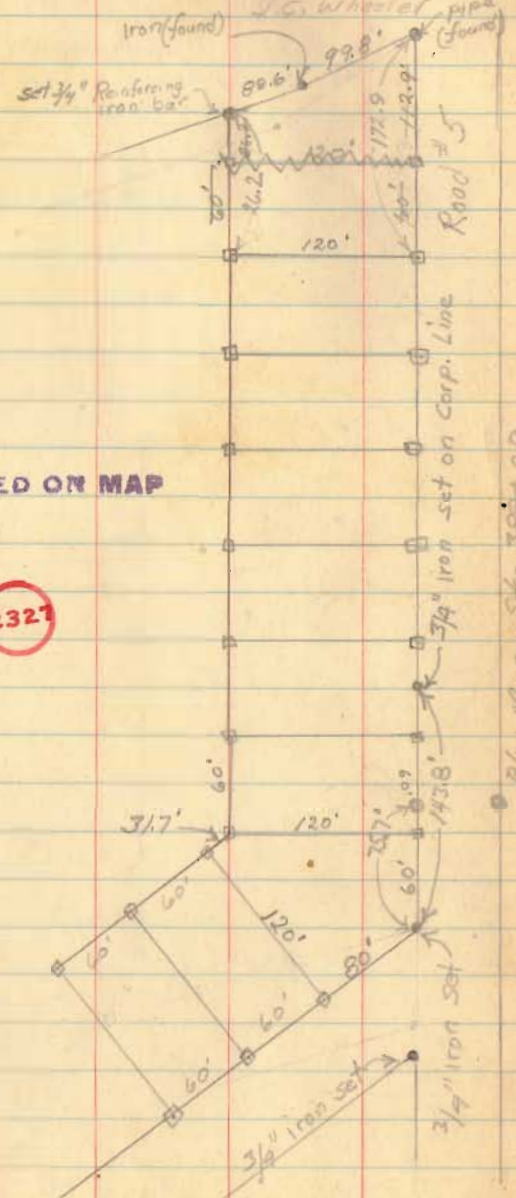

INDEXED ON MAP

2327

R/W Mon Sta 3554.00