
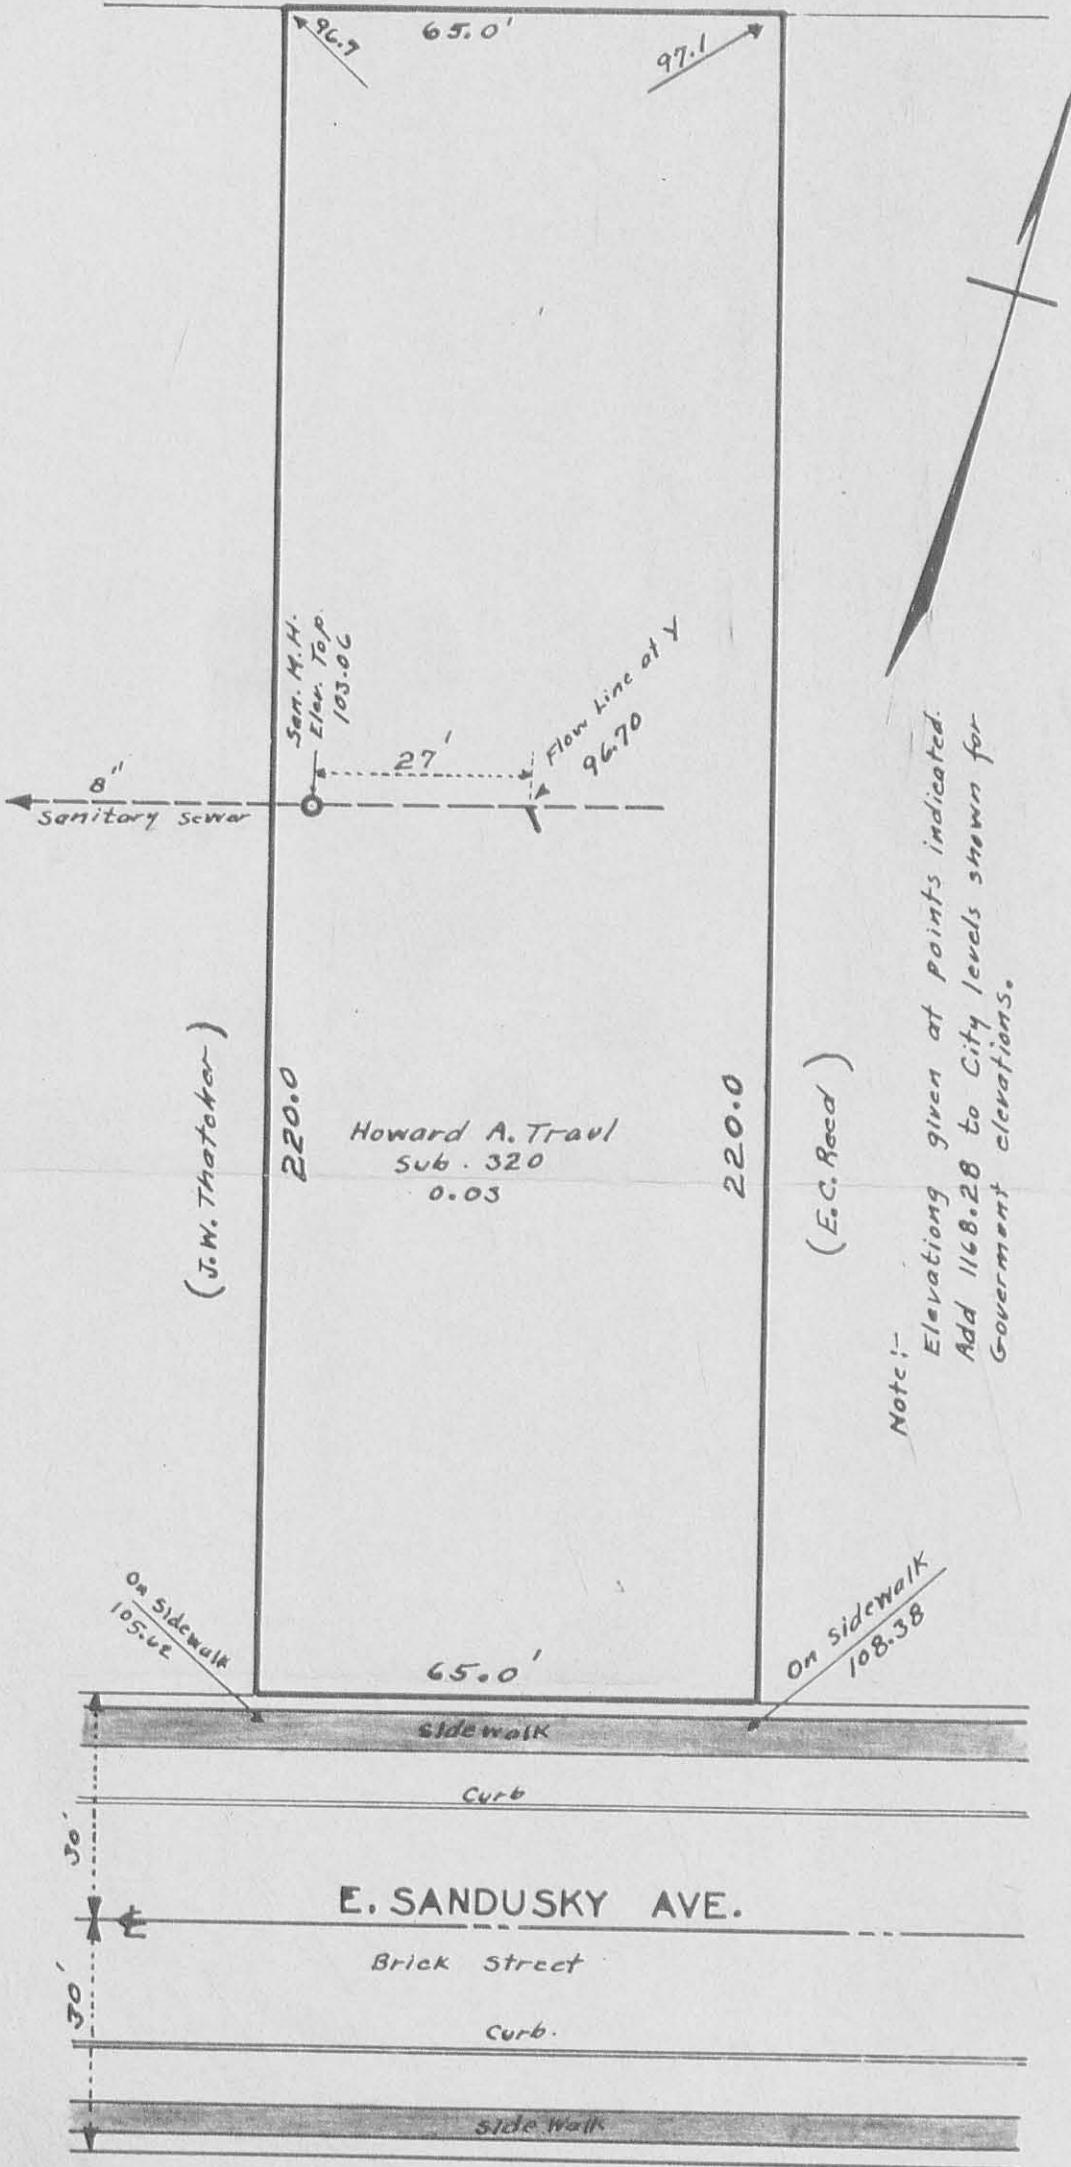


(Howard A. Traul)

95.6

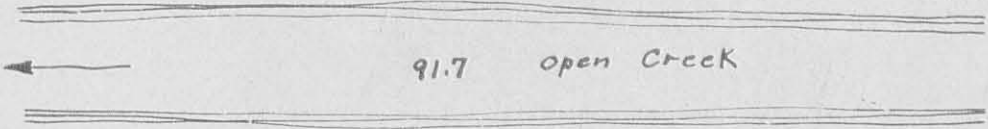

Note:-
Elevations given at points indicated.
Add 1168.28 to City levels shown for
Government elevations.

TRAUL LOT BELLEFONTAINE OHIO

JUNE 1950

1" = 25'

F.F. WRIGHT
ENGINEER

INDEXED ON MAP
2398 IP
INDEXED ON MAP

