


SPRING ST. 60'

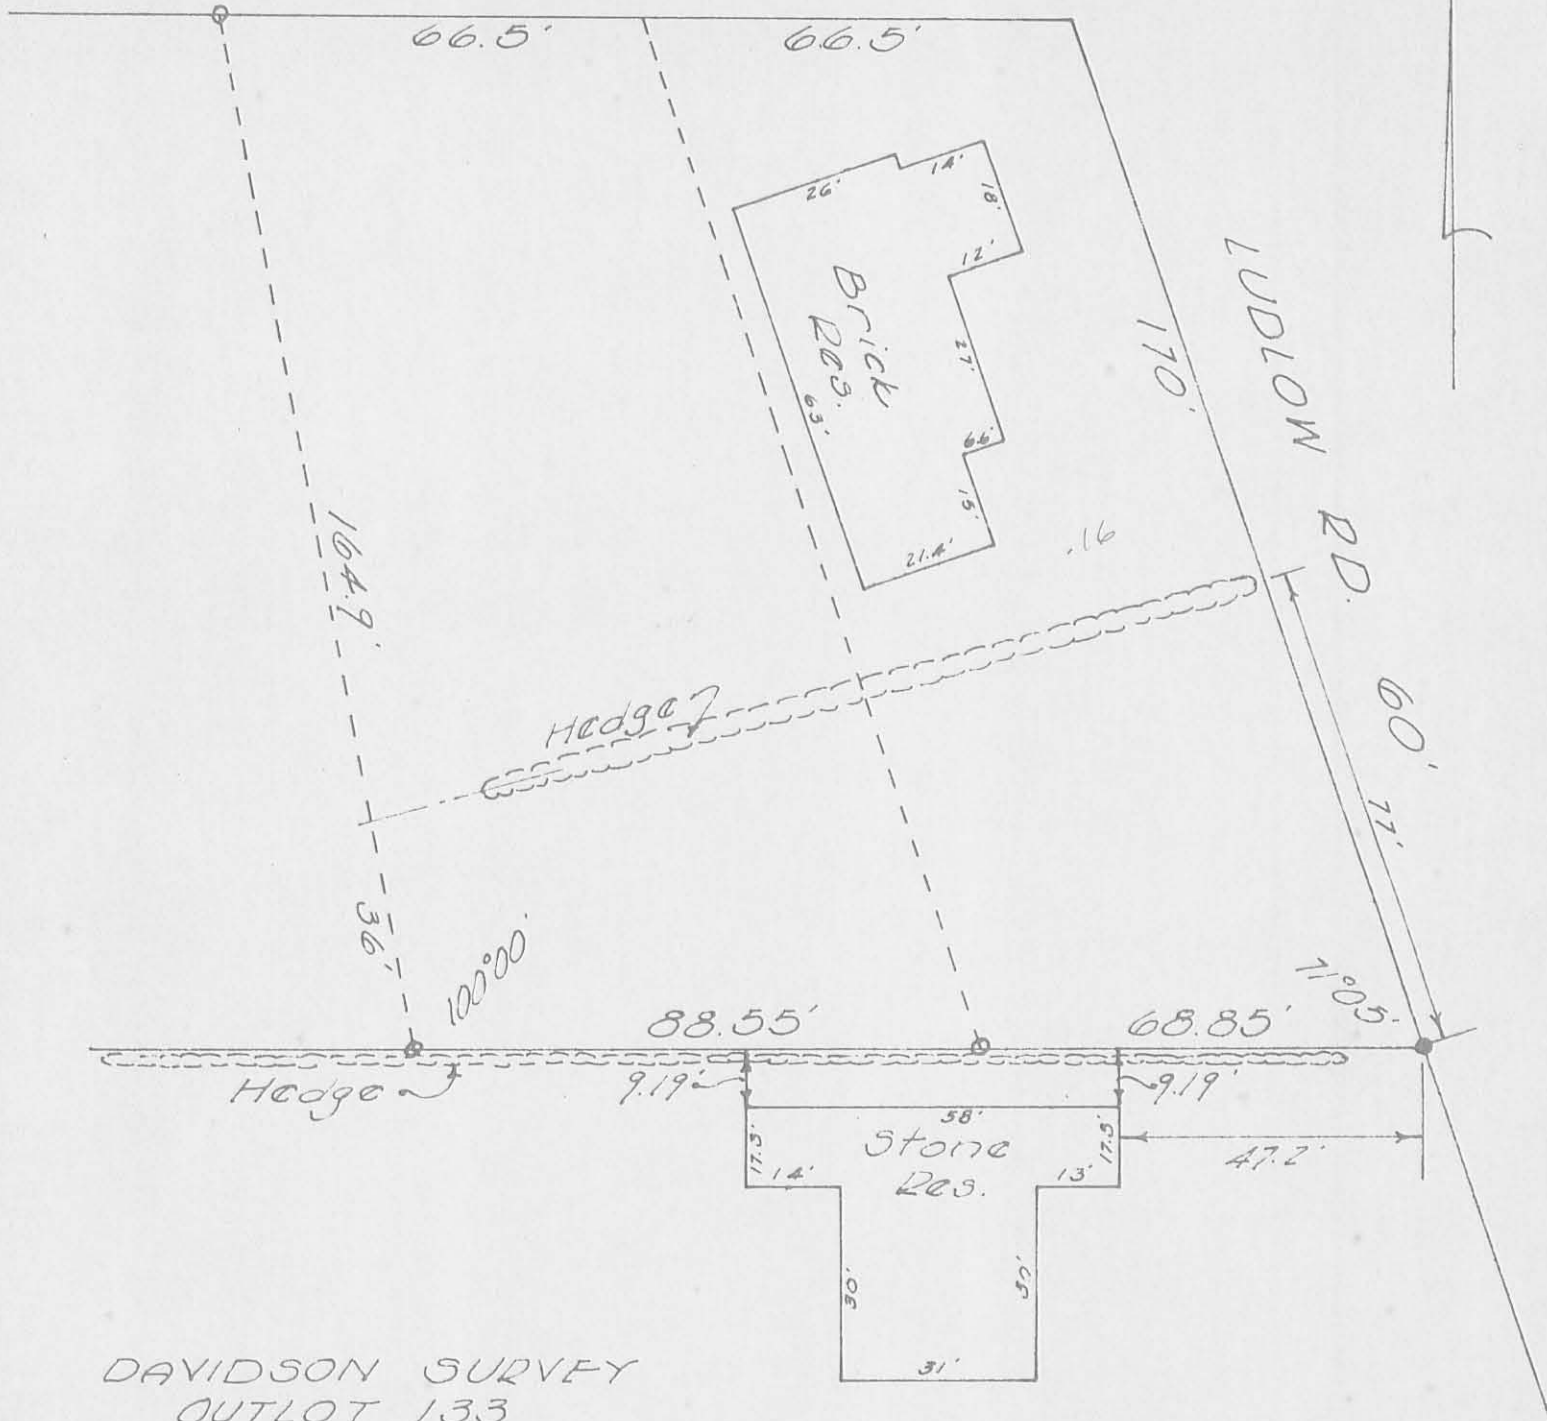

DAVIDSON SURVEY  
 OUTLOT 133  
 BELLEFONTAINE, O.  
 SCALE 1" = 30'  
 Oct. 11, 1963

o = Pipe Found

ON PENT BOOK  
 1-30-64  
 D.E.S.

INDEXED ON MAP

3651  
 1P

Dan L. Dodson  
 Dan L. Dodson  
 Reg. Surveyor 4270  
 Bellefontaine, O.