




INDEXED ON MAP
3766 1P

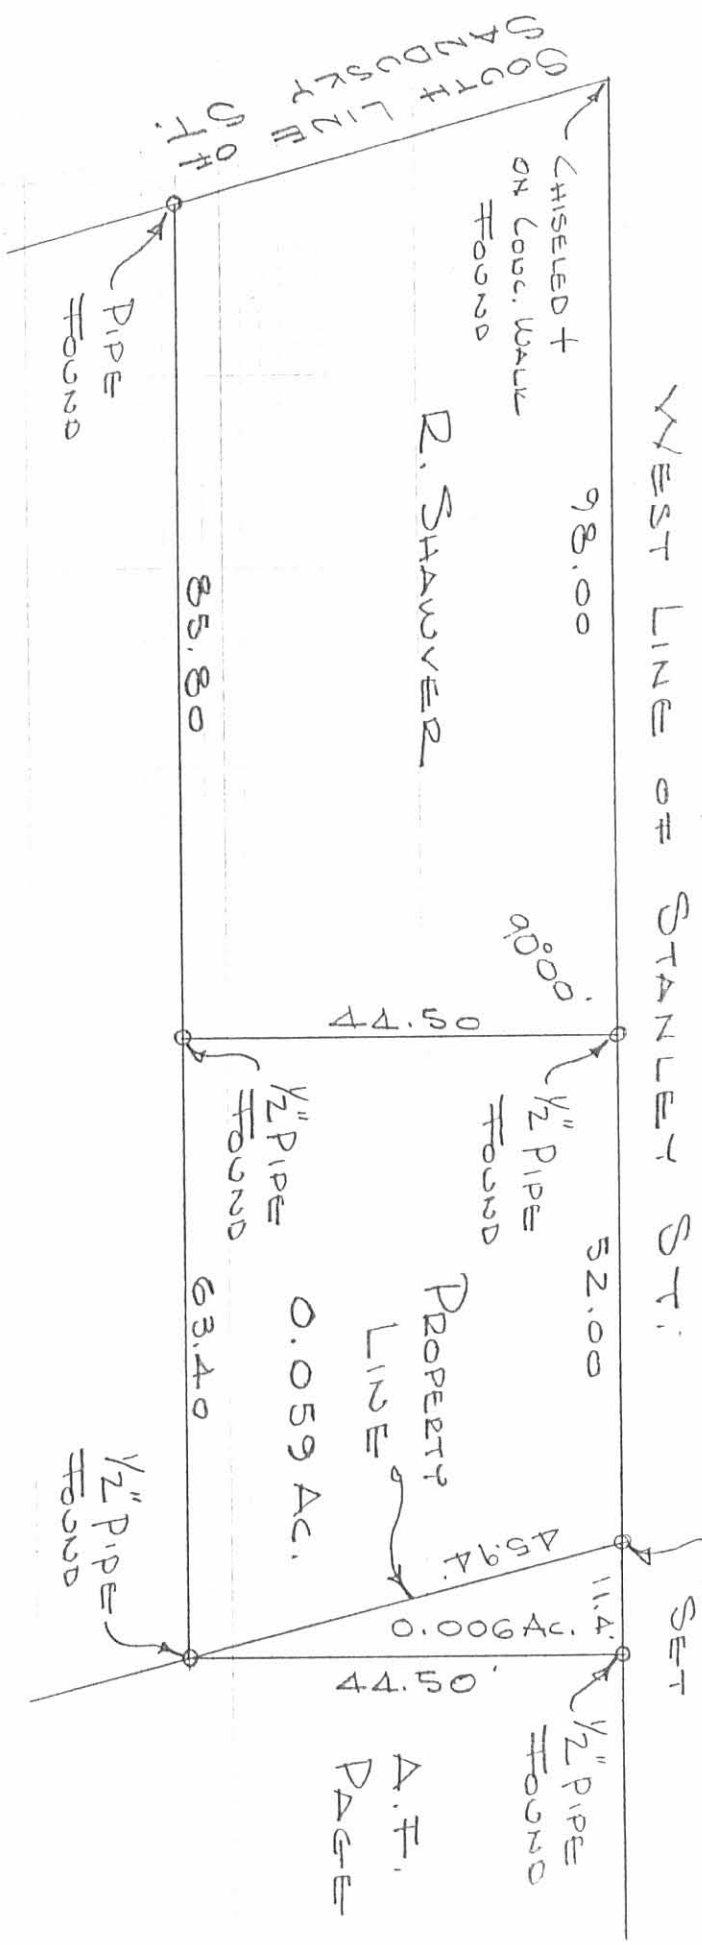

DEARING SURVEY
 V.M.S. 4990
 BELLEFONTAINE, OHIO
 JULY 1, 1972
 SCALE 1" = 20'

REF:
 DEED VOL. 301 PG. 413

DAN L. DOSSON
 REG. SURVEYOR 4270
 BELLEFONTAINE, OHIO
 BY 19/8

A.F.
 PAGE

Shawver - Peters Survey Bellefontaine March 1965

0.09 Acre
0.07 Acre

The following described land in the City of Bellefontaine, Lake Township, Logan County, Ohio and being in V.M.S. 4990.

North Tract

Beginning at the west side of Stanley Street and the south side of Sandusky Ave. Thence south with the west side of Stanley Street 98.00 feet to an iron.

Thence turning ninty degrees to the ~~left~~^{right} and measuring west 44.50 feet to an iron.

Thence turning ninty degrees to the right and measuring north parellel to Stanley Street 86.60 feet to an iron at the south side of Sandusky Ave.

Thence with the south side of Sandusky Ave. Eastward 46.00 feet to the place of beginning.

The above described tract contains 0.09 of one acre and is off of the north end of a 0.16 acre tract now in the name of O.B.Shawver.

South Tract

Beginning at the west side of Stanley Street and the south side of Sandusky Ave. Thence south with the west side of Stanley Street 98.00 feet to an iron. Said iron being the ~~top~~ true beginning point of this survey.

Thence again south with the west side of Stanley Street 63.40 feet to an iron.

Thence turning ninty degrees to the right and measuring west 44.50 feet to an iron.

Thence turning ninty degrees to the right and measuring ~~east~~ north 63.40 feet to an iron.

Thence turning ninty degrees to the right and measuring east 44.50 feet to the place of beginning.

The above described tract contains 0.07 of one acre and is off of the south end of a 0.16 acre tract now in the name of O.B.Shawver.

cc
Logan County Engineer



3766 2D

INDEXED ON MAP

on Plat Book
3/15/65
D.E.G.
P. 48

DEARING SURVEY
BELLE FONTAINE

A = 1/2" pipe FOUND 1.6' W. OF WALK
3/4" pipe FOUND 0.3' N. & 0.15' W.
OF 1/2" PIPE - USED 1/2" PIPE

B = 1/2" PIPE FOUND 1.6' W. OF WALK
1.0' N OF FENCE


C = Chiseled + on walk FOUND

D = 1/2" PIPE FOUND - 3/4" PIPE FID. 0.4' E.

E " " "

F " " "

STELLA LAMBERT Vol 301 / 413
SURVEYED BY F. F. W.

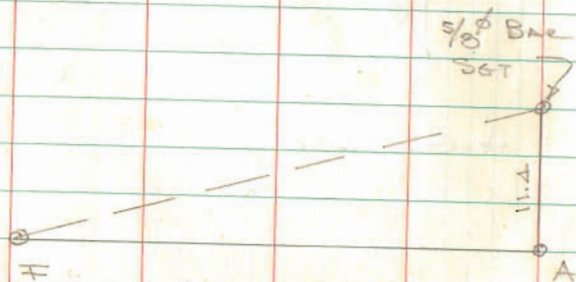

EXCEPTION IN DEED Vol 301 PG 413

INDEXED ON MAP
3766

DORSON
ARTIS

7/1/72

08

