


SURVEY OF LOTS 1289 & 2394
BELLEFONTAINE, O

See City Eng F.B 243 pg 65
 " " " 234 69
 " " " 198 96


+ = Chiseled cross in Concrete, cut. 2.0' N. of wall
 O = $\frac{3}{8}$ " Rebar set
 □ = 2x2x12" Hub set

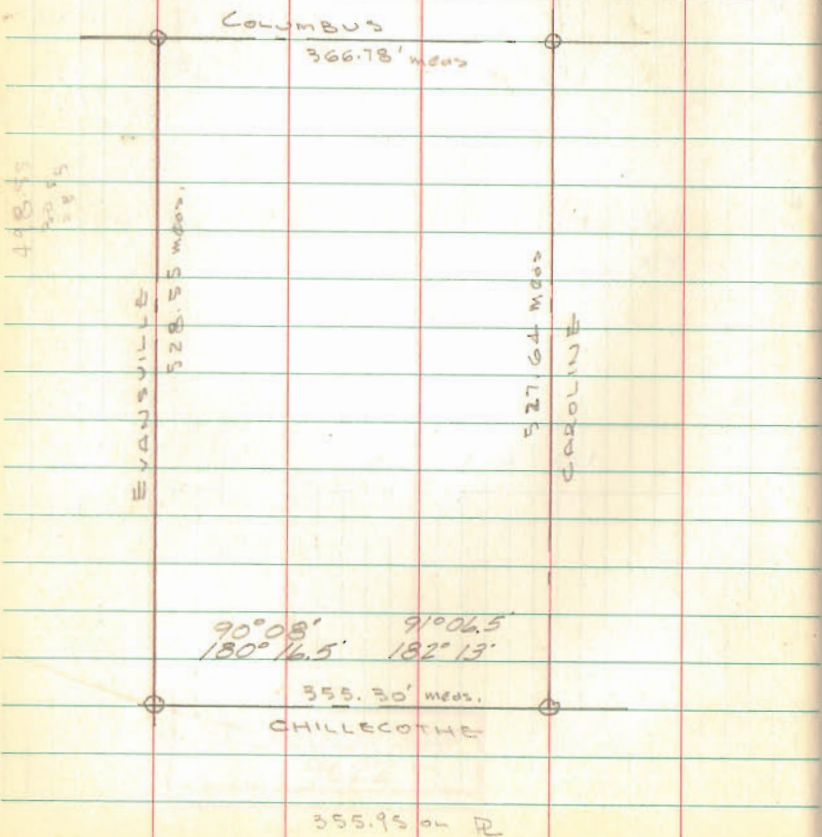

DOBSON
WHITLOW

2-5-66
30°
Snow

51

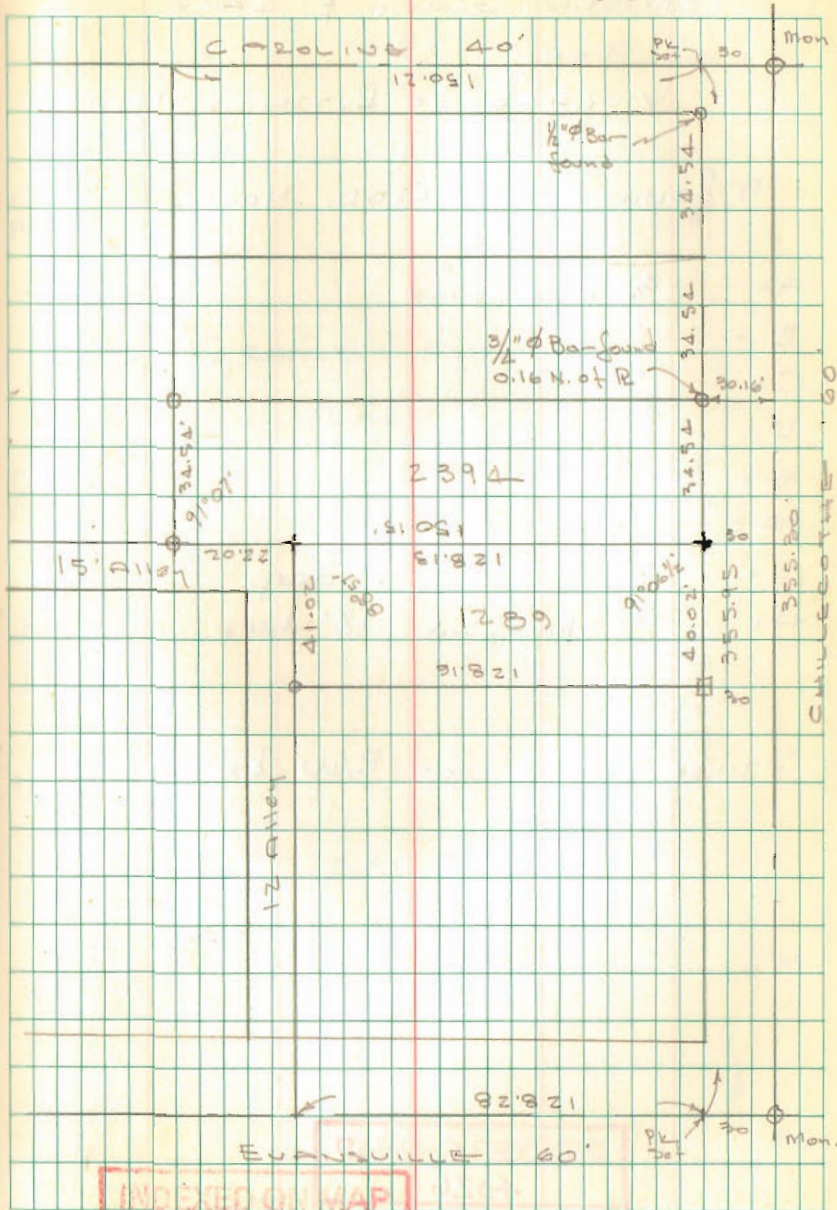

INDEXED ON MAP
4020