



Survey of Court House  
 Bellefontaine, Ohio.

C. Keyser Feb. 2, 1948  
 J. D. Mitchell Cloudy & Cool  
 I. O. Dodson

34

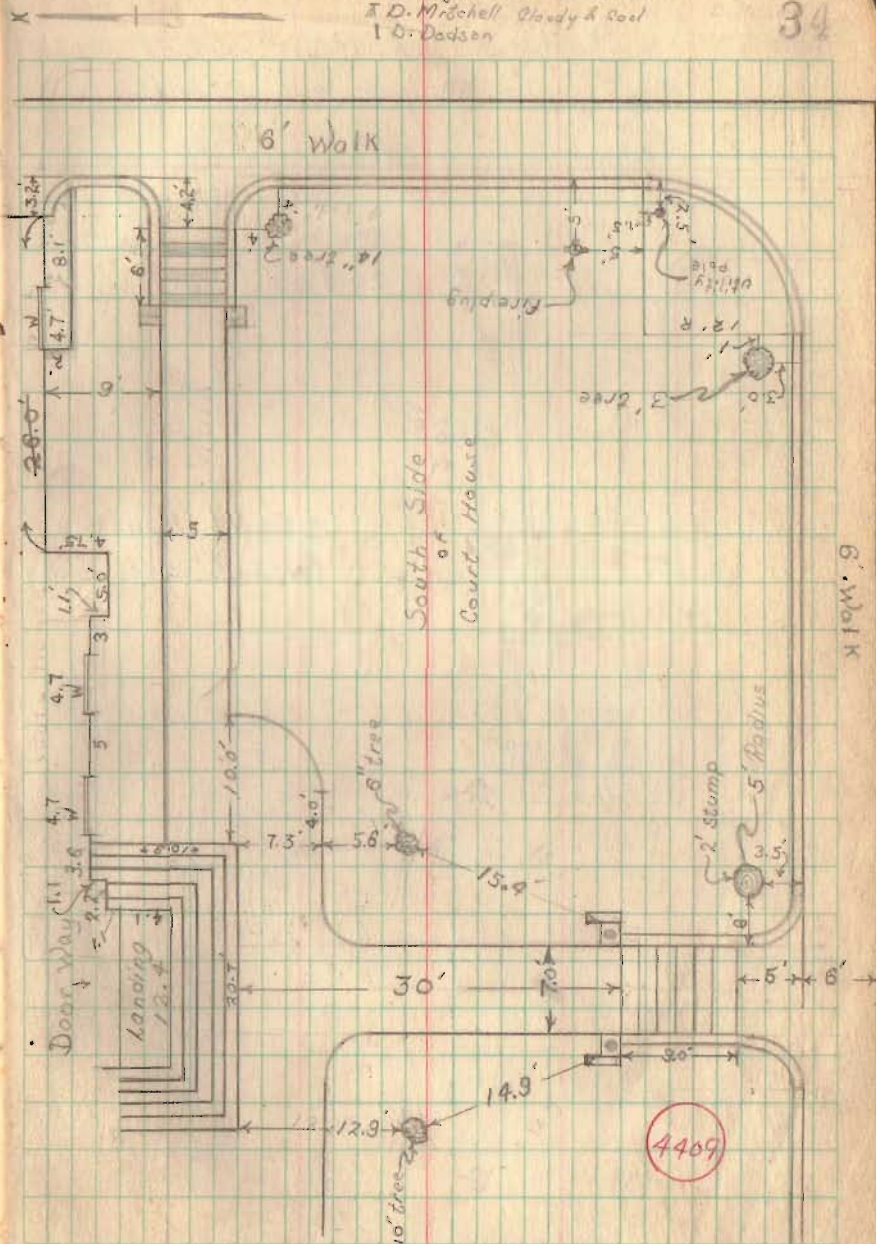

Survey of Court House (Contd)  
Bellefontaine, Ohio

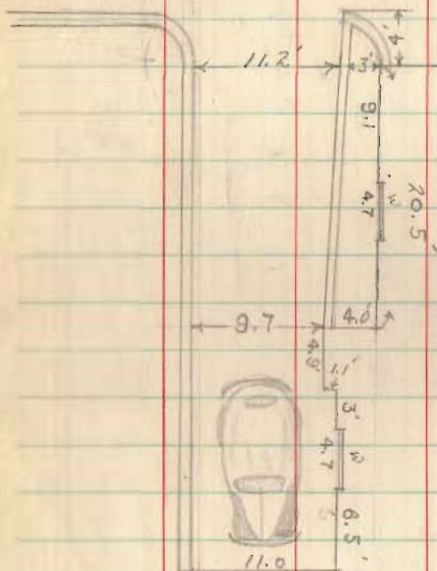

Court House  
North & East sides



29.4

20.4

(cont'd)

Survey of Court House  
Bellefontaine, OHIO

