
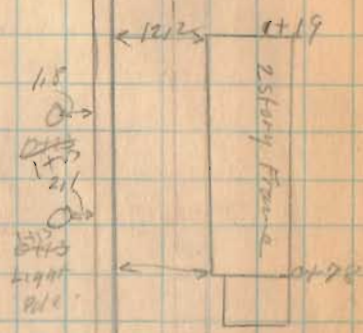


I.C.H. 130 W. Sandusky Ave



July 28 1930 25

cloudy  
Wright.  
M=Kirkham.

& Walker 1 to 7 1/2

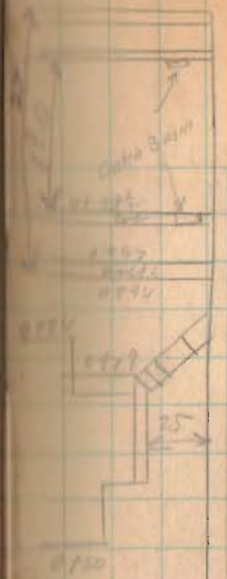

2 Story  
Frame  
# 504  
W. C. Brownfield

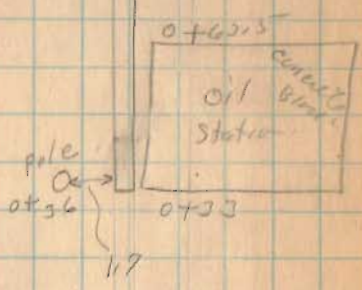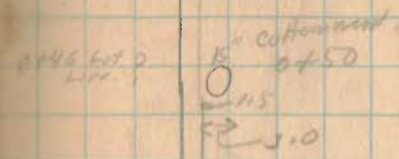

INDEXED ON MAP

4932



0+00 End of Present concrete 0+13



Gas Pank  
-3 feet  
on property  
-10.0





