


6401 1P

INDEXED ON MAP


West Auburn Avenue - 60'

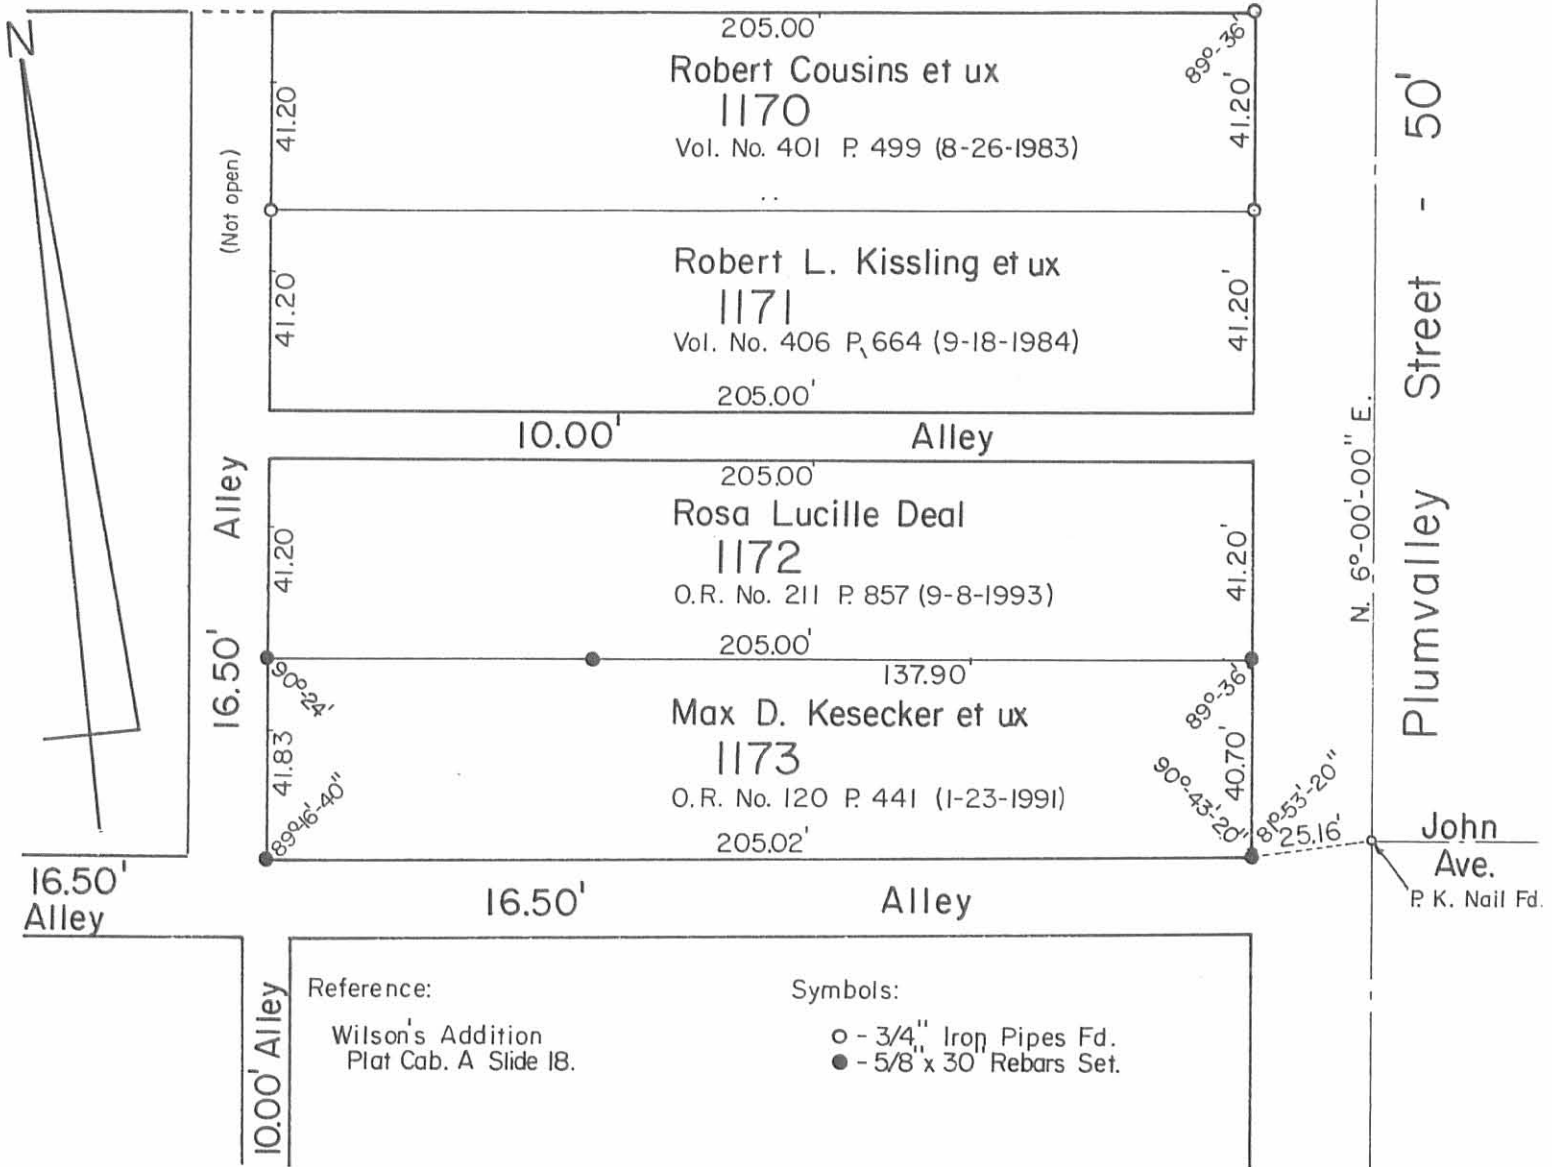

Max D. Kesecker Survey
 Lot No. 1173
 City of Bellefontaine
 Lake Township
 Logan County, Ohio
 July 12, 1994



Daniel E. Gilbert
 DANIEL E. GILBERT, P.S.
 REG. SUR. NO. 5402
 400 N. PARK ST.
 BELLEFONTAINE, OHIO 43311
 TELEPHONE: 1 (513) 593-1428

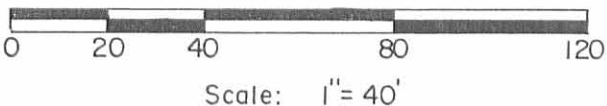

INDEXED ON MAP
 6401 2P

094-047