


ALLEY 15'

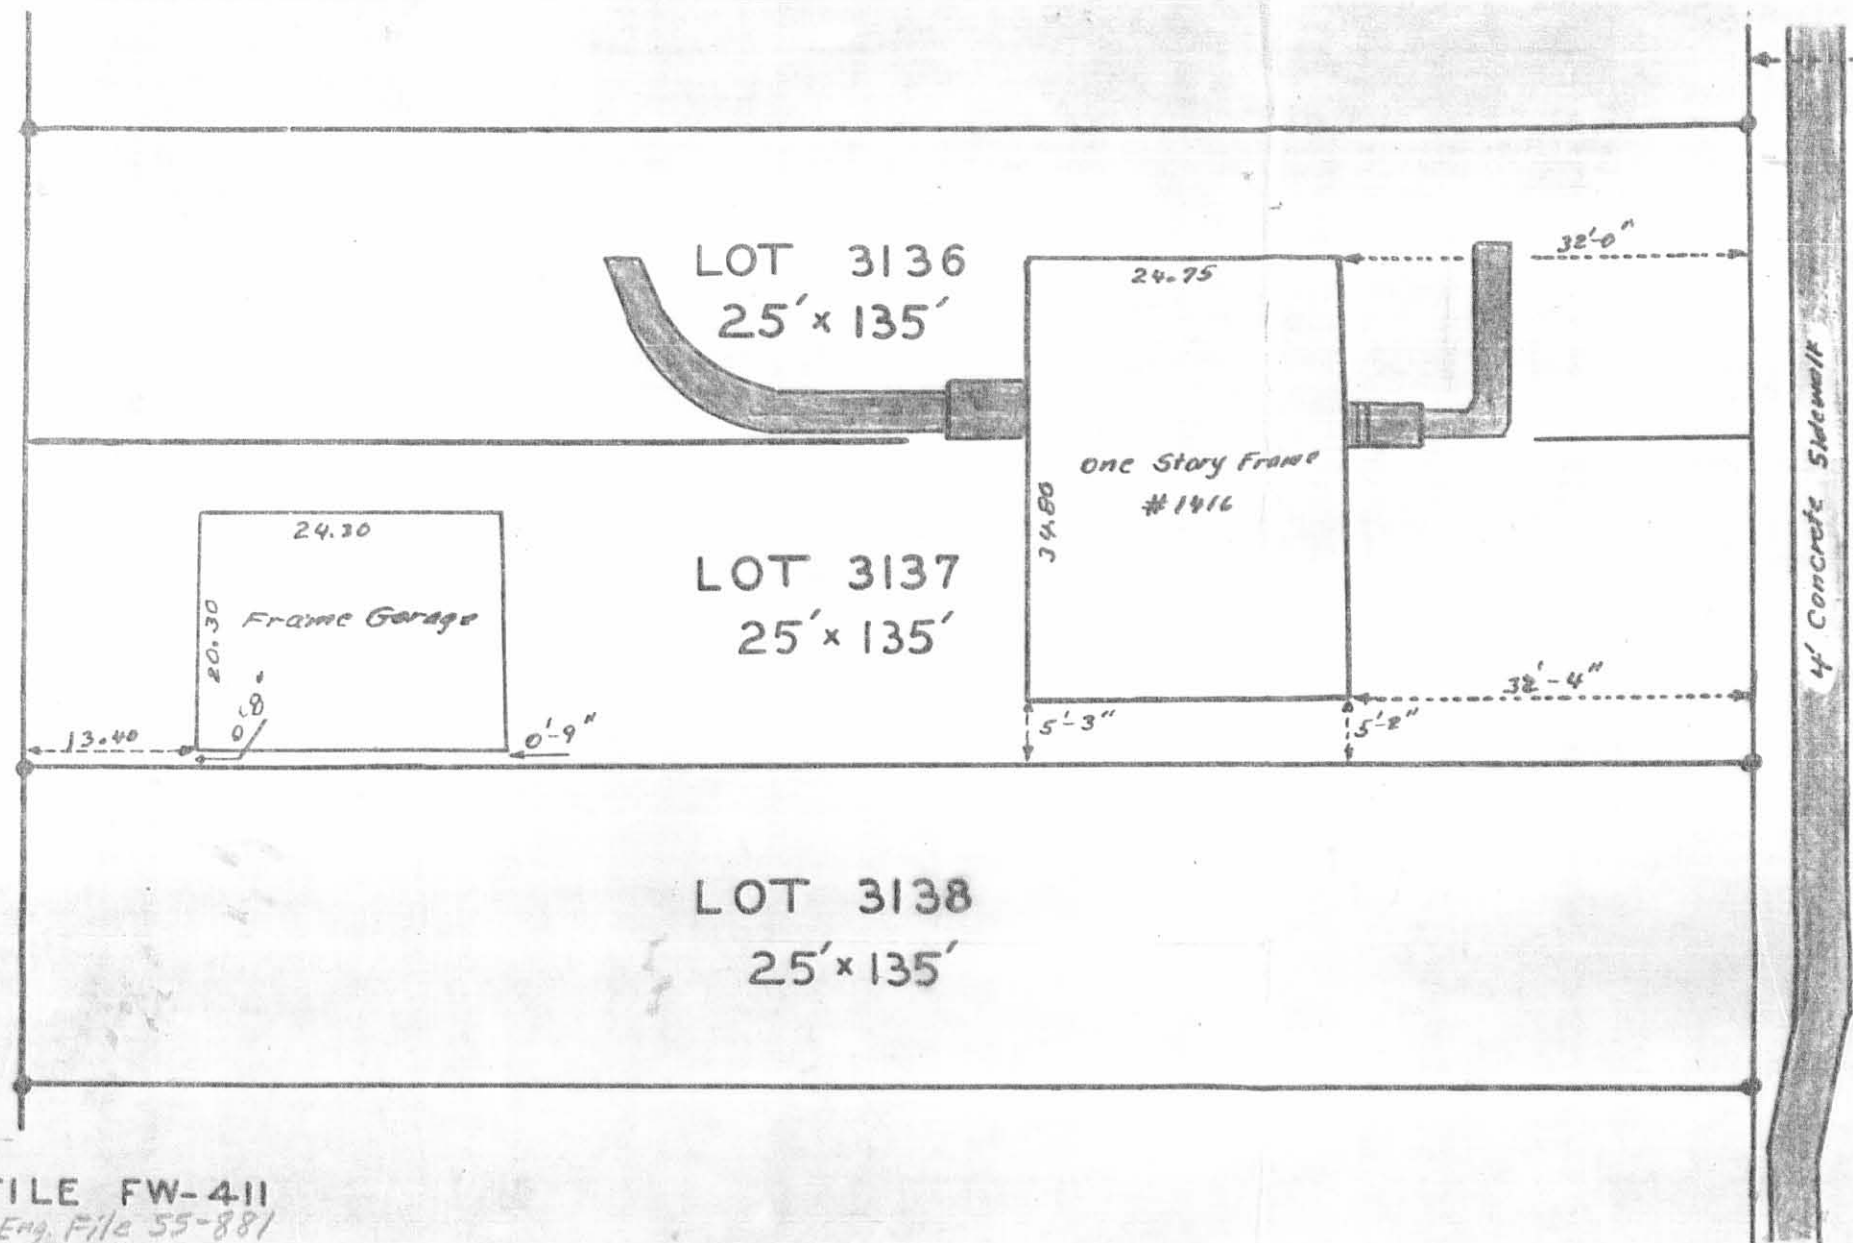


S. MAIN STREET
U.S. ROUTE 68

FILE FW-411
City Eng. File 55-881



6424 IP
INDEXED ON MAP

ELMORE SURVEY
 BELLEFONTAINE OHIO
 APRIL 1962
 1" = 15'
 0' 10' 20' 30' 40'

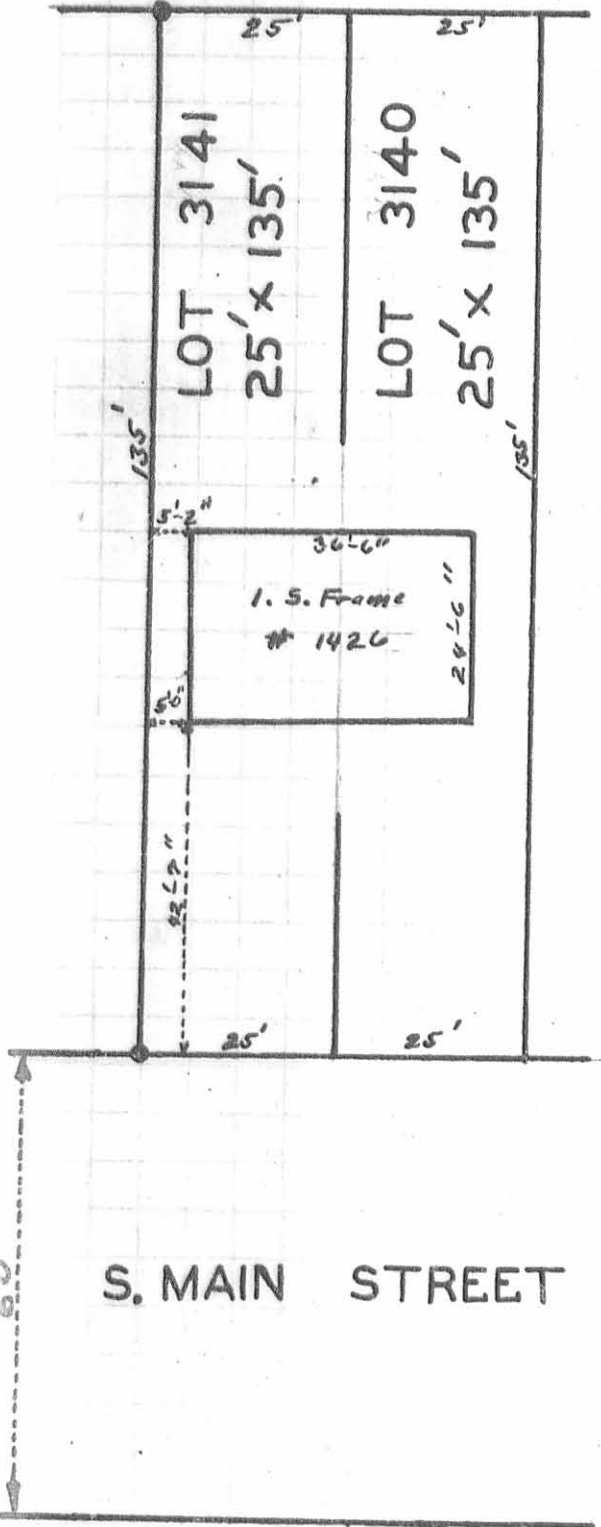

LOTS 3140-3141
CLARKS PARK ADDITION

ELMORE SURVEY
BELLEFONTAINE OHIO
OCT. 1952
FF WRIGHT
1" = 25'

6424 2P

INDEXED ON MAP

● Irons

I find no encroachments
on Lots 3140-3141
JUNE 15 1952
F.F. Wright