
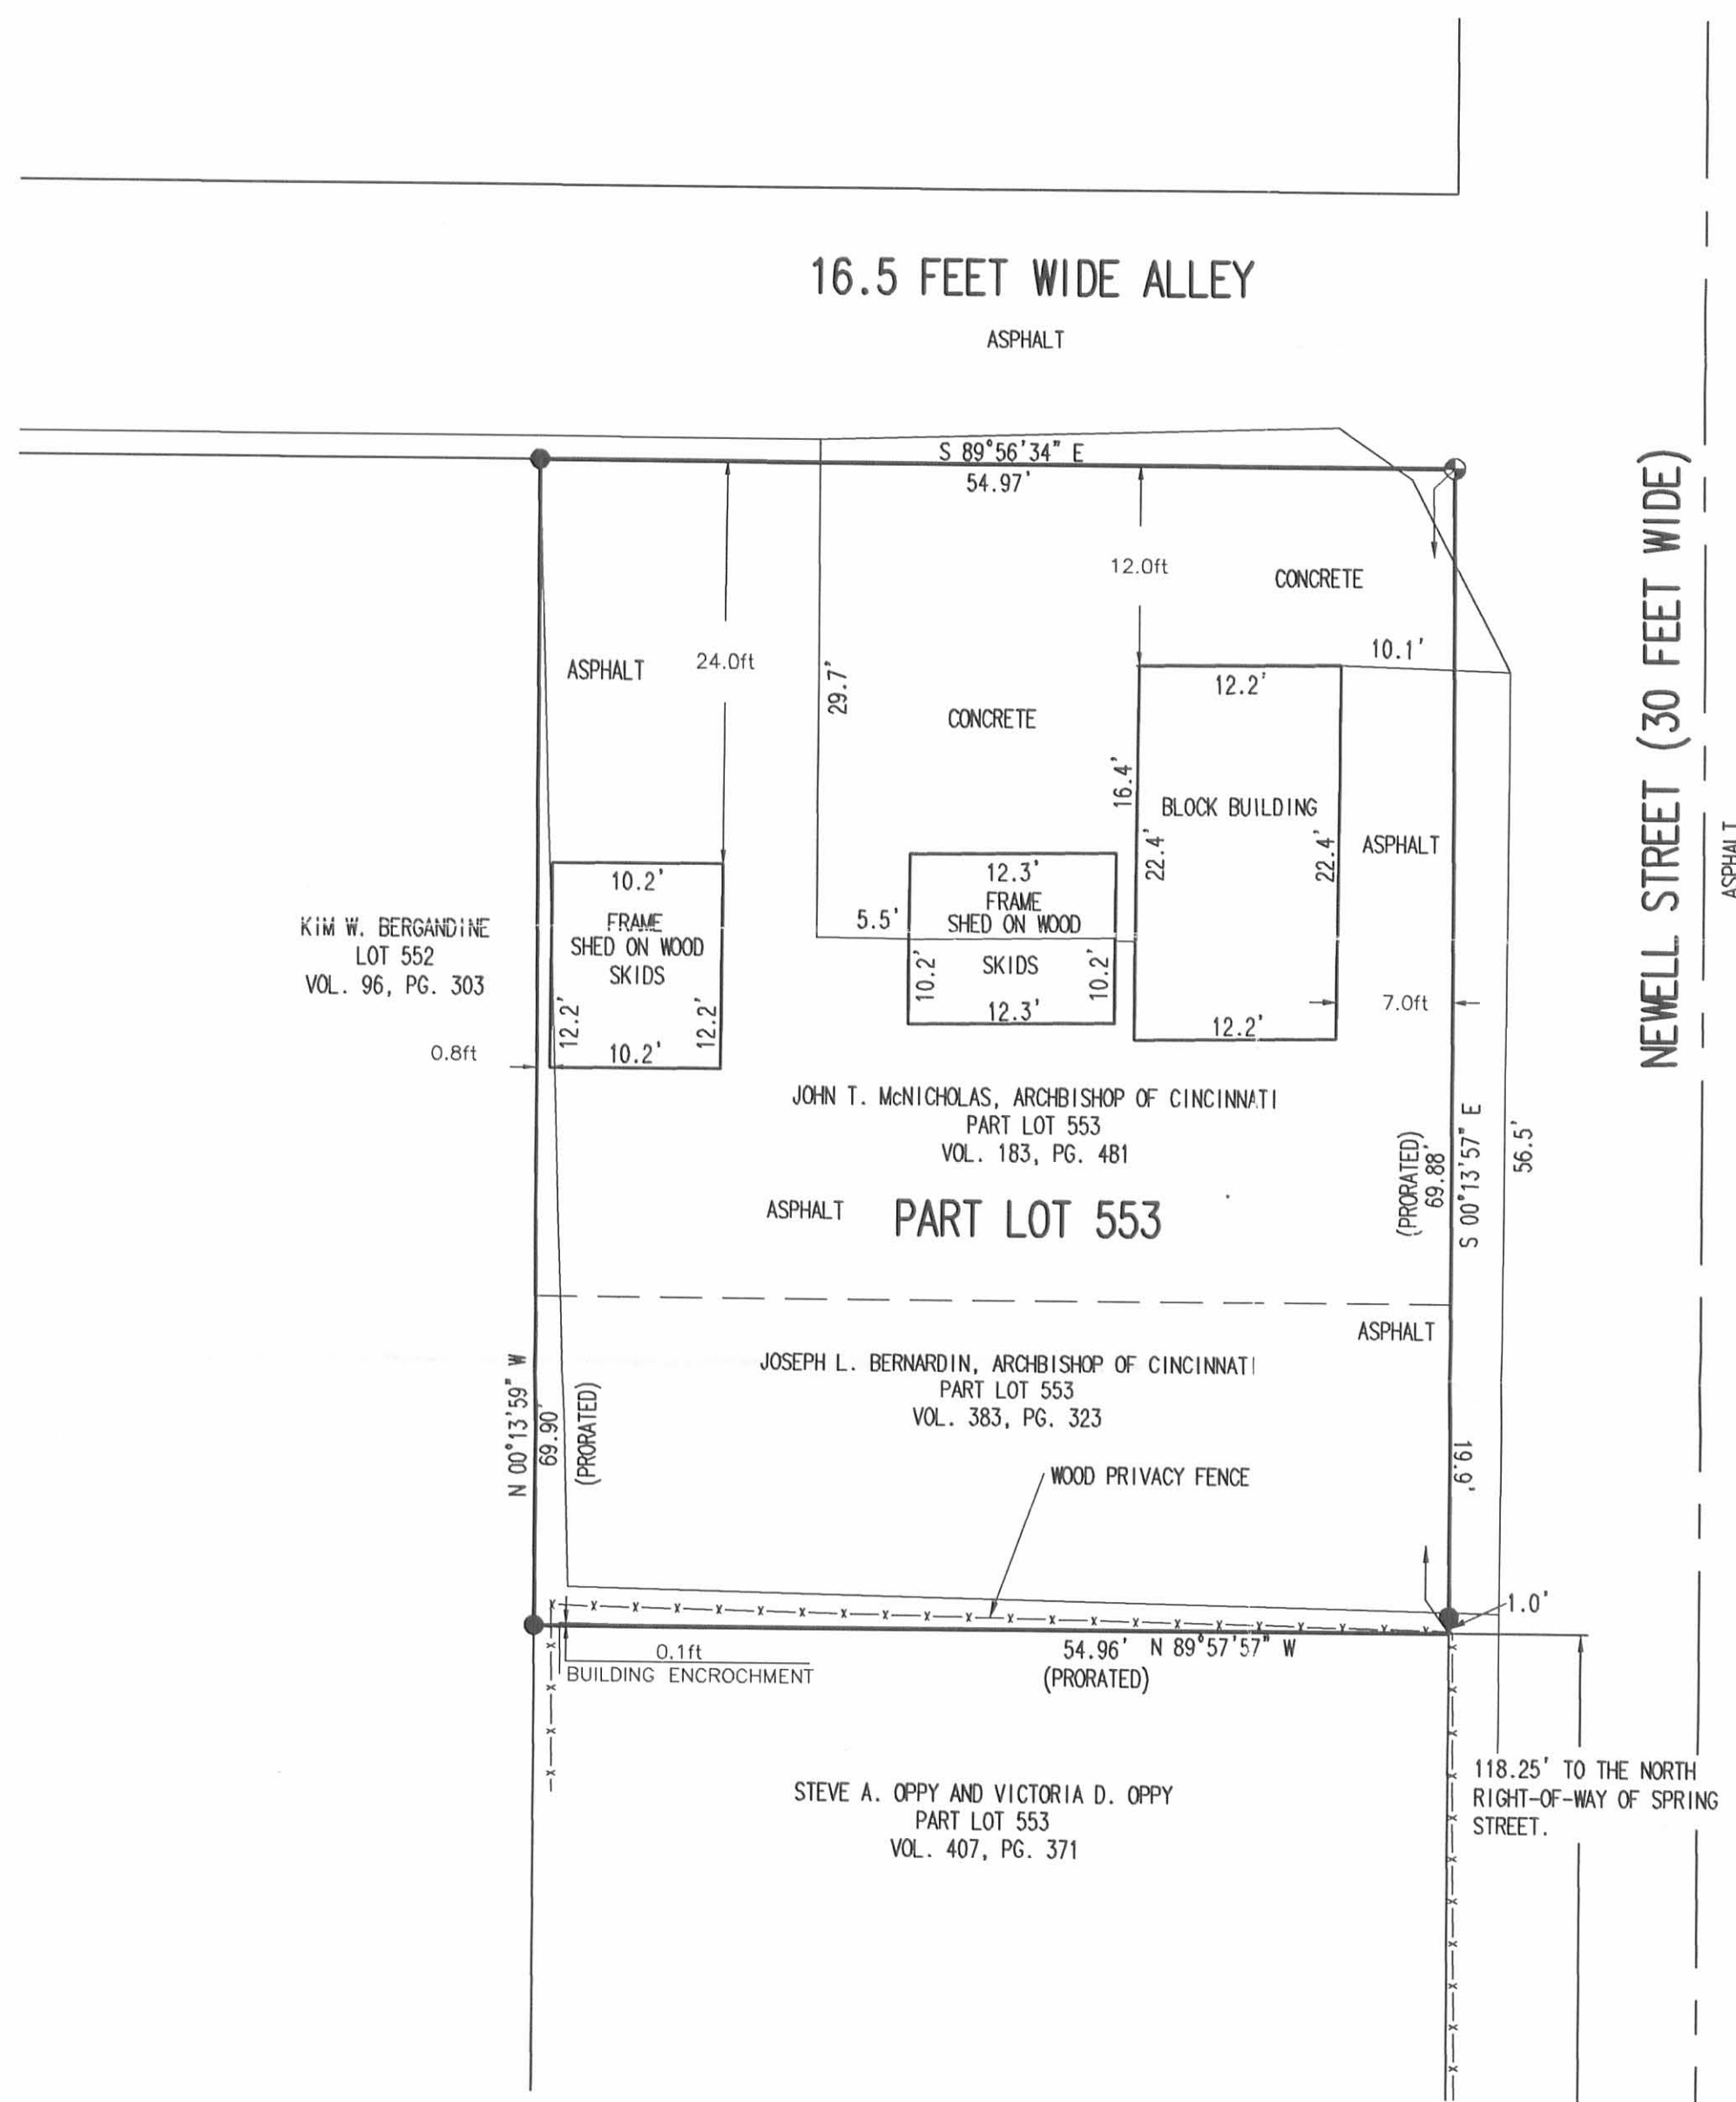


REV'D 10-11-04 SMY BK

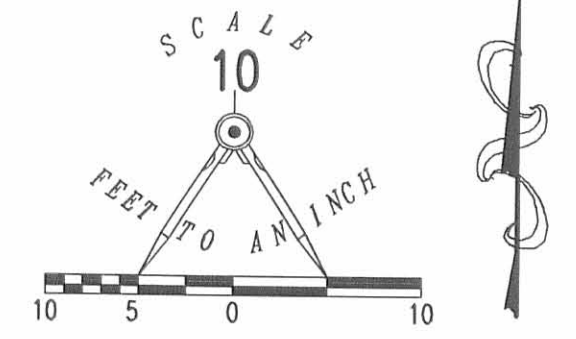

- LEGEND
- 5/8 INCH IRON ROD SET
 - 5/8 INCH IRON ROD FOUND
 - ⊗ P.K. NAIL FOUND
 - ⊙ MAG NAIL SET
 - ⊙ 1 INCH IRON PIPE FOUND
 - ⊙ 3/4 INCH IRON BAR FOUND
 - ⊗ 4" X 4" STONE MONUMENT FOUND IN MONUMENT BOX
 - ⊙ RAILROAD SPIKE SET

A SURVEY OF
PART OF LOT 553
McCULLOUGH ADDITION
PLAT CABINET A, SLIDE 5
JOHN T. McNICHOLAS, ARCHBISHOP OF CINCINNATI
VOLUME 183, PAGE 481
AND JOSEPH L. BERNARDIN, ARCHBISHOP OF CINCINNATI
VOLUME 383, PAGE 323
CITY OF BELLEFONTAINE
LAKE TOWNSHIP
LOGAN COUNTY, OHIO

INDEXED ON MAP
6463 1P



SURVEYED BY:
[Signature]
JEFFREY L. LEE
PROFESSIONAL SURVEYOR 6359
SEPTEMBER 21, 2004

COPYRIGHT 2004 BY:
LEE SURVEYING & MAPPING CO.
117 North Madriver Street .. INC.
BELLEFONTAINE, OHIO 43311
(937) 593-7335
ADW D413 3910094A L-3910094-2


2 WORKING DAYS
BEFORE YOU DIG
CALL TOLL FREE 800-362-2764
OHIO UTILITIES PROTECTION SERVICE

~~Dott Zupp~~
~~Bellefontaine, O~~

May 56

35

16½' Alley

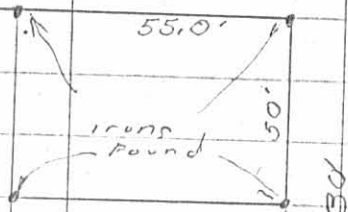

553

Newell 30'

Xon
cancer.

55.0'

Spring 60'

4463 2P

INDEXED ON MAP