


Deat City

Sept. 7 59

F.B. O.K. SHIRK #5 PG 61

61

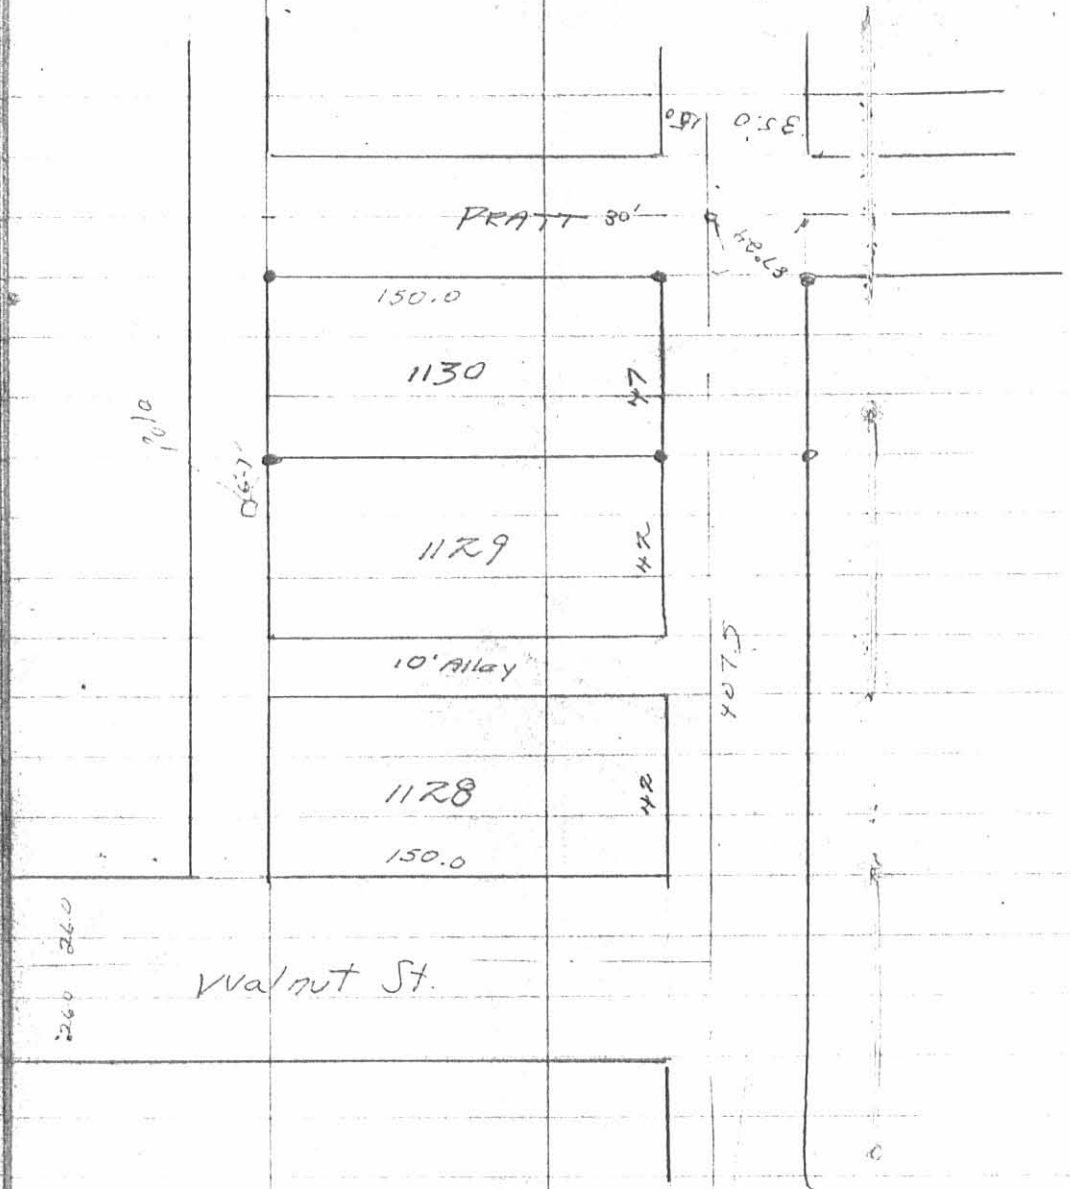

6495 IP

INDEXED ON MAP