

MAGNUSON TO MALLOW

Lying in the City of Bellefontaine, Lake Township, Logan County, Ohio.

Being the north 72.00 feet off city Lot Number 541, said part lot being 55.03 feet wide by 72.00 feet in depth and containing 3963 square feet (0.091 acre).

Last previous deed reference: Volume 397, Page 92.

Surveyed by:




Jeffrey I. Lee  
Reg. Surveyor No. 6359  
2-14-83


6803 ID

**WORKED ON MAY**



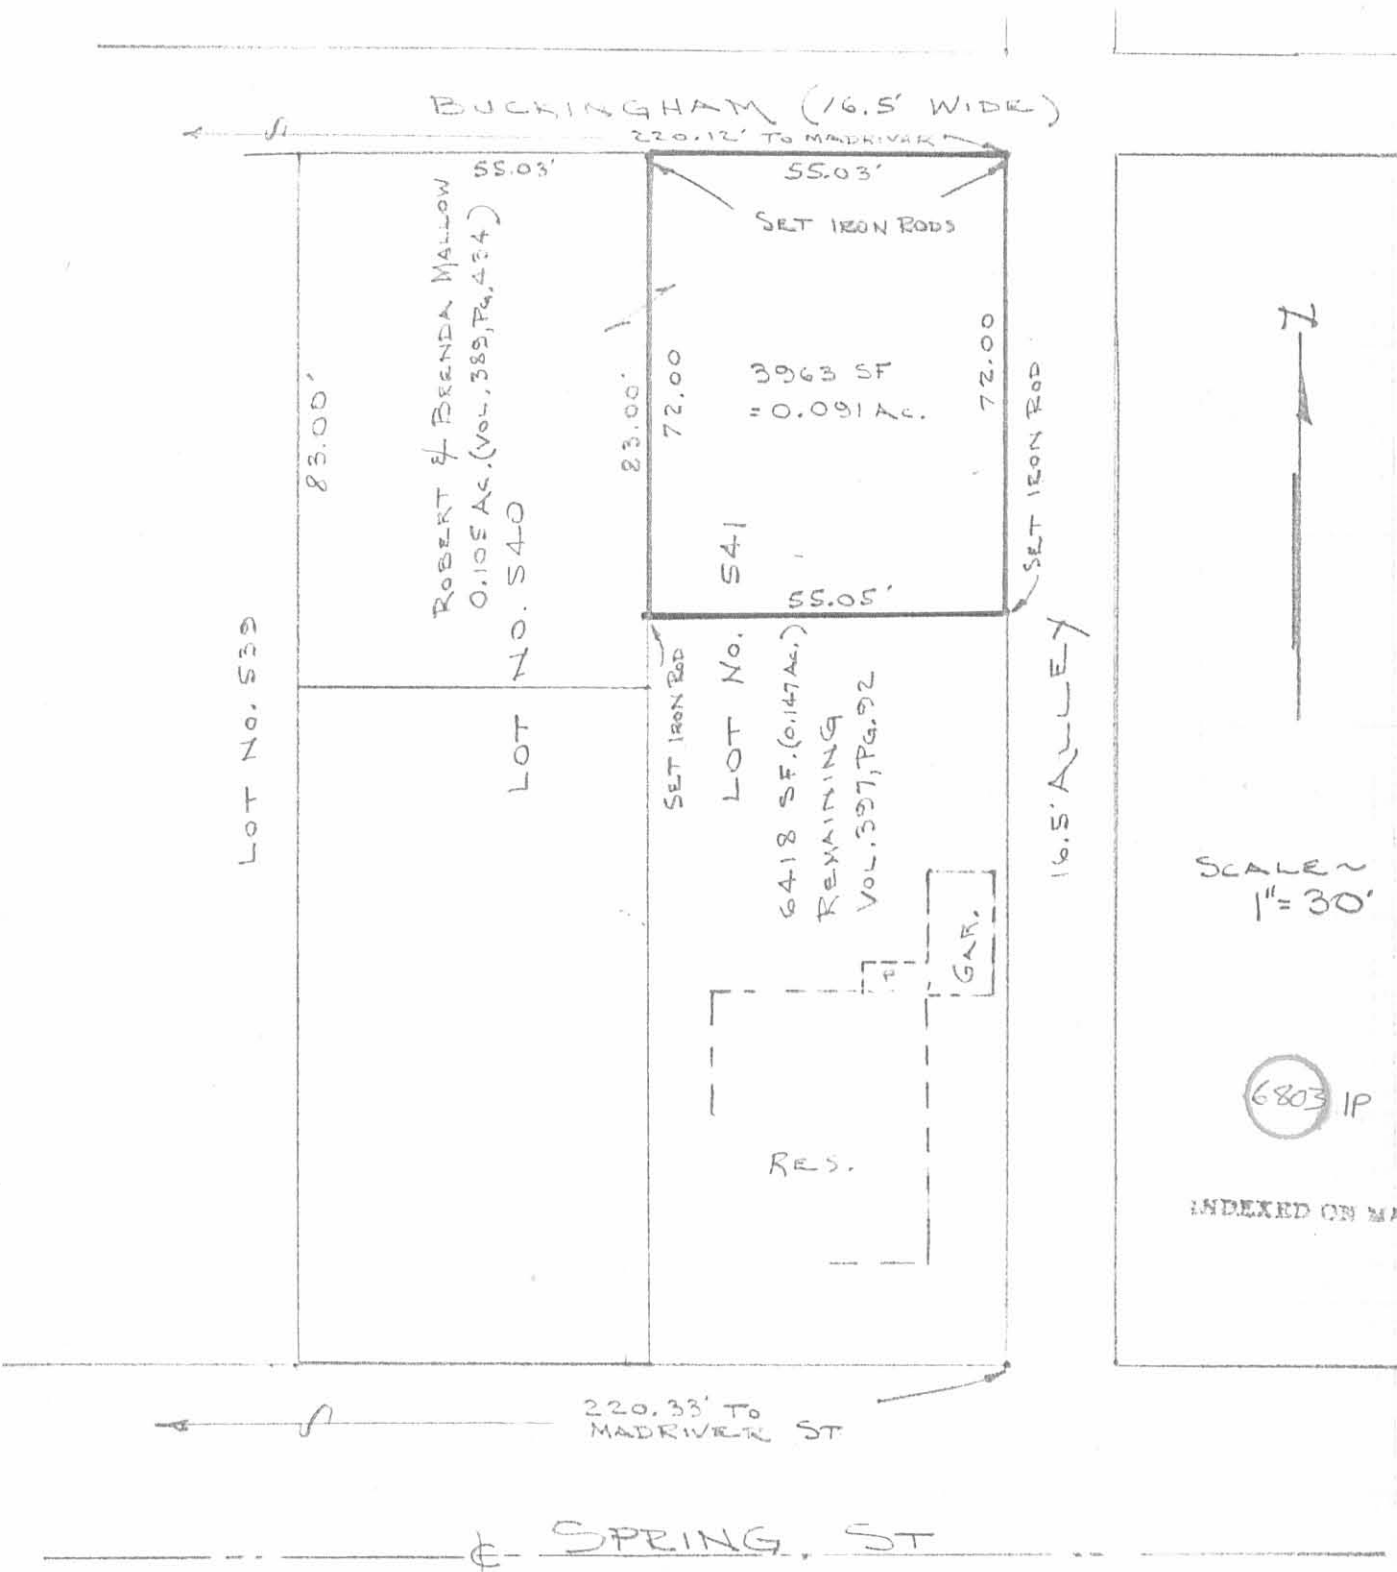

SURVEY OF THE NORTH 72.00 FT. OF LOT No. 541  
CITY OF MOUNTAINE,  
LAKE TOWNSHIP, MOUNTAIN COUNTY, OHIO

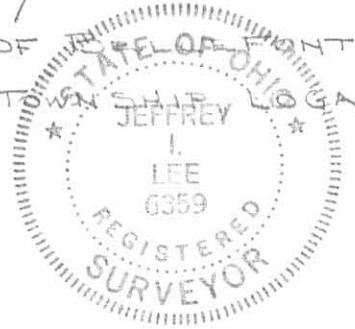

BY *Jeffrey I. Lee*  
JEFFREY I. LEE  
REG. SURVEYOR 6359  
2-14-83