


MAP ROOM

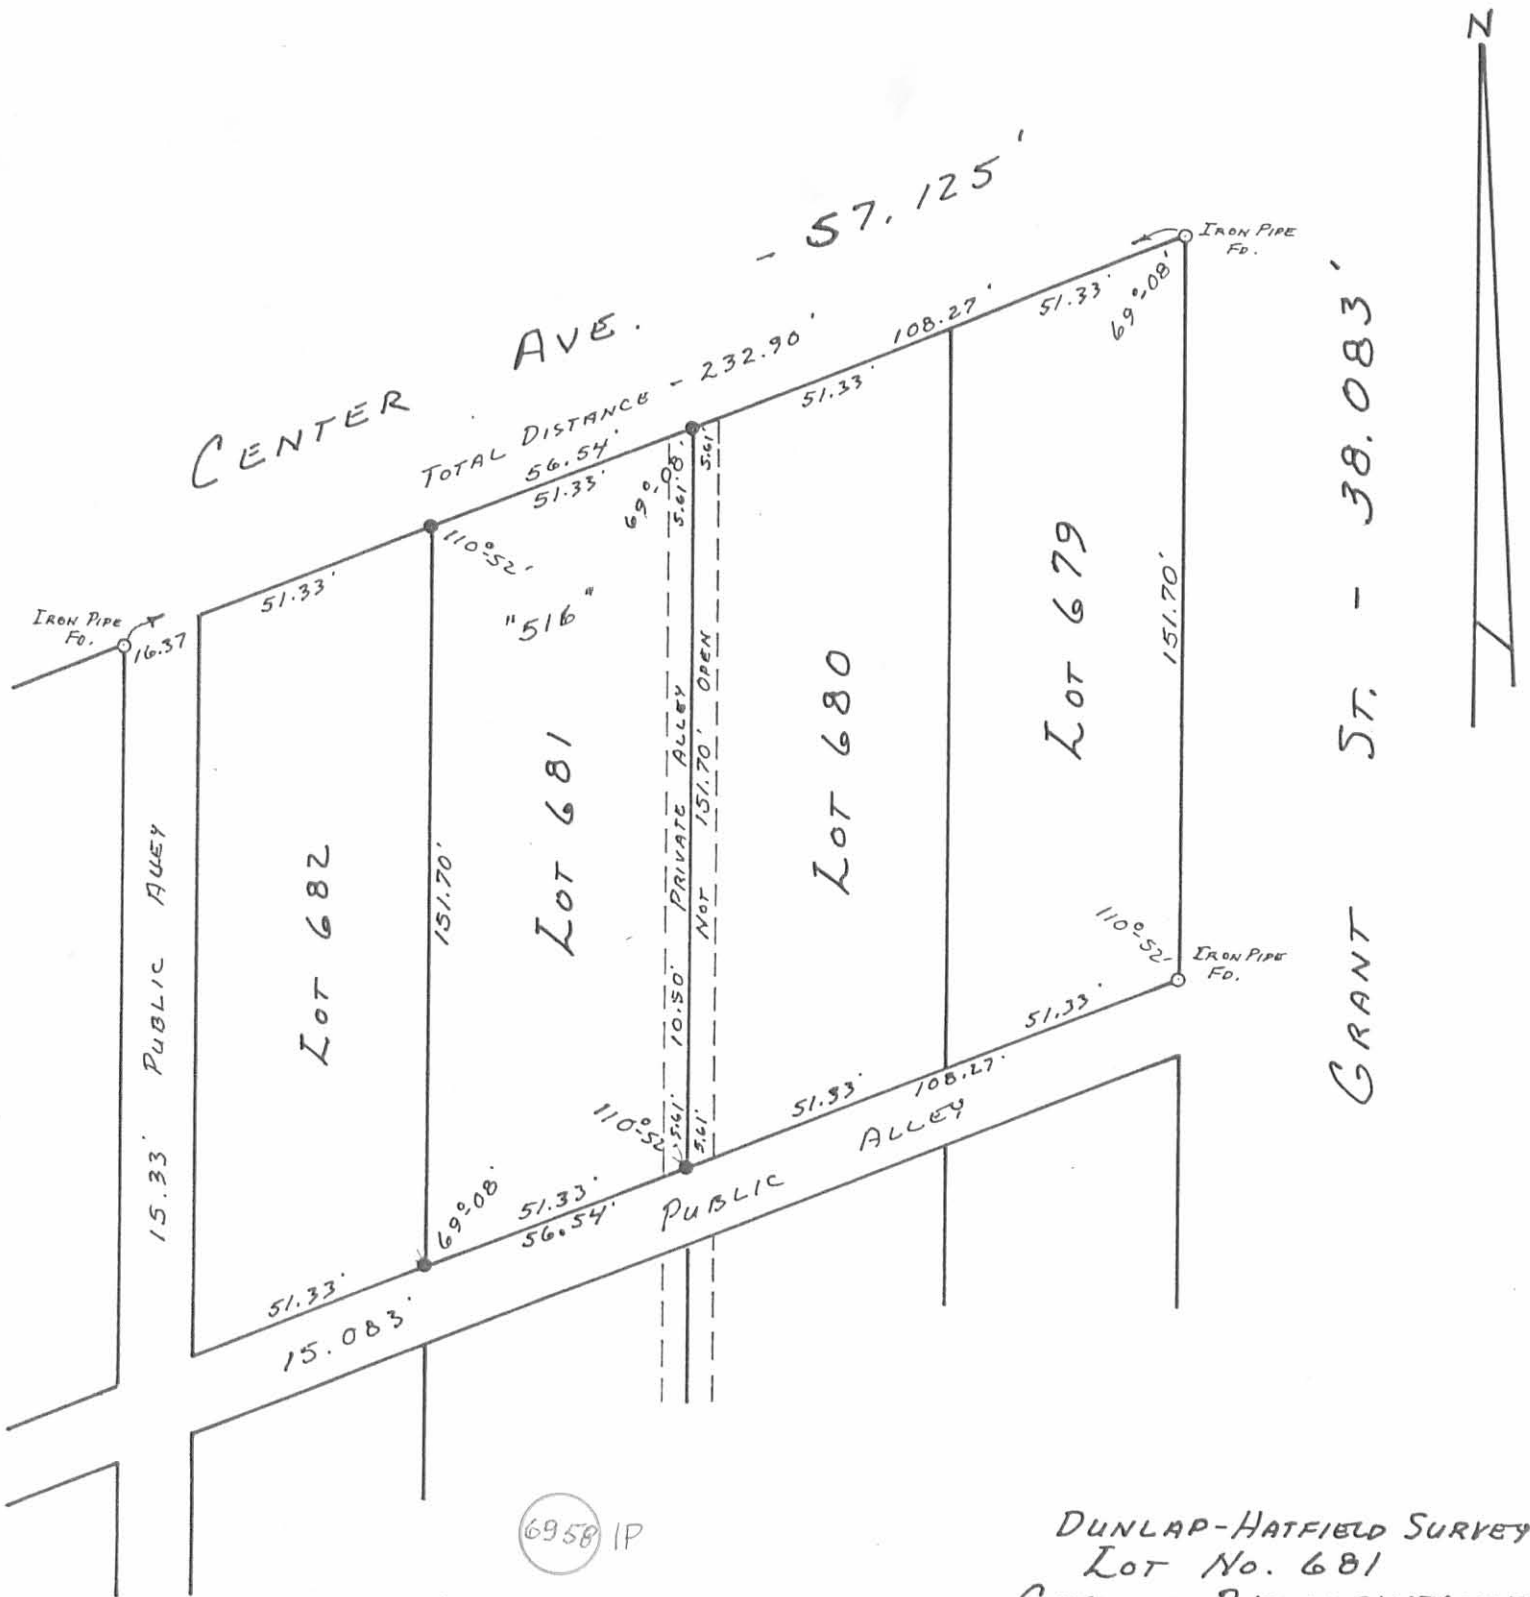

6958 IP

INDEXED ON MAP

DUNLAP-HATFIELD SURVEY  
 LOT No. 681  
 CITY OF BELLEFONTAINE  
 LAKE TOWNSHIP  
 LOGAN COUNTY, OHIO  
 APRIL 14, 1984

SURVEYED AND PLATTED BY:  
 DANIEL E. GILBERT P.S.  
 REG. SUR. No. 5402  
 1041 N. MAIN ST.  
 BELLEFONTAINE, OHIO 43311

SCALE: 1" = 40'