


REC'D 1-31-95 SAM

WEST SANDUSKY AVENUE - 70'

S. R. No. 47

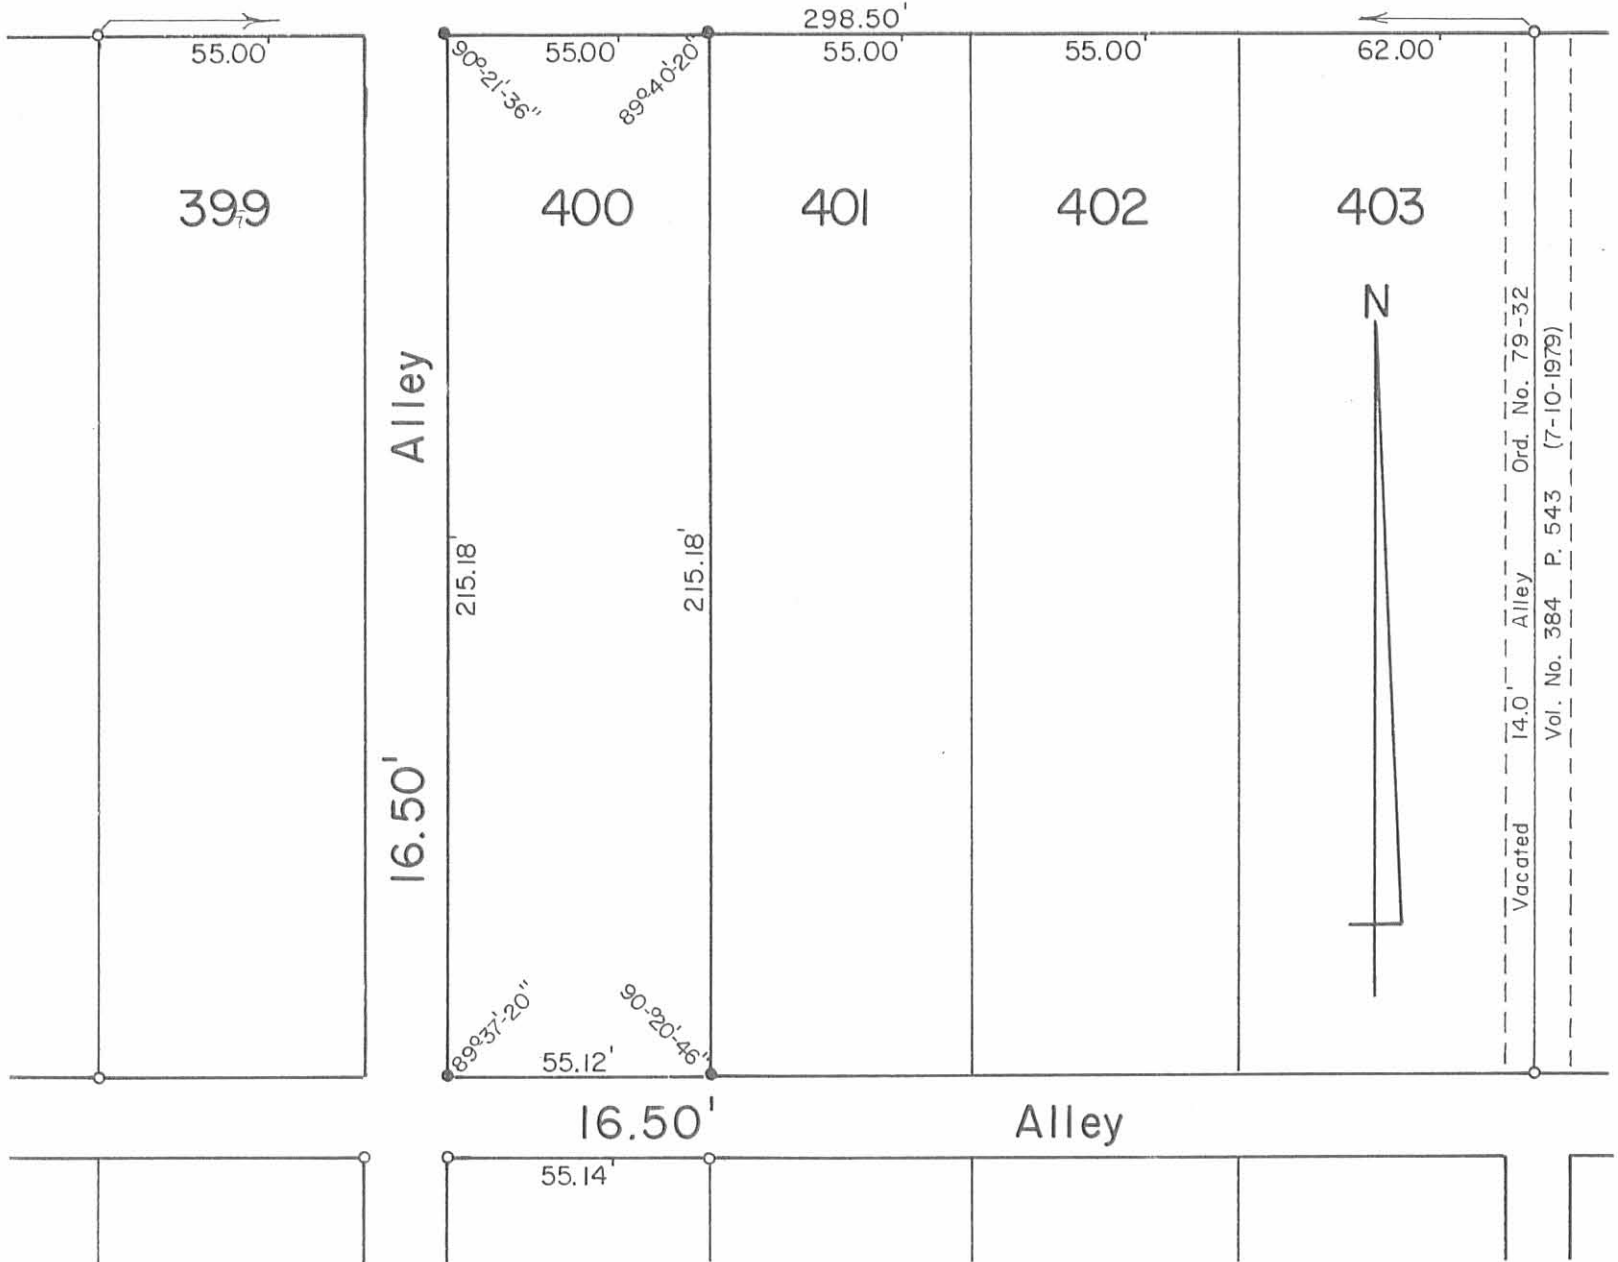

SYMBOLS:

- - 5/8" Rebars Fd.
- - 5/8" x 30" Rebars Set.



Survey of Lot No. 400
 City of Bellefontaine
 Lake Township
 Logan County, Ohio
 April 8, 1994

Daniel E. Gilbert

DANIEL E. GILBERT, P.S.
 REG. SUR. NO. 5402
 400 N. PARK ST.
 BELLEFONTAINE, OHIO 43311
 TELEPHONE: 1 (513) 593-1428



Scale: 1"=40'

INDEXED ON MAP
 7611 1P

094-017

SANDUSKY ST. (70')



WEST 111' (40')

SURVEY OF LOT 398 AND HALF
 OF VACATED 10' ALLEY IN THE
 CITY OF BELLEFONTAINE, OHIO
 MARCH, 1987
 SCALE: 1" = 40'
 Lake Twp

LEGEND:
 ○ = CAP & NAIL SET
 ○ = 5/8" IRON BAR SET

COLUMBUS ST.

INDEXED ON MAP
 7611 28



Leslie H. Geeslin
 LESLIE H. GEESLIN
 RUSHSVLVANIA, OHIO