


REC'D 4-3-96 SML

SCALE
30

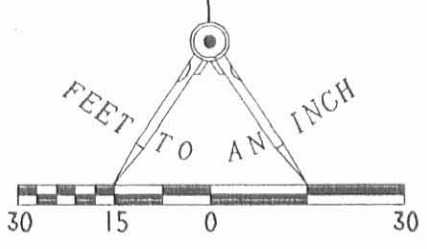

EASTWOOD ALLOTMENT

N 75° 46' 19" E
22.73'

LOT 4497
0.433 ACRE

ASHBROOK ADDITION I

N 14° 56' 17" E
169.93'

DEBORAH MARTIN
0.333 ACRE
O.R. 277, PG. 851

S 21° 24' 59" E
176.60'

LEGEND

- 5/8" IRON ROD FOUND
- 1/2" IRON ROD FOUND
- 5/8" IRON ROD SET W/ PLASTIC I.D. CAP STAMPED " LEE PS6359"

CURVE "A"

RADIUS	DELTA	ARC	TANGENT	CHORD	CHORD BEARING
50.00'	53° 06' 10"	46.34	24.99	44.70	S 42° 09' 37" W

N 74° 31' 49" W
104.09'

LOT 4495
0.261 ACRE

CURVE "A"

S 21° 24' 59" E
50.00'

N 74° 28' 11" W
50.09'

POINT OF BEGINNING

N 04° 58' 00" E

WEDGEWOOD COURT

RETRACEMENT SURVEY OF
 LOT NUMBER 4496, ASHBROOK ADDITION II
 DEBORAH MARTIN
 OFFICIAL RECORD 277, PAGE 851
 VIRGINIA MILITARY SURVEY 4399
 CITY OF BELLEFONTAINE
 LAKE TOWNSHIP,
 LOGAN COUNTY, OHIO

INDEXED ON MAP
7746 IP



SURVEYED BY

 JEFFREY I. LEE
 PROFESSIONAL SURVEYOR 6359
 MARCH 22, 1996

COPYRIGHT 1996 BY:
 LEE SURVEYING & MAPPING CO., INC.
 143 East Columbus Avenue
 BELLEFONTAINE, OHIO 43311
 (513) 593-7335

ORIGINAL STAMP IN GREEN

2 WORKING DAYS
BEFORE YOU DIG
 CALL TOLL FREE **800-362-2764**
 OHIO UTILITIES PROTECTION SERVICE.