


Survey for C.F. Otter

May 2, 27.
Scott
Crane

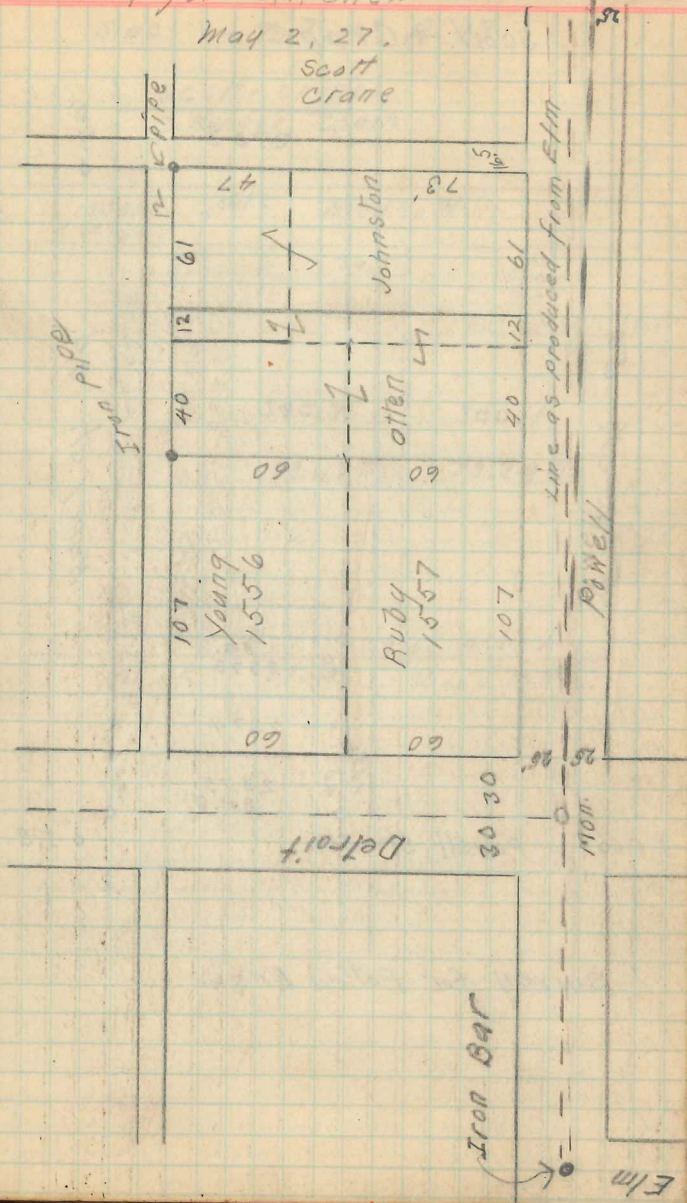

51798

SGENERAL OFF