

BICKHAM SURVEY
POWERS ST.

55.00	267.65
8.25	63.25
<u>63.25</u>	<u>204.40</u>


238.99
<u>204.40</u>
34.59

238.99
<u>34.67</u>
204.32

Dodson
Circ

May 29, 1964

13

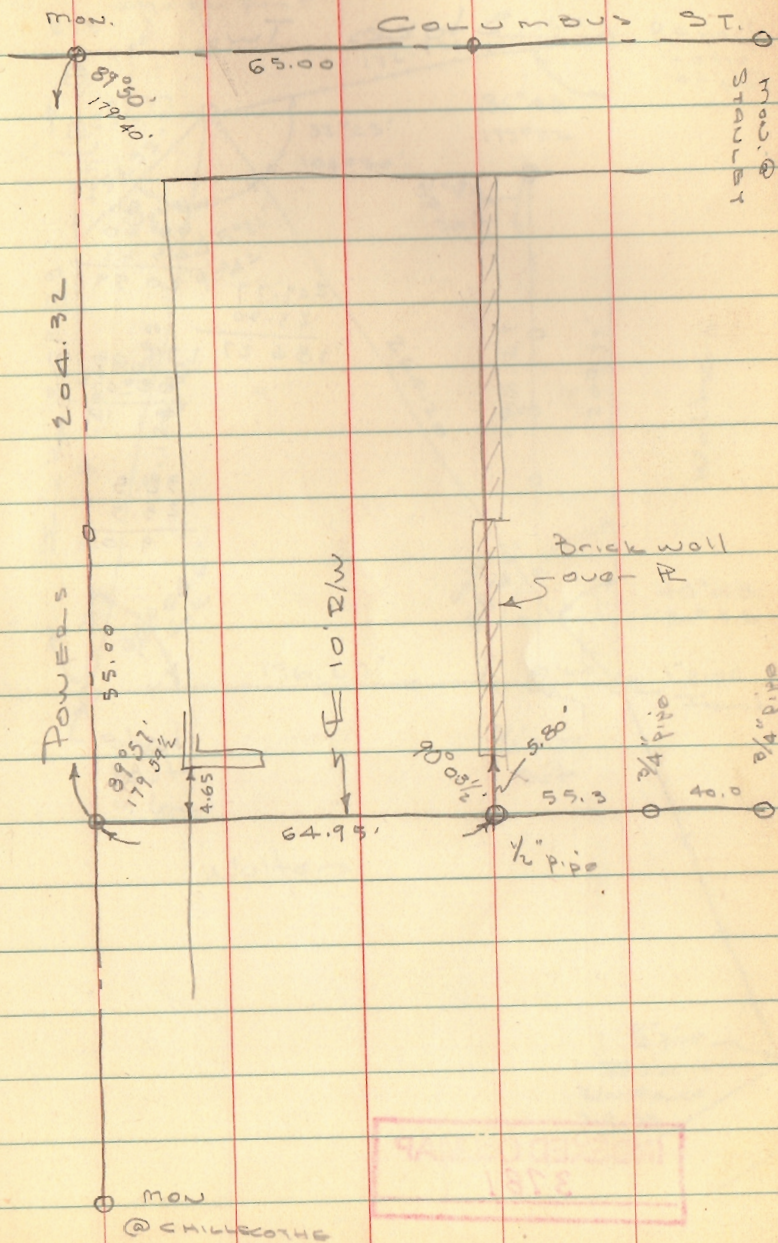

INDEXED ON MAP

9614

INDEXED ON MAP
1558