

R. 8 T. 7

R. 8 T. 7

Ed. Knief.

M. B. Griffin.

Sec. 20

Sec 21

Hall survey  
931 IP  
Bloomfield TP

Geo. Metz.

W. H. Longbrake.


Jessie Dalrymple.

Wm Dalrymple.

Sec 29

Sec. 28

Emma V. Hall.

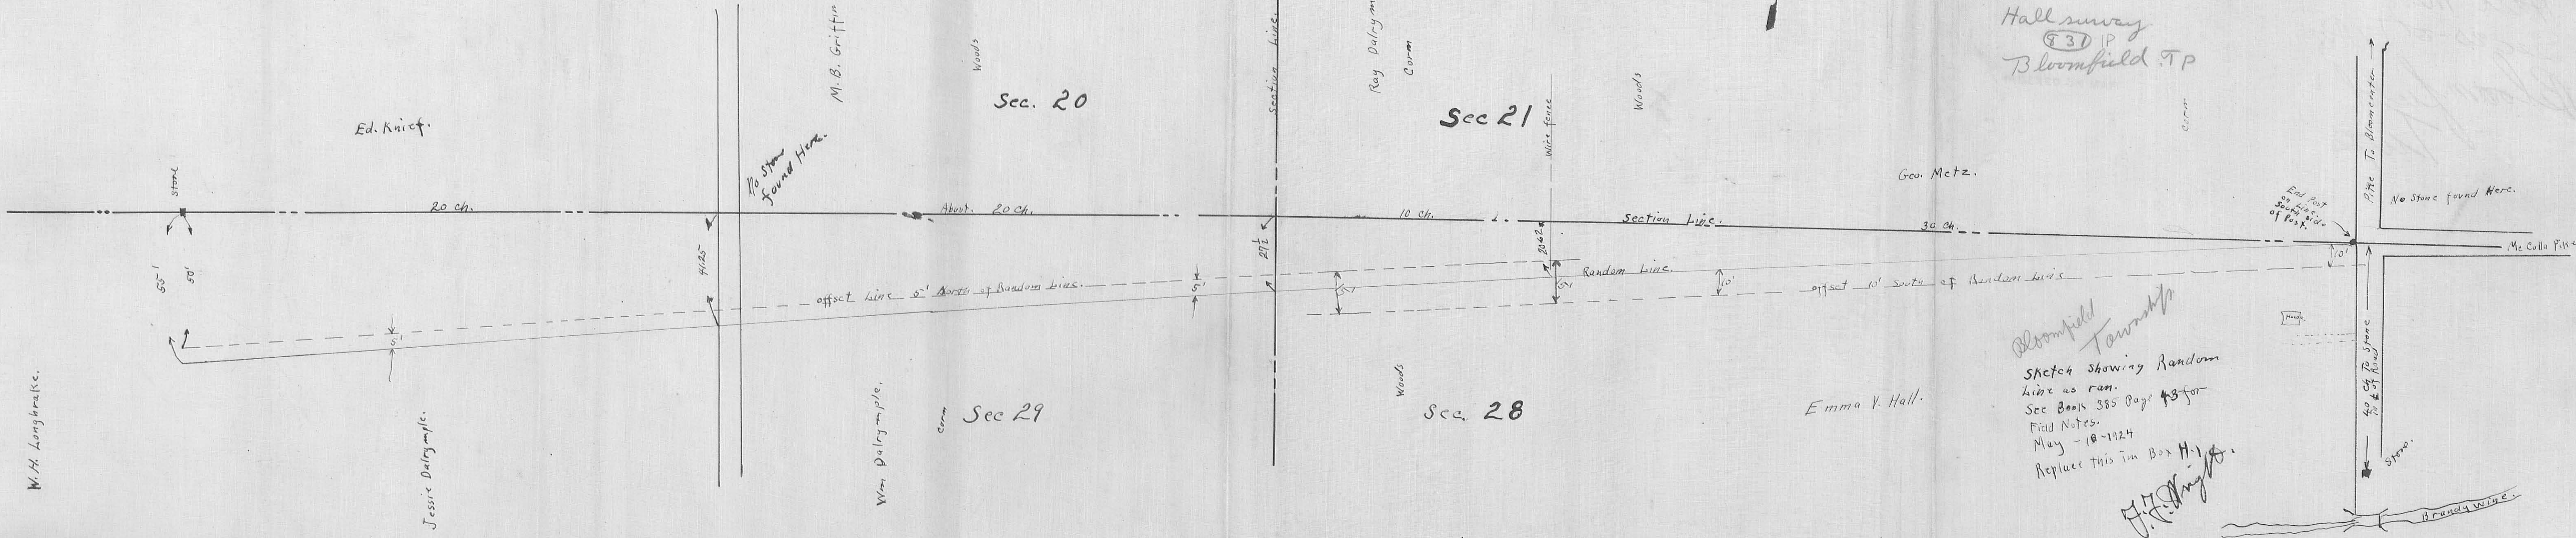

Bloomfield Township  
 Sketch showing Random  
 line as ran.  
 See Book 385 Page 13 for  
 Field Notes.  
 May - 18-1924  
 Replace this in Box H-1.

*J. F. Wright*

End post  
on line  
south side  
of post.

No Stone found Here.

Mc Colla Pike

40 ch To Stone  
Pike of Road

stone

Brandy wine.