


LINE SURVEY

876. By F. J. Sager

184

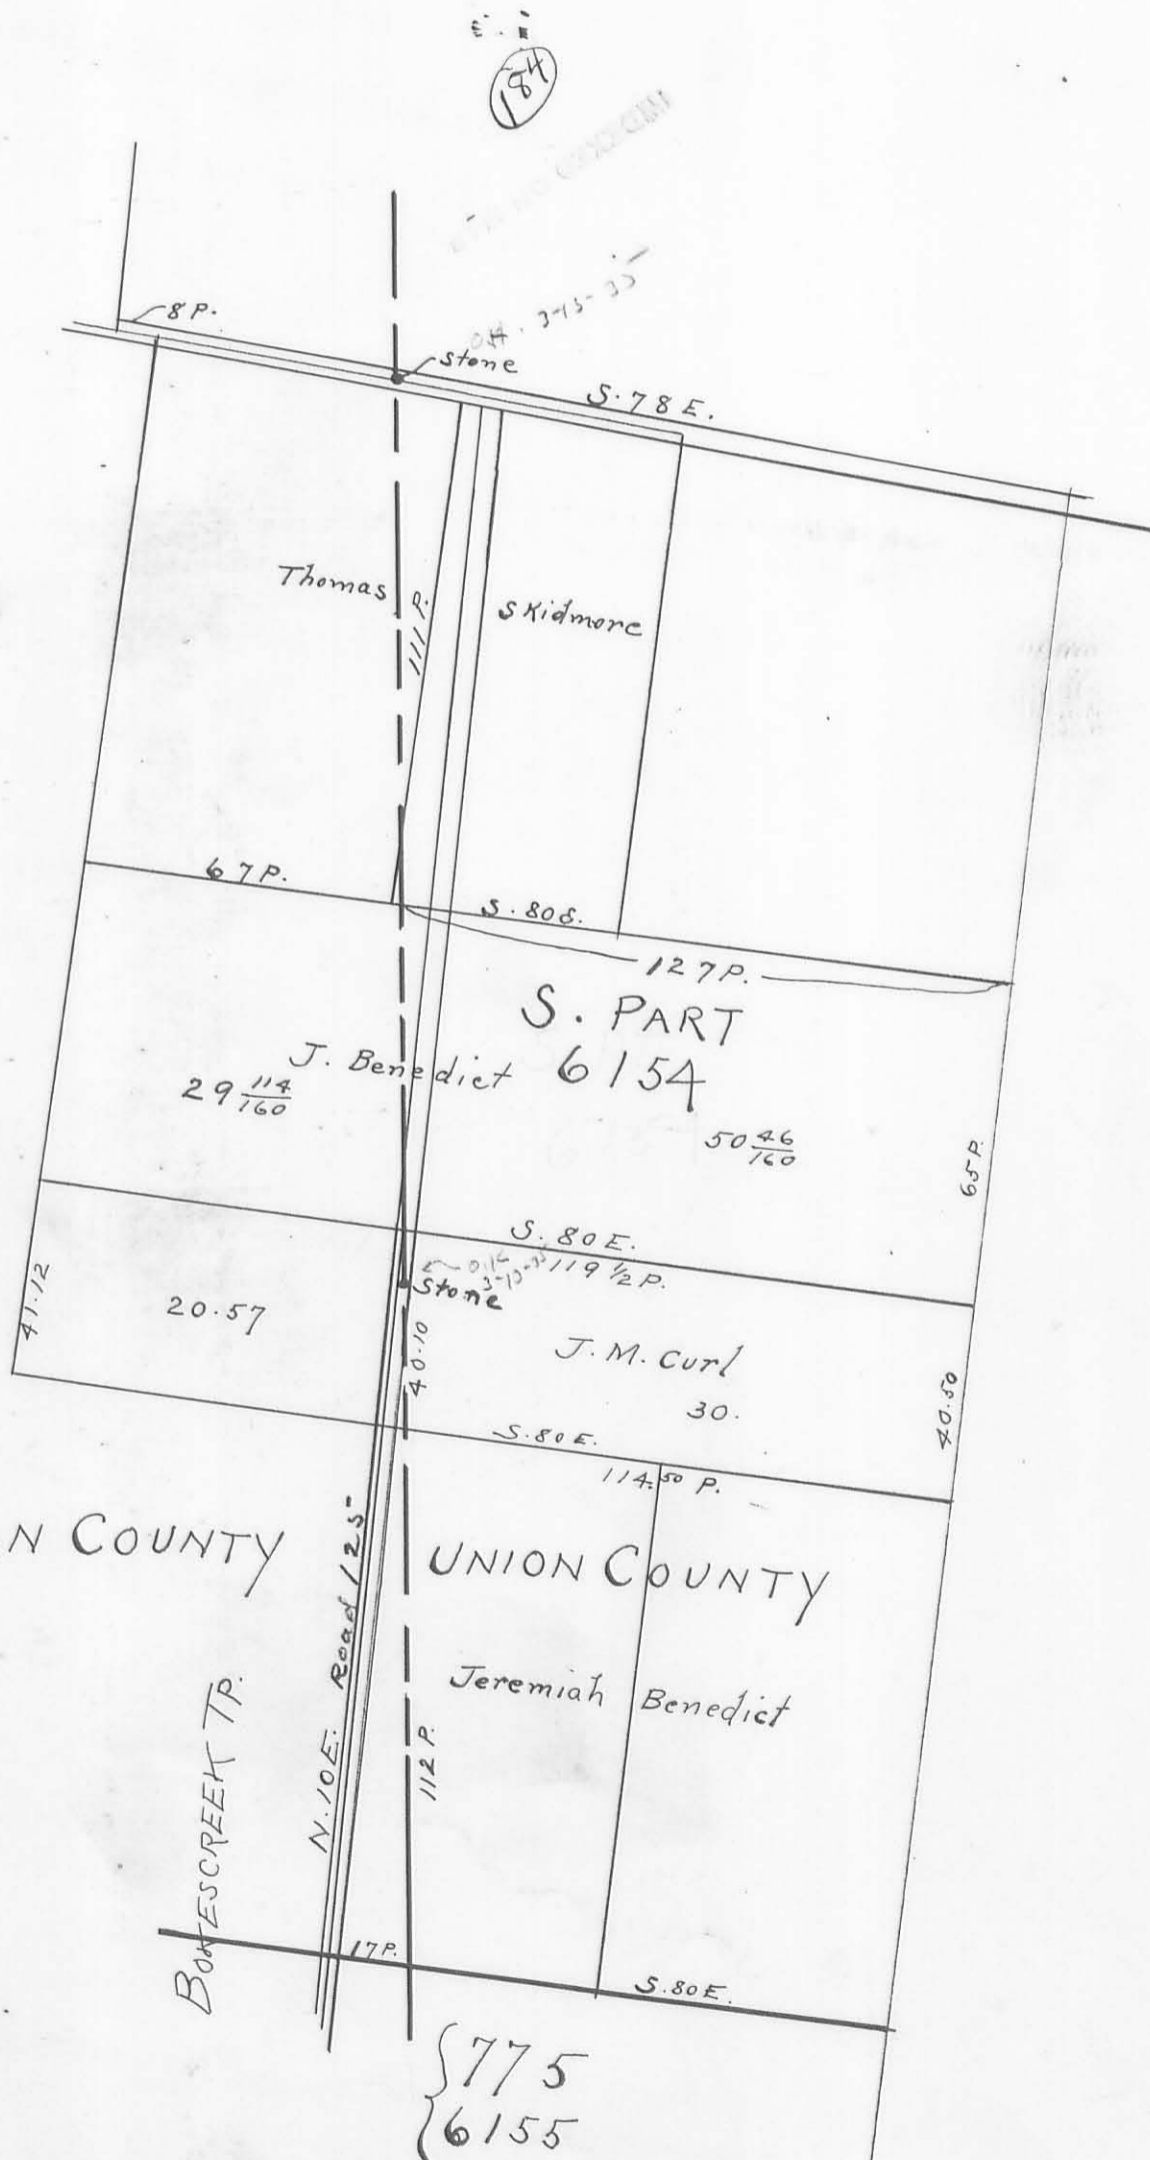

LOGAN COUNTY

UNION COUNTY

{ 775
{ 6155